





9
1895

30th March
1895
WINCHESTER


Central Dundas Main Shaft

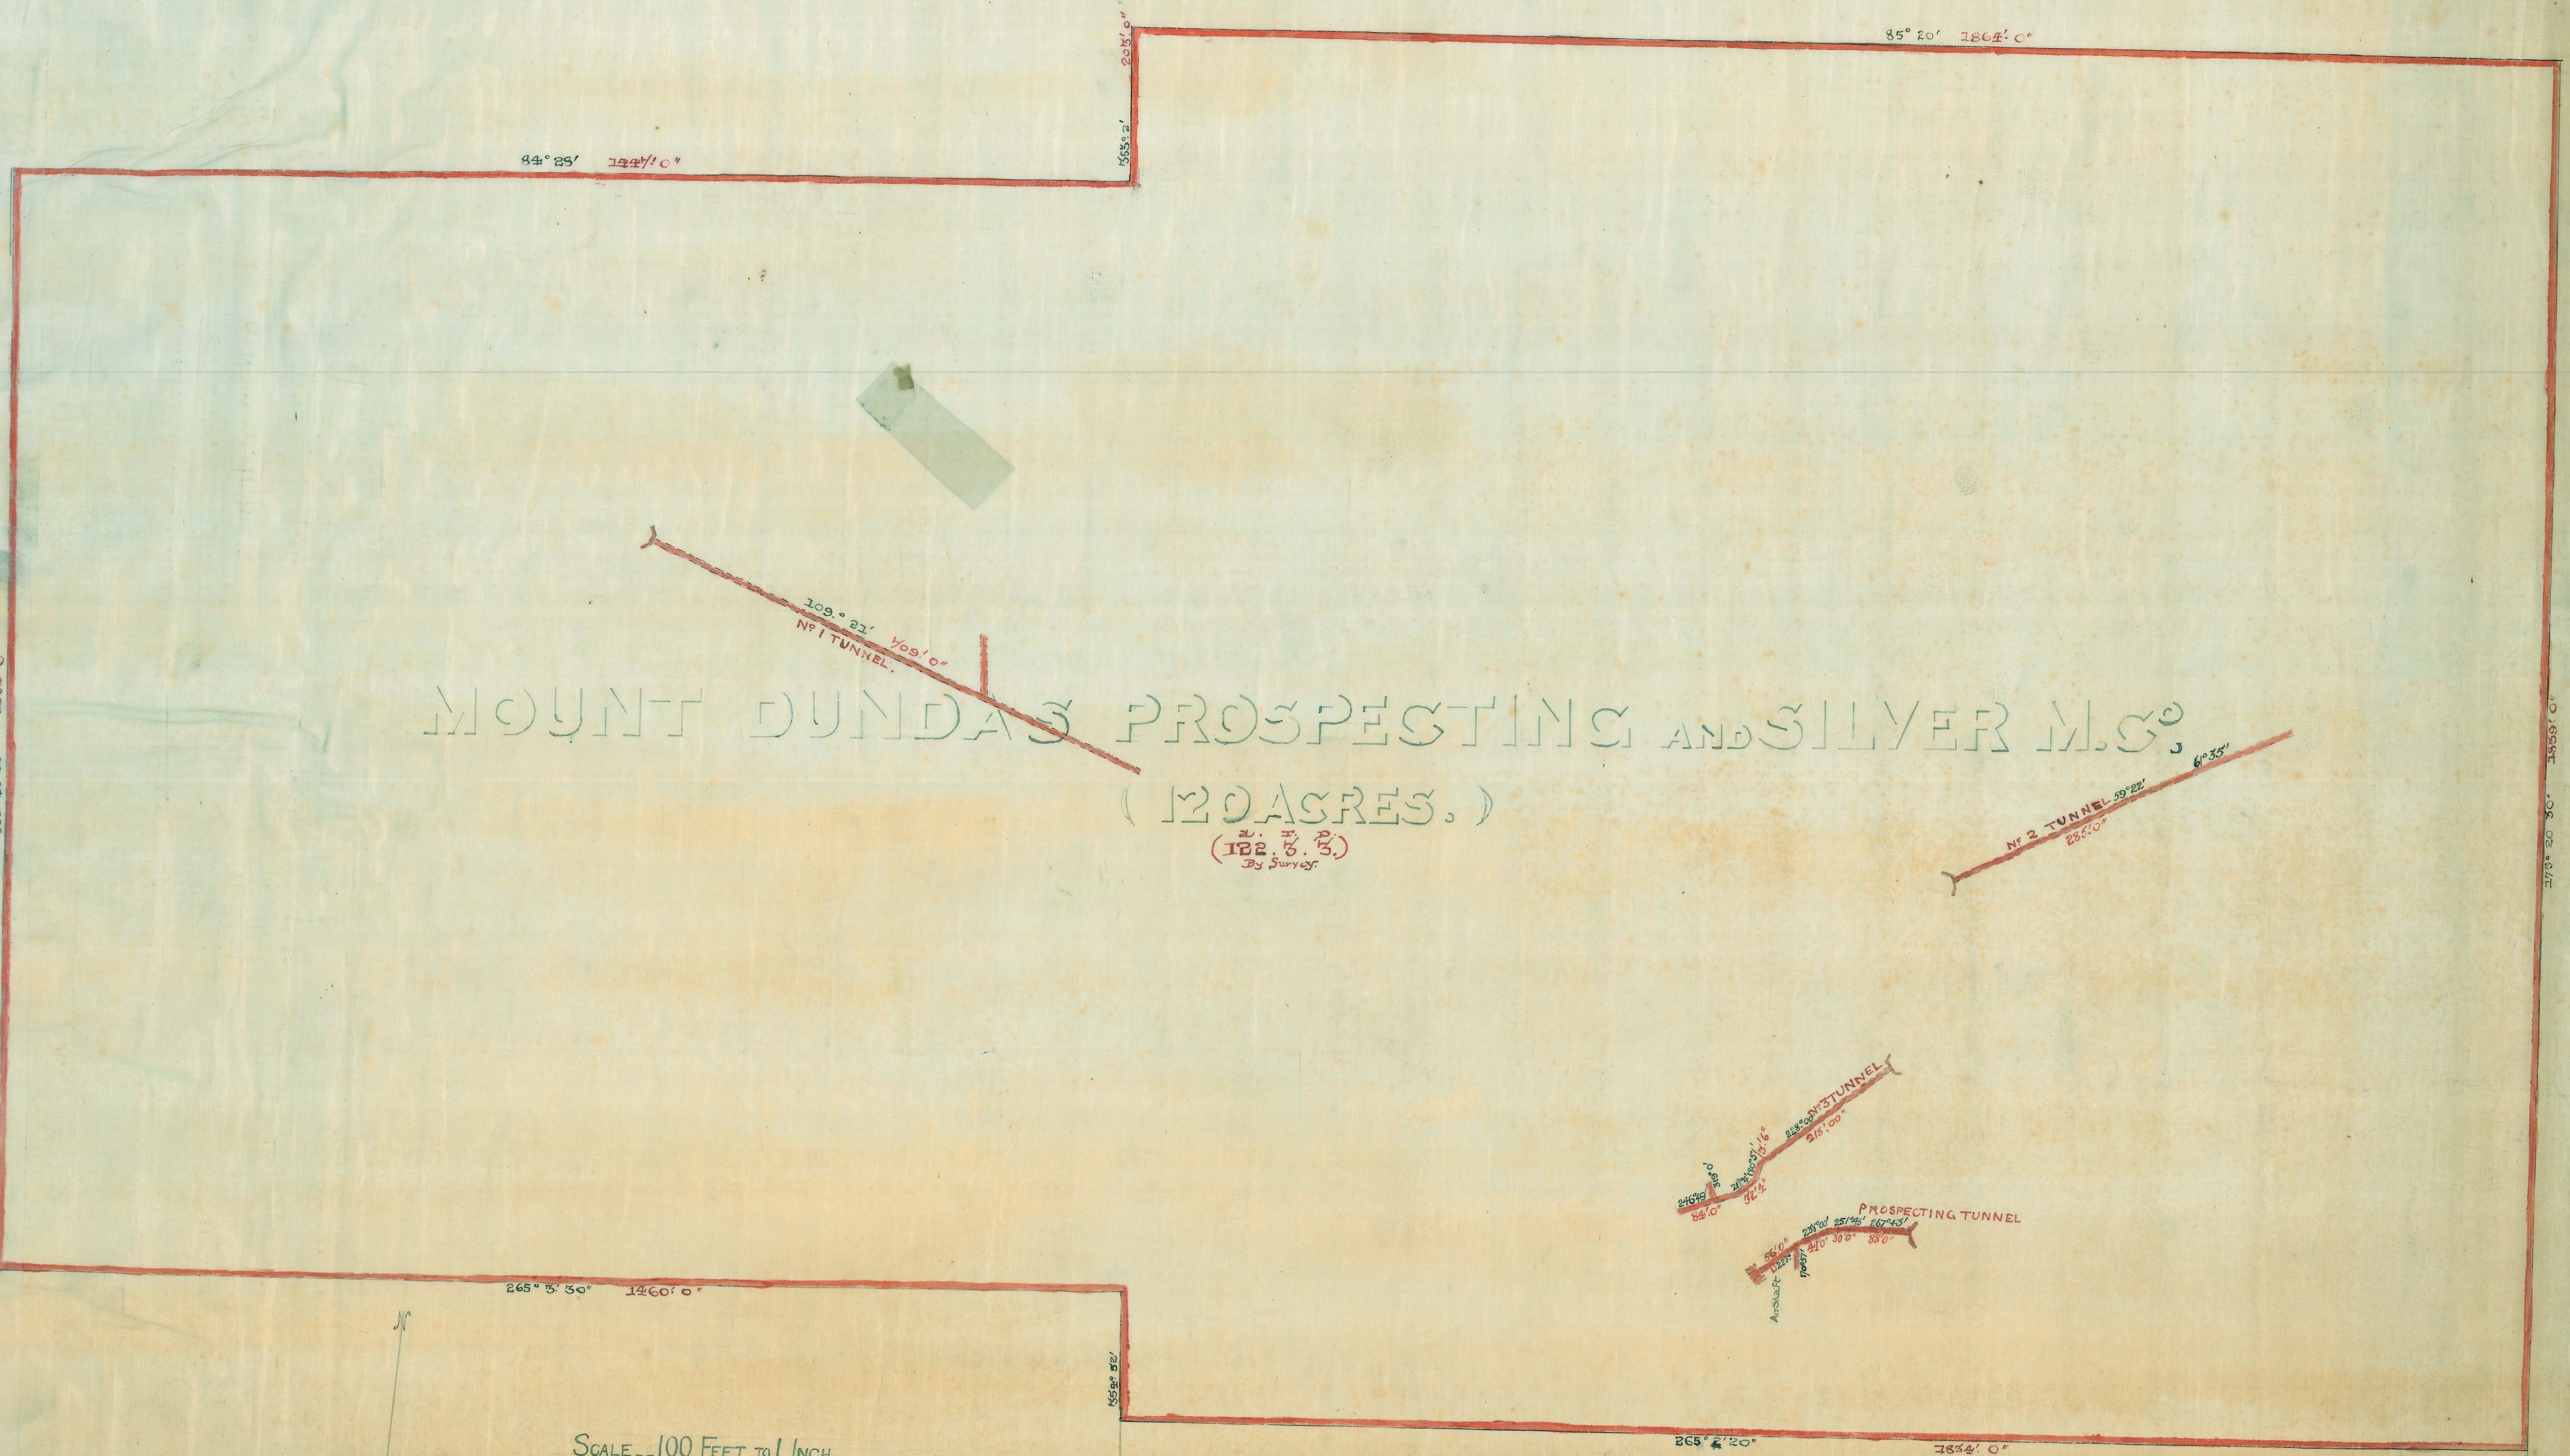

MOUNT DUNDAS PROSPECTING AND SILVER M.C.
(120 ACRES.)
(182.3.3)
By Surveyor

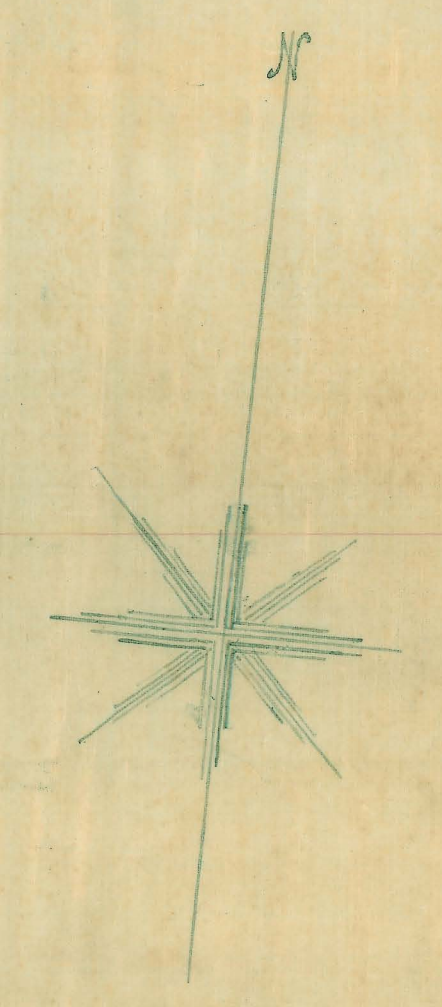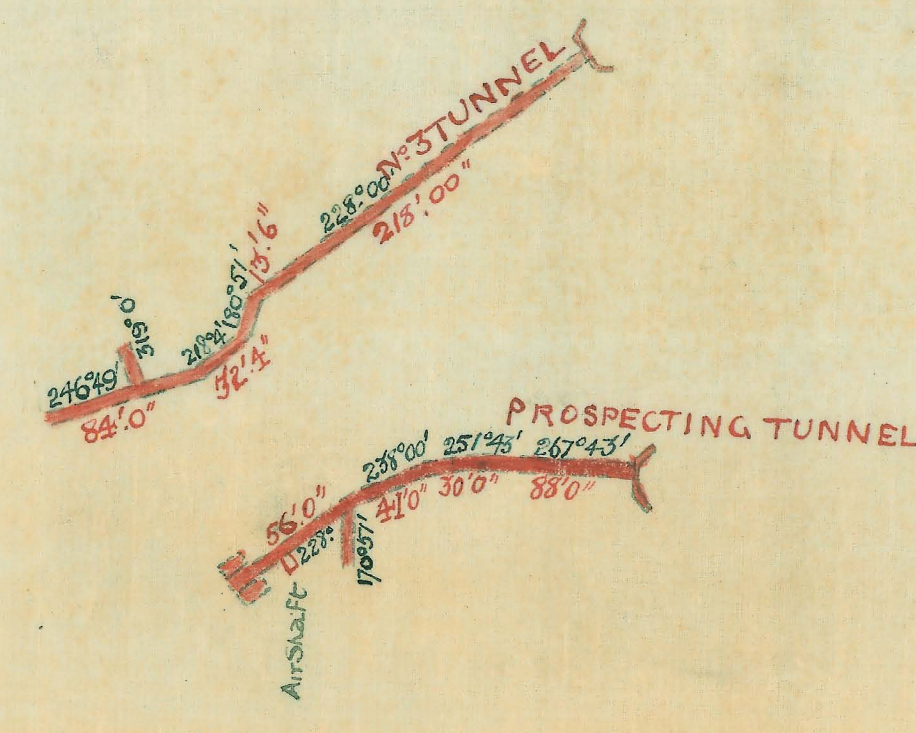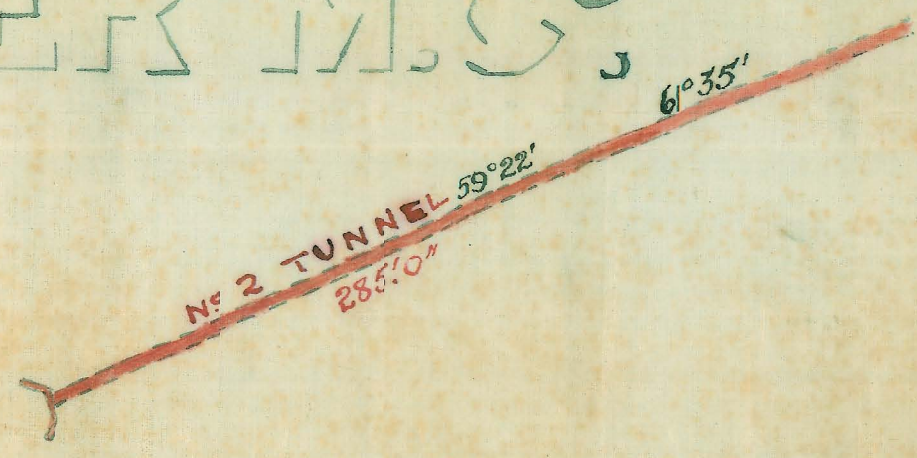

SCALE...100 FEET TO 1 INCH

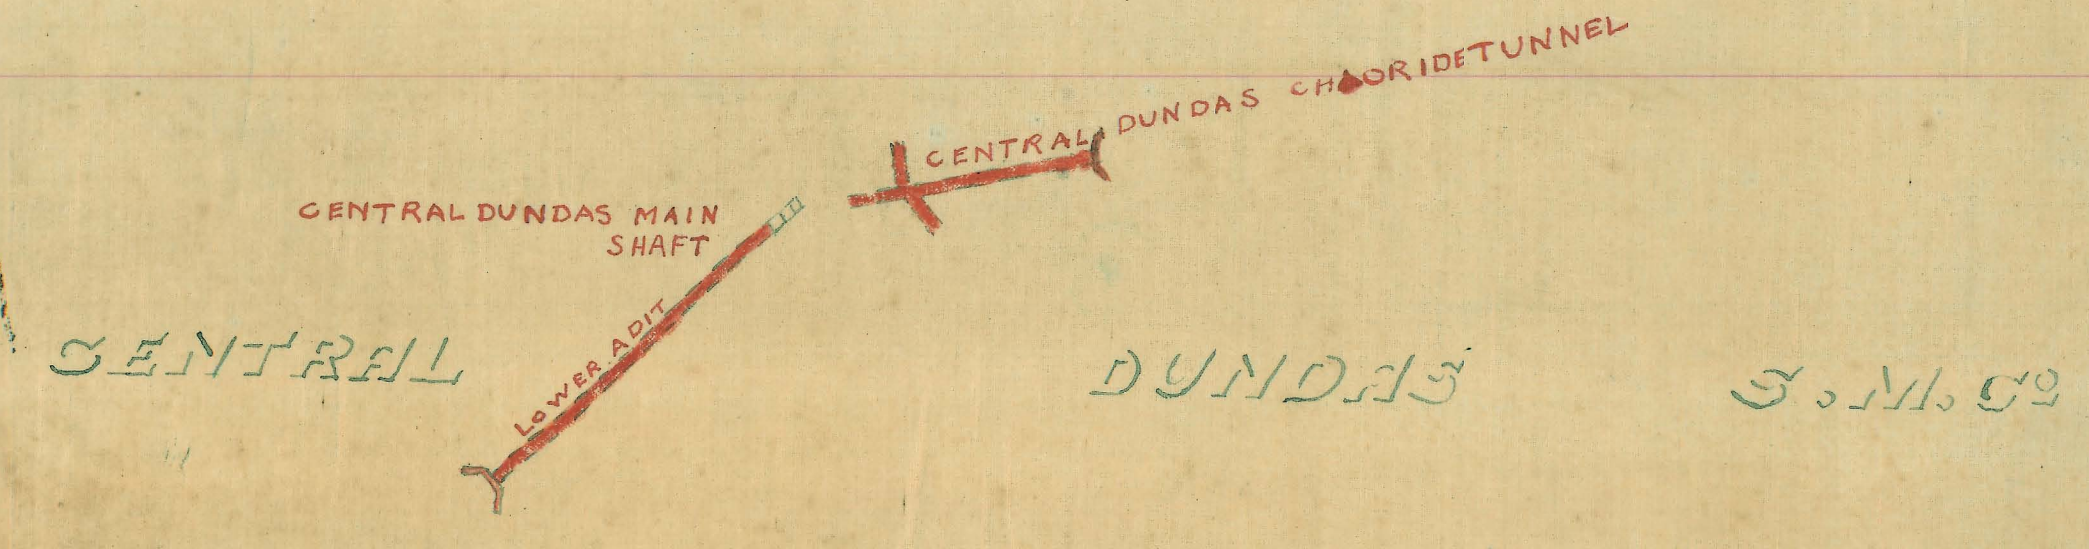

Surveyed by J.B. Tolson.
Licensed Surveyor
12 March 1892.