



WEST

7.3.13 683


SCALE 25

MAP N°
23-11.2

LONGITUDINAL PROJECTION

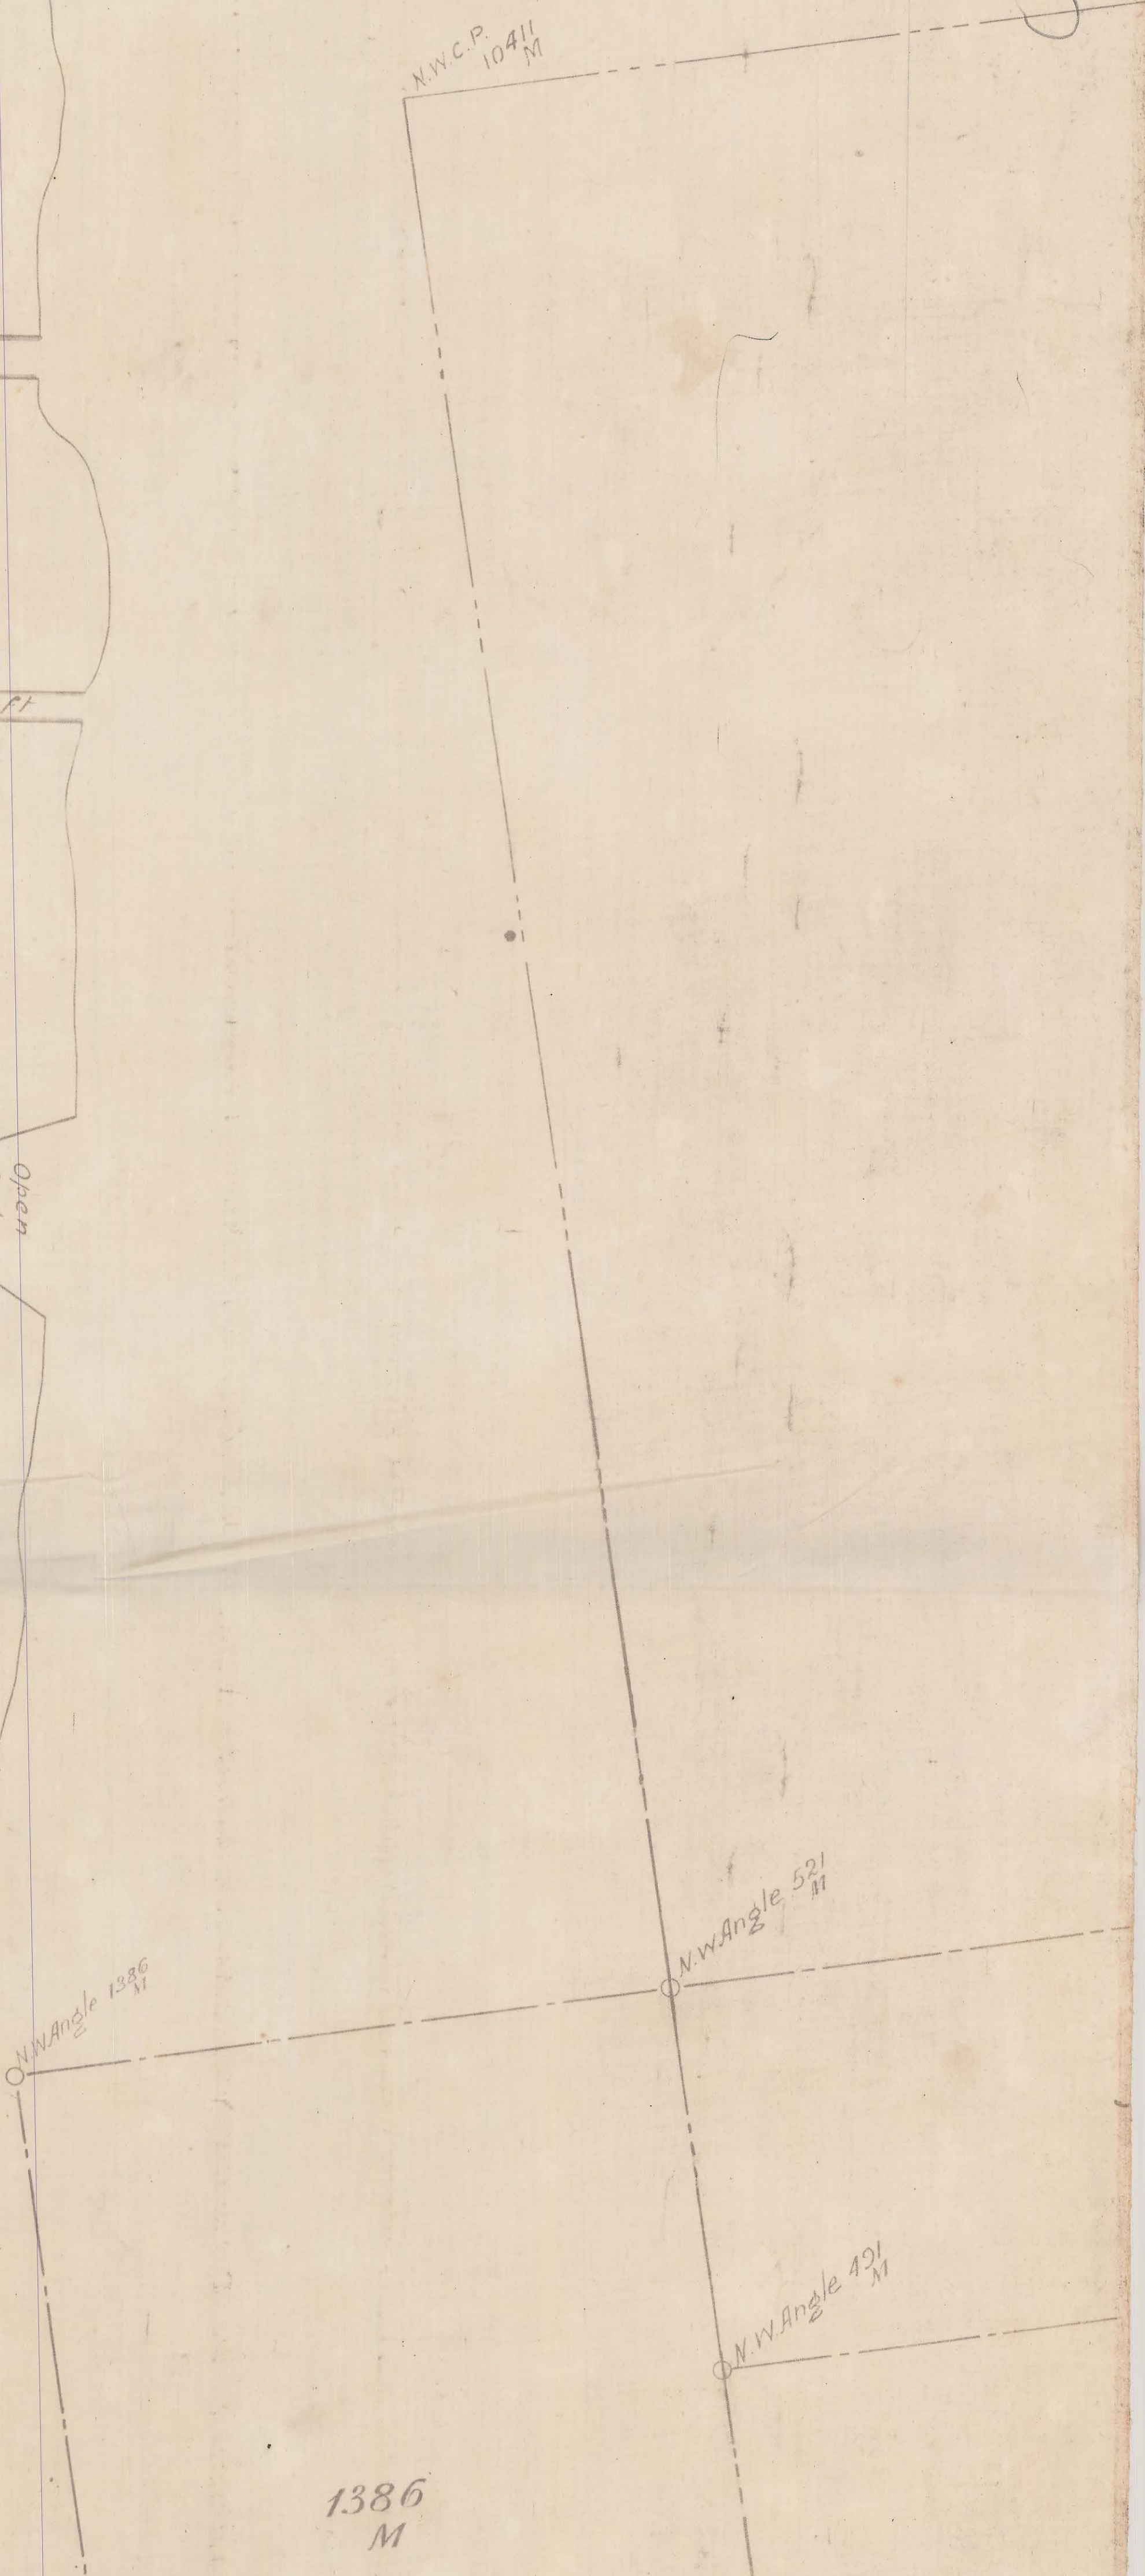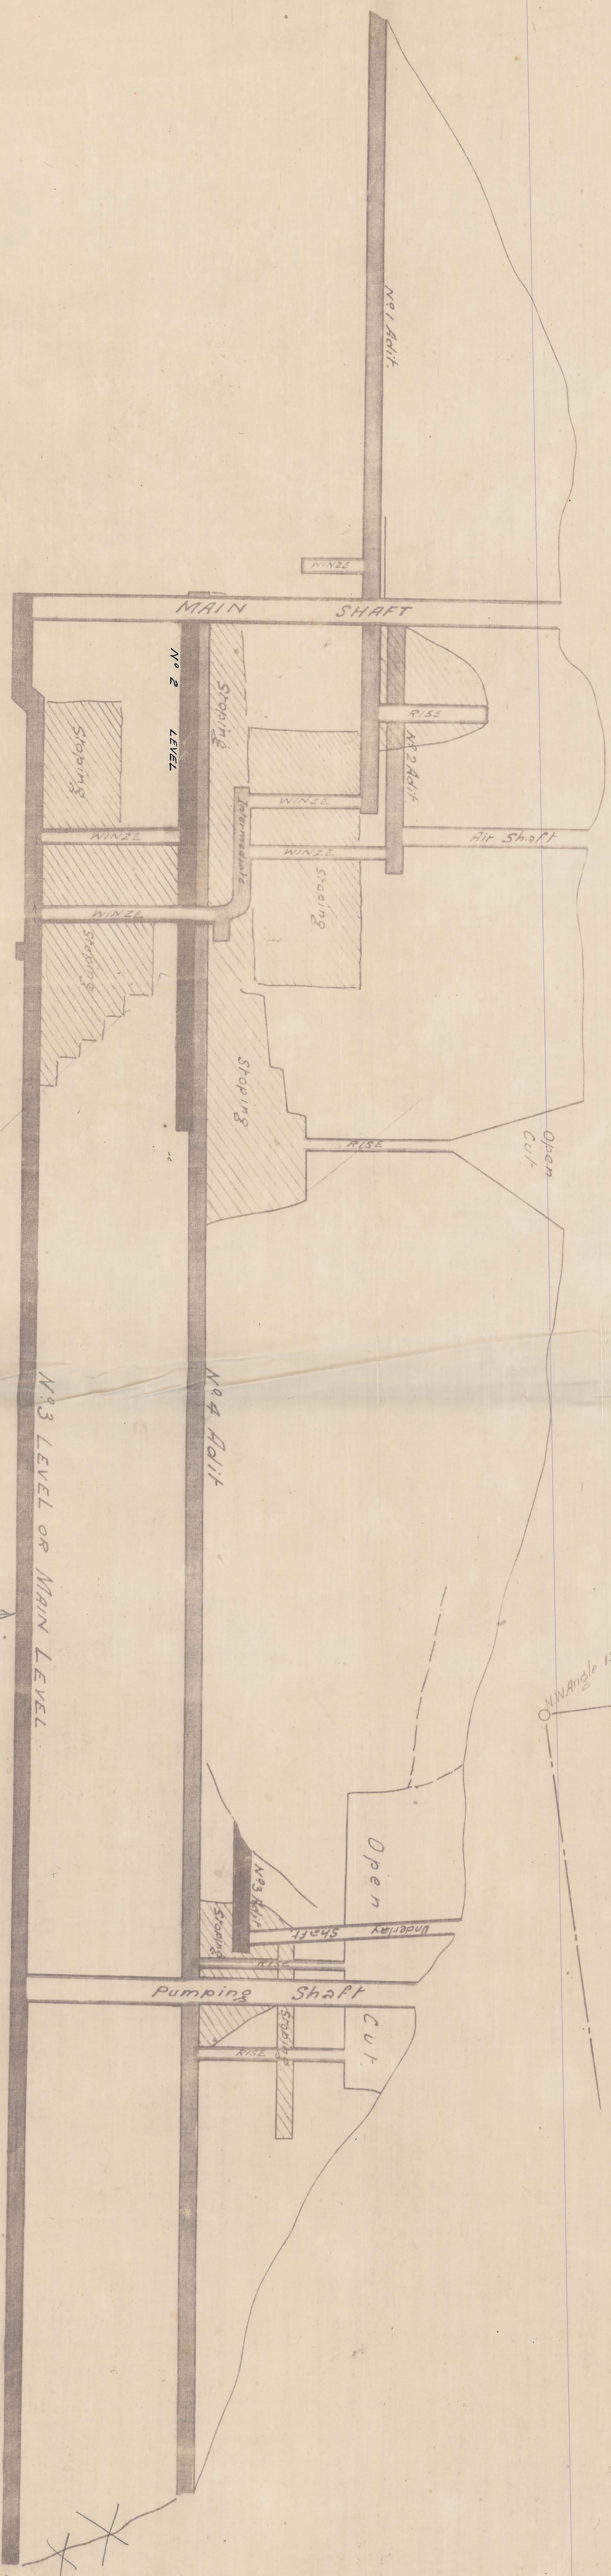

① taken as 40' when color of mine shaft

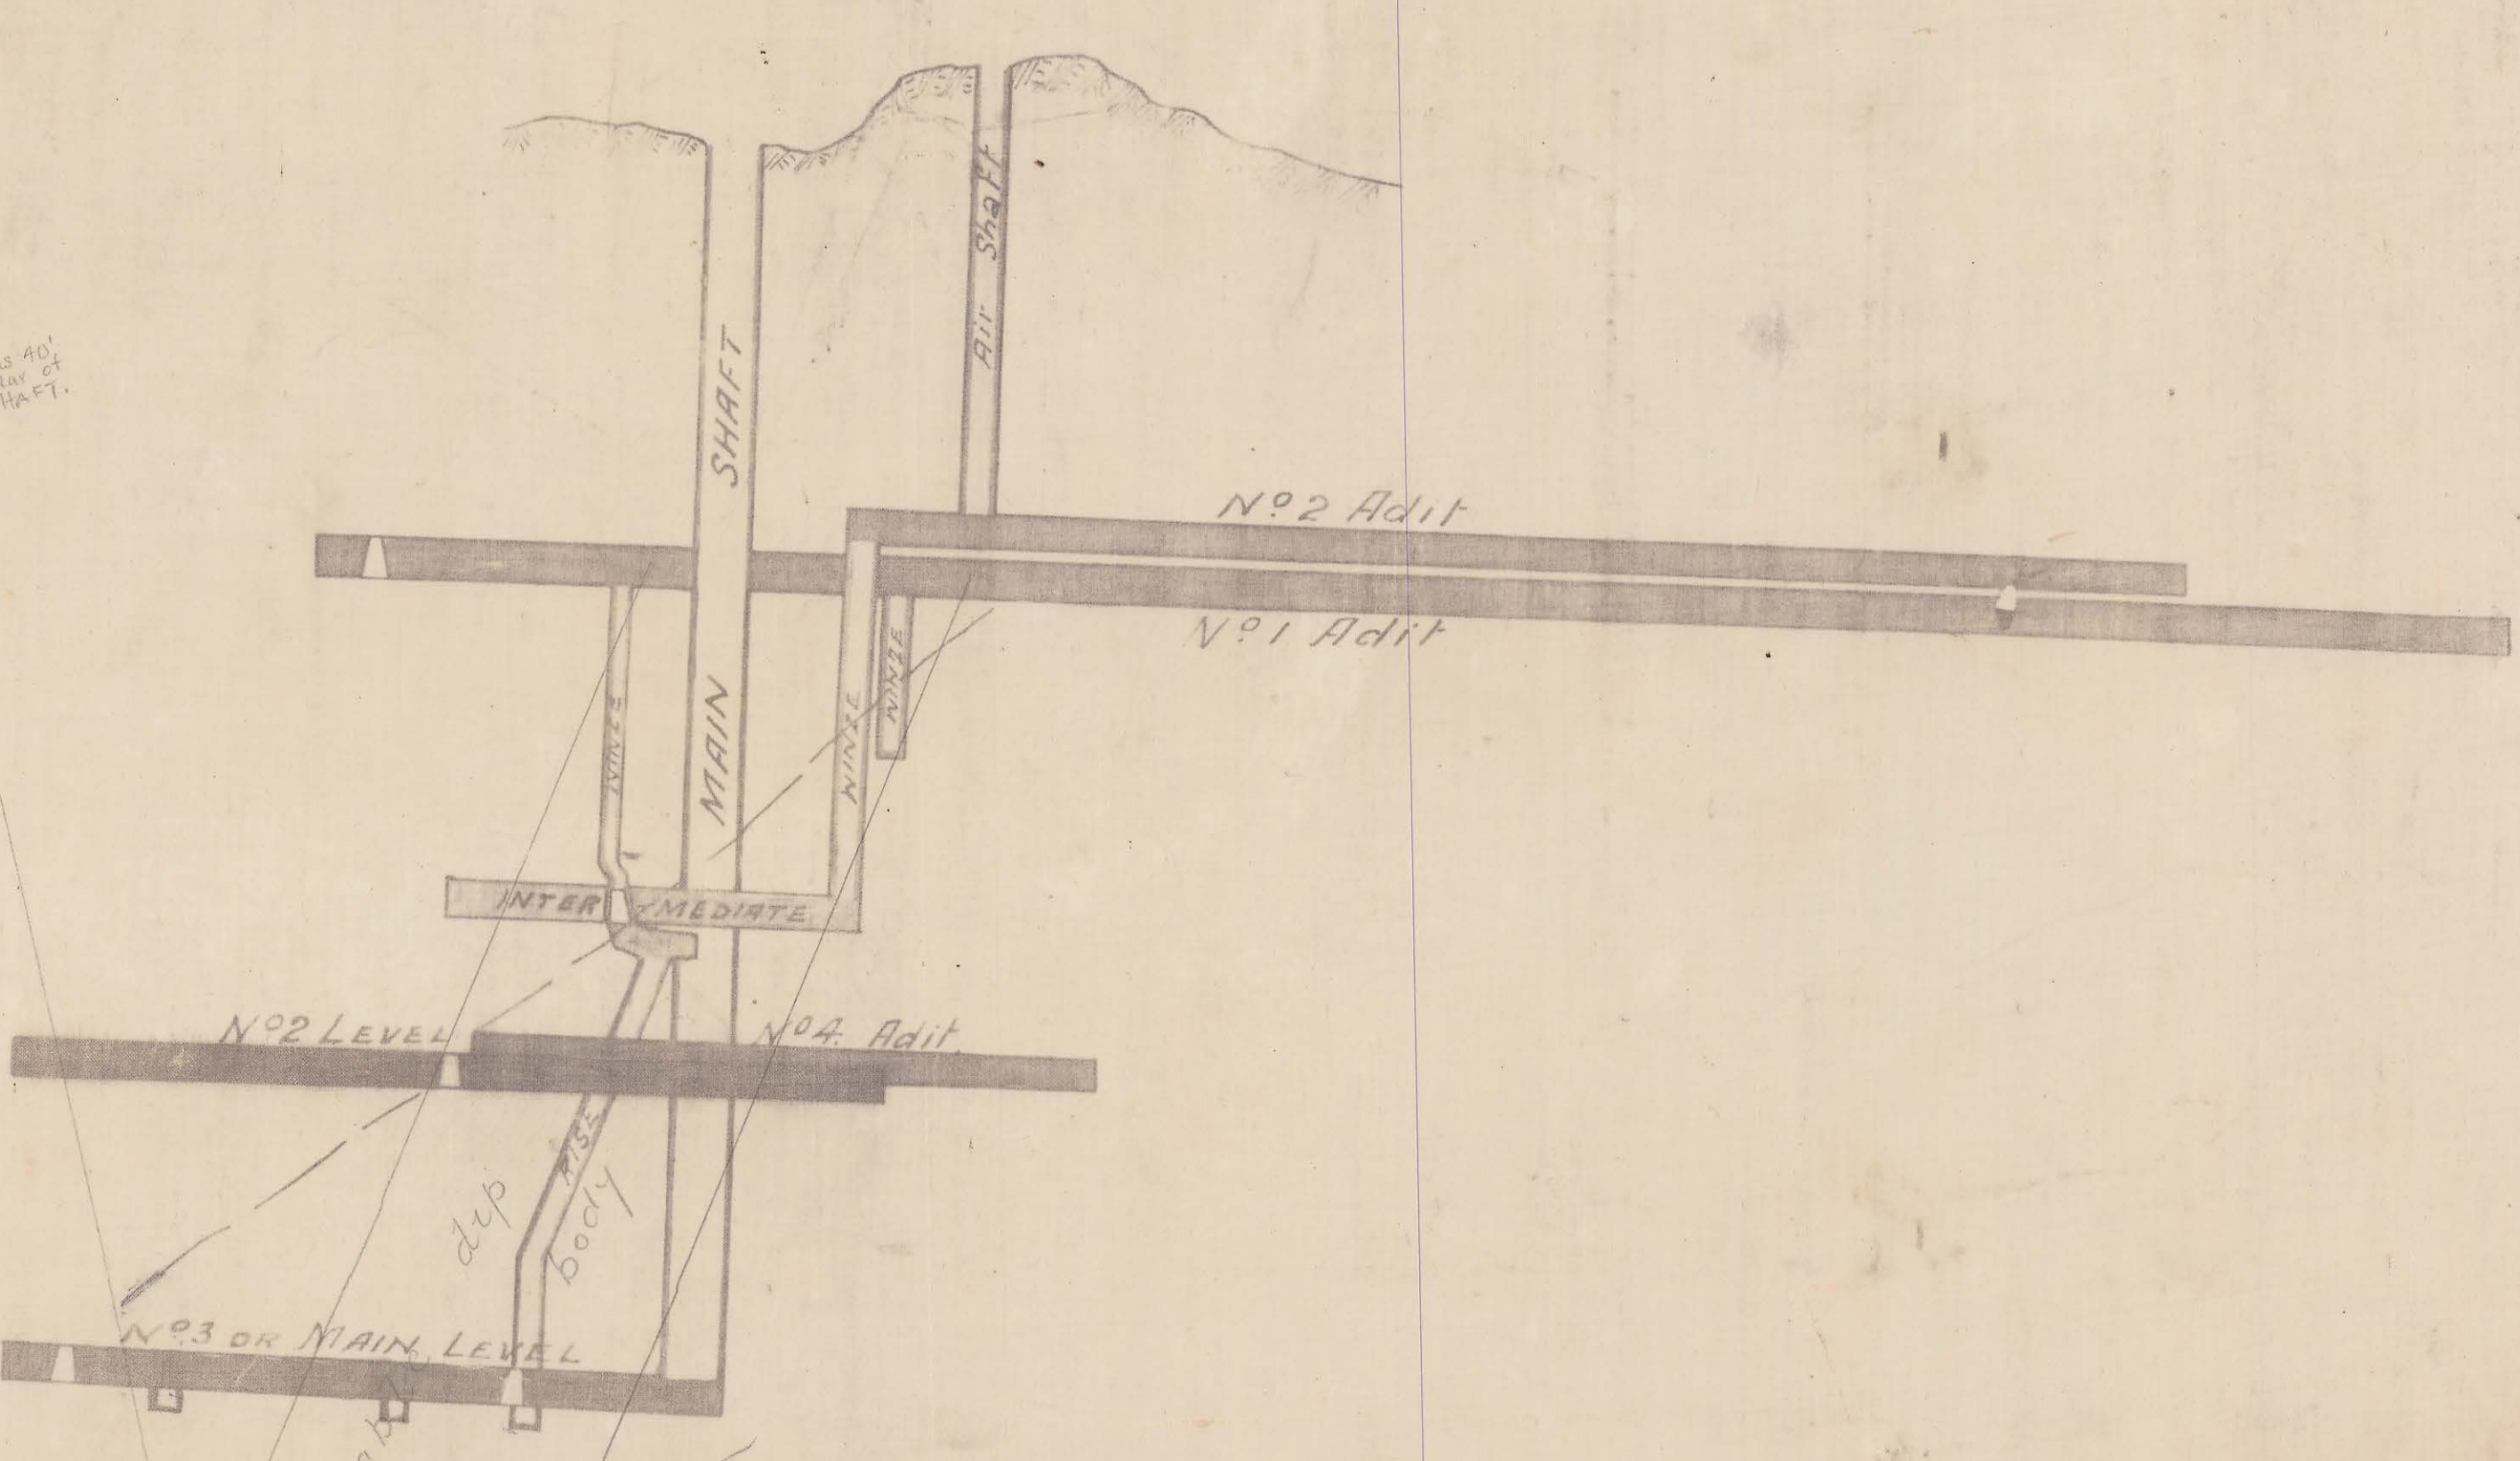

PROJECTION ON EAST-WEST LINE B.A.