
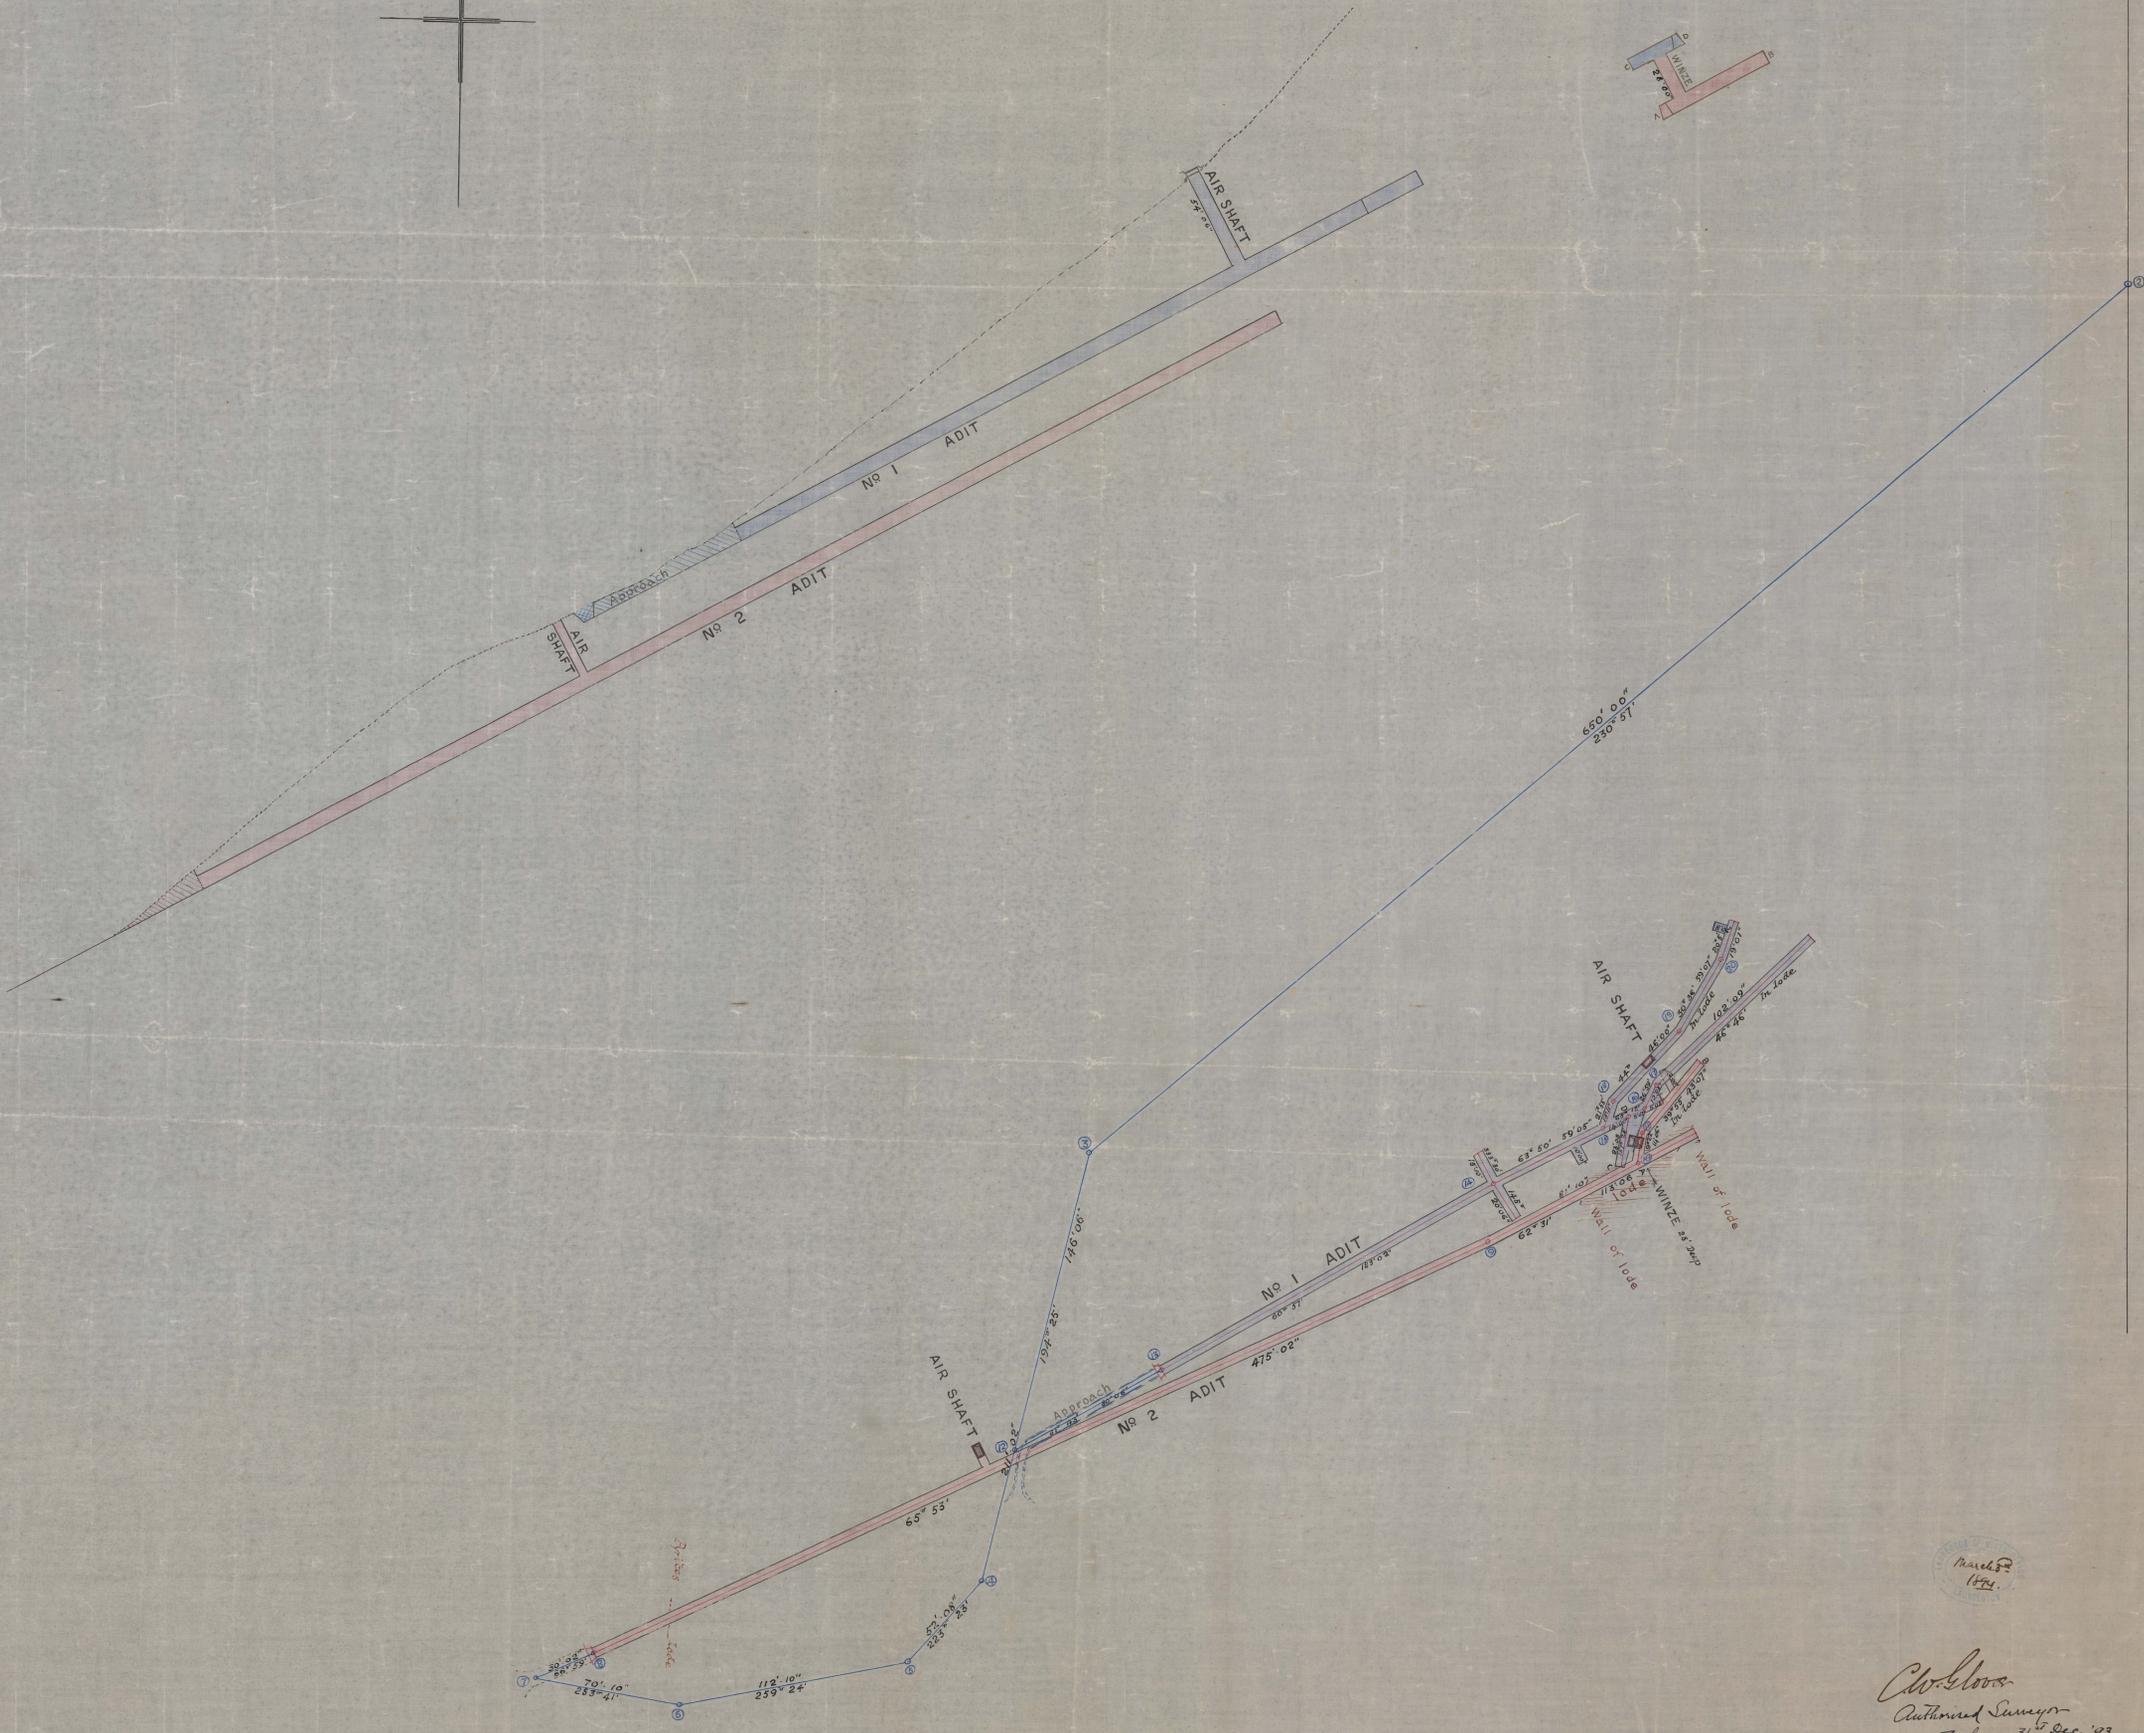


# SILVER STREAM S. M.

## MINING WORKS

Scale 30 feet to an inch

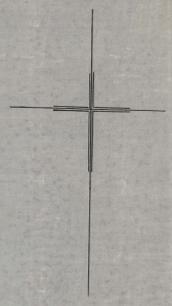

*C. W. Snow*  
 Authorized Surveyor  
 Leechan 31<sup>st</sup> Dec. '93