



186



Detailed plan of mine workings

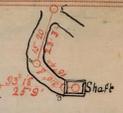

ANDERSON MINE

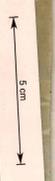

MW angle 155°

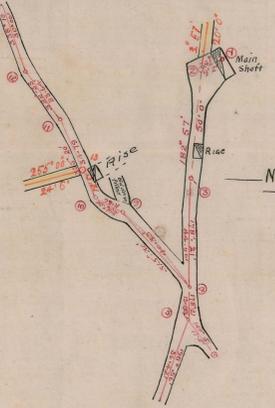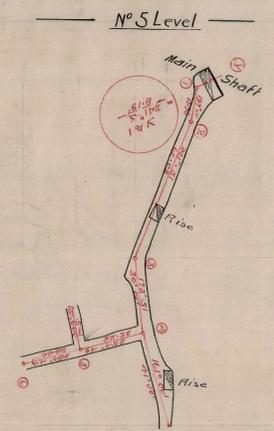

— Reference —

N°1 Level	colored thus	
N°2 Level	" "	
N°3 Level	" "	
N°4 Level	" "	
1908-9 Work - N°5 Level	" "	

Northern Territories Mines of Australia Lim

— Adelaide Mine —

— Underground Workings —

Scale 30ft to one Inch

— Sheet I —

The Goodall Mining Surveyor 1/2/10

26/2/10

Detailed plan of mine workings

70 5/8