


296-01


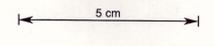


PLAN OF UNDERGROUND WORKINGS

4017 AND 4076.

NORTH DUNDAS.


Scale 40 Ft to 1 Inch.

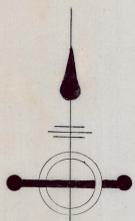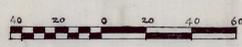


Western Boundary Section 4017
359.74'



90° 07'
444.3

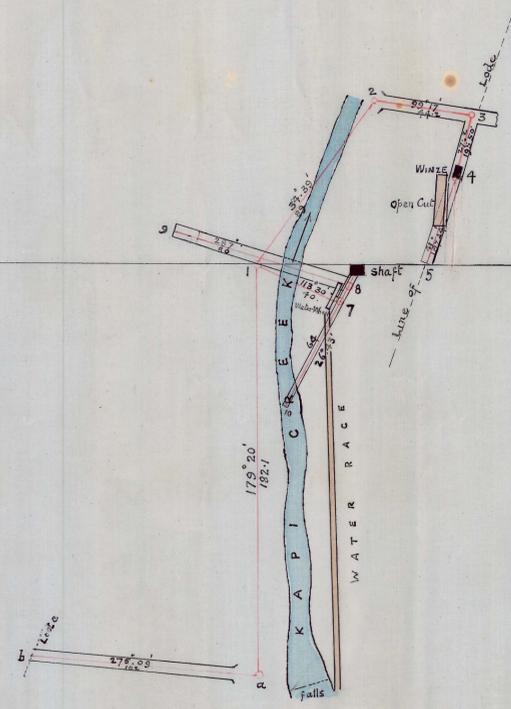

Boundary Line Between Sections.
90° 07'

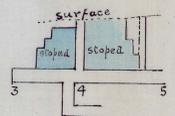

Longitudinal Section along 35.



D.V. Allen
July 29th 1911.

Handwritten notes in red ink at the top right corner.

Handwritten notes in red ink at the bottom right corner.