




PLACER PROSPECTING PTY. LIMITED	
S.P.L. 11- NORTH GRAND PRIZE	
Showing work done by PLACER (shaded)	
Note: All work done in 1965.	
Scale: 1" = 40'	D3
DRAWN BY: J.H.	
DATE: 25/5/1966	

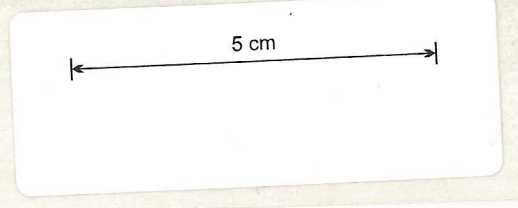

0296-002