


SOUTH HERCULES M. C. No. 1A

M^r READ

Scale 25 FT To 1 IN


TRANSVERSE SECTION ON C—D

LOOKING EAST

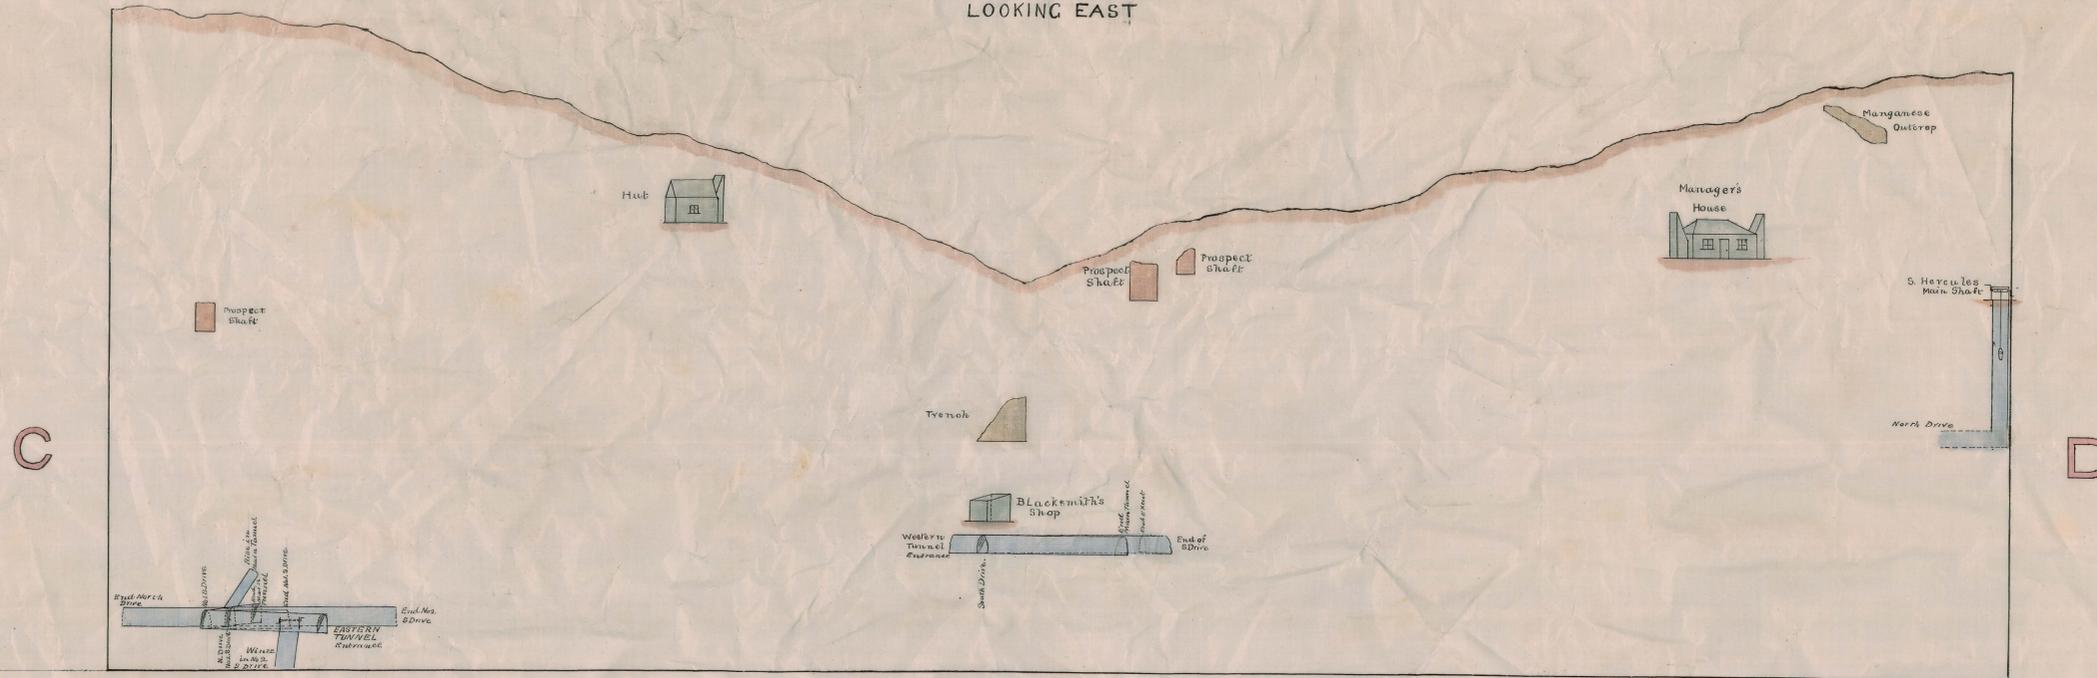

LONGITUDINAL SECTION ON A—B

LOOKING SOUTH

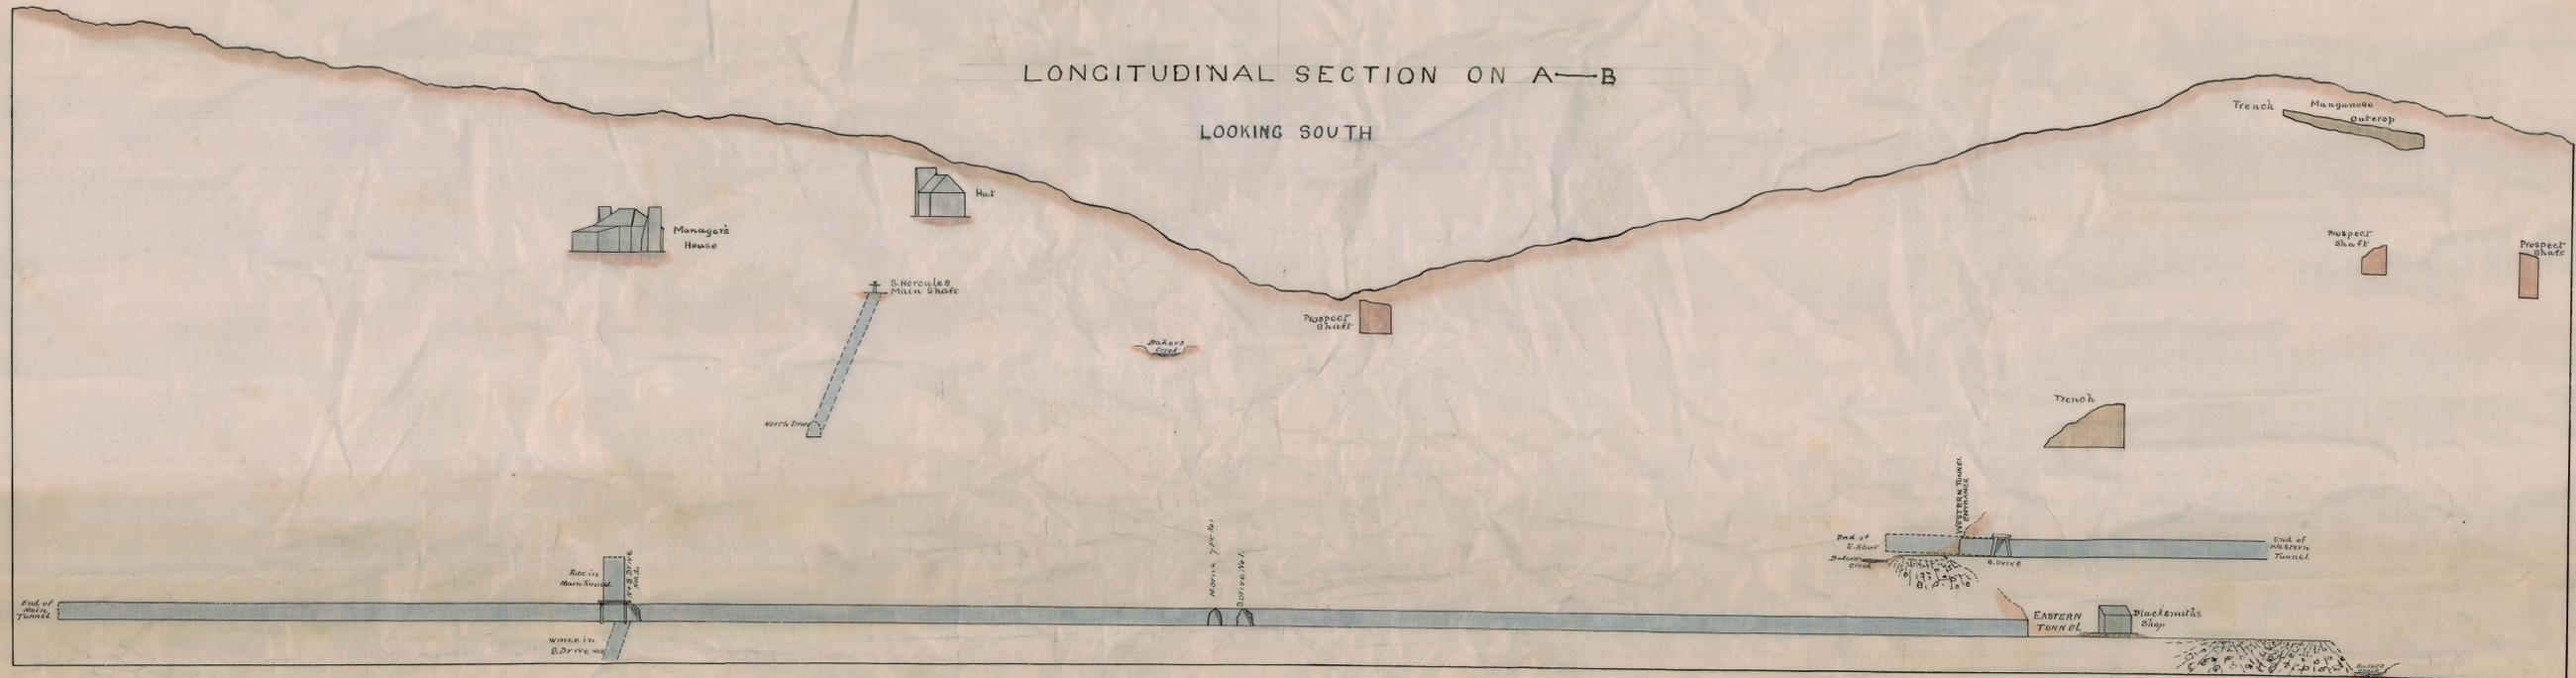

Luke Williams Cert. No. 16.
April 27th 1899

Surveyed with theodolite & Steel Tape
By Luke Williams.

300
702

5 cm

B

A