
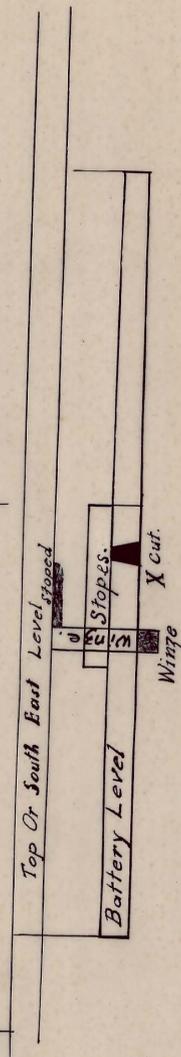


302  
-02

5 cm

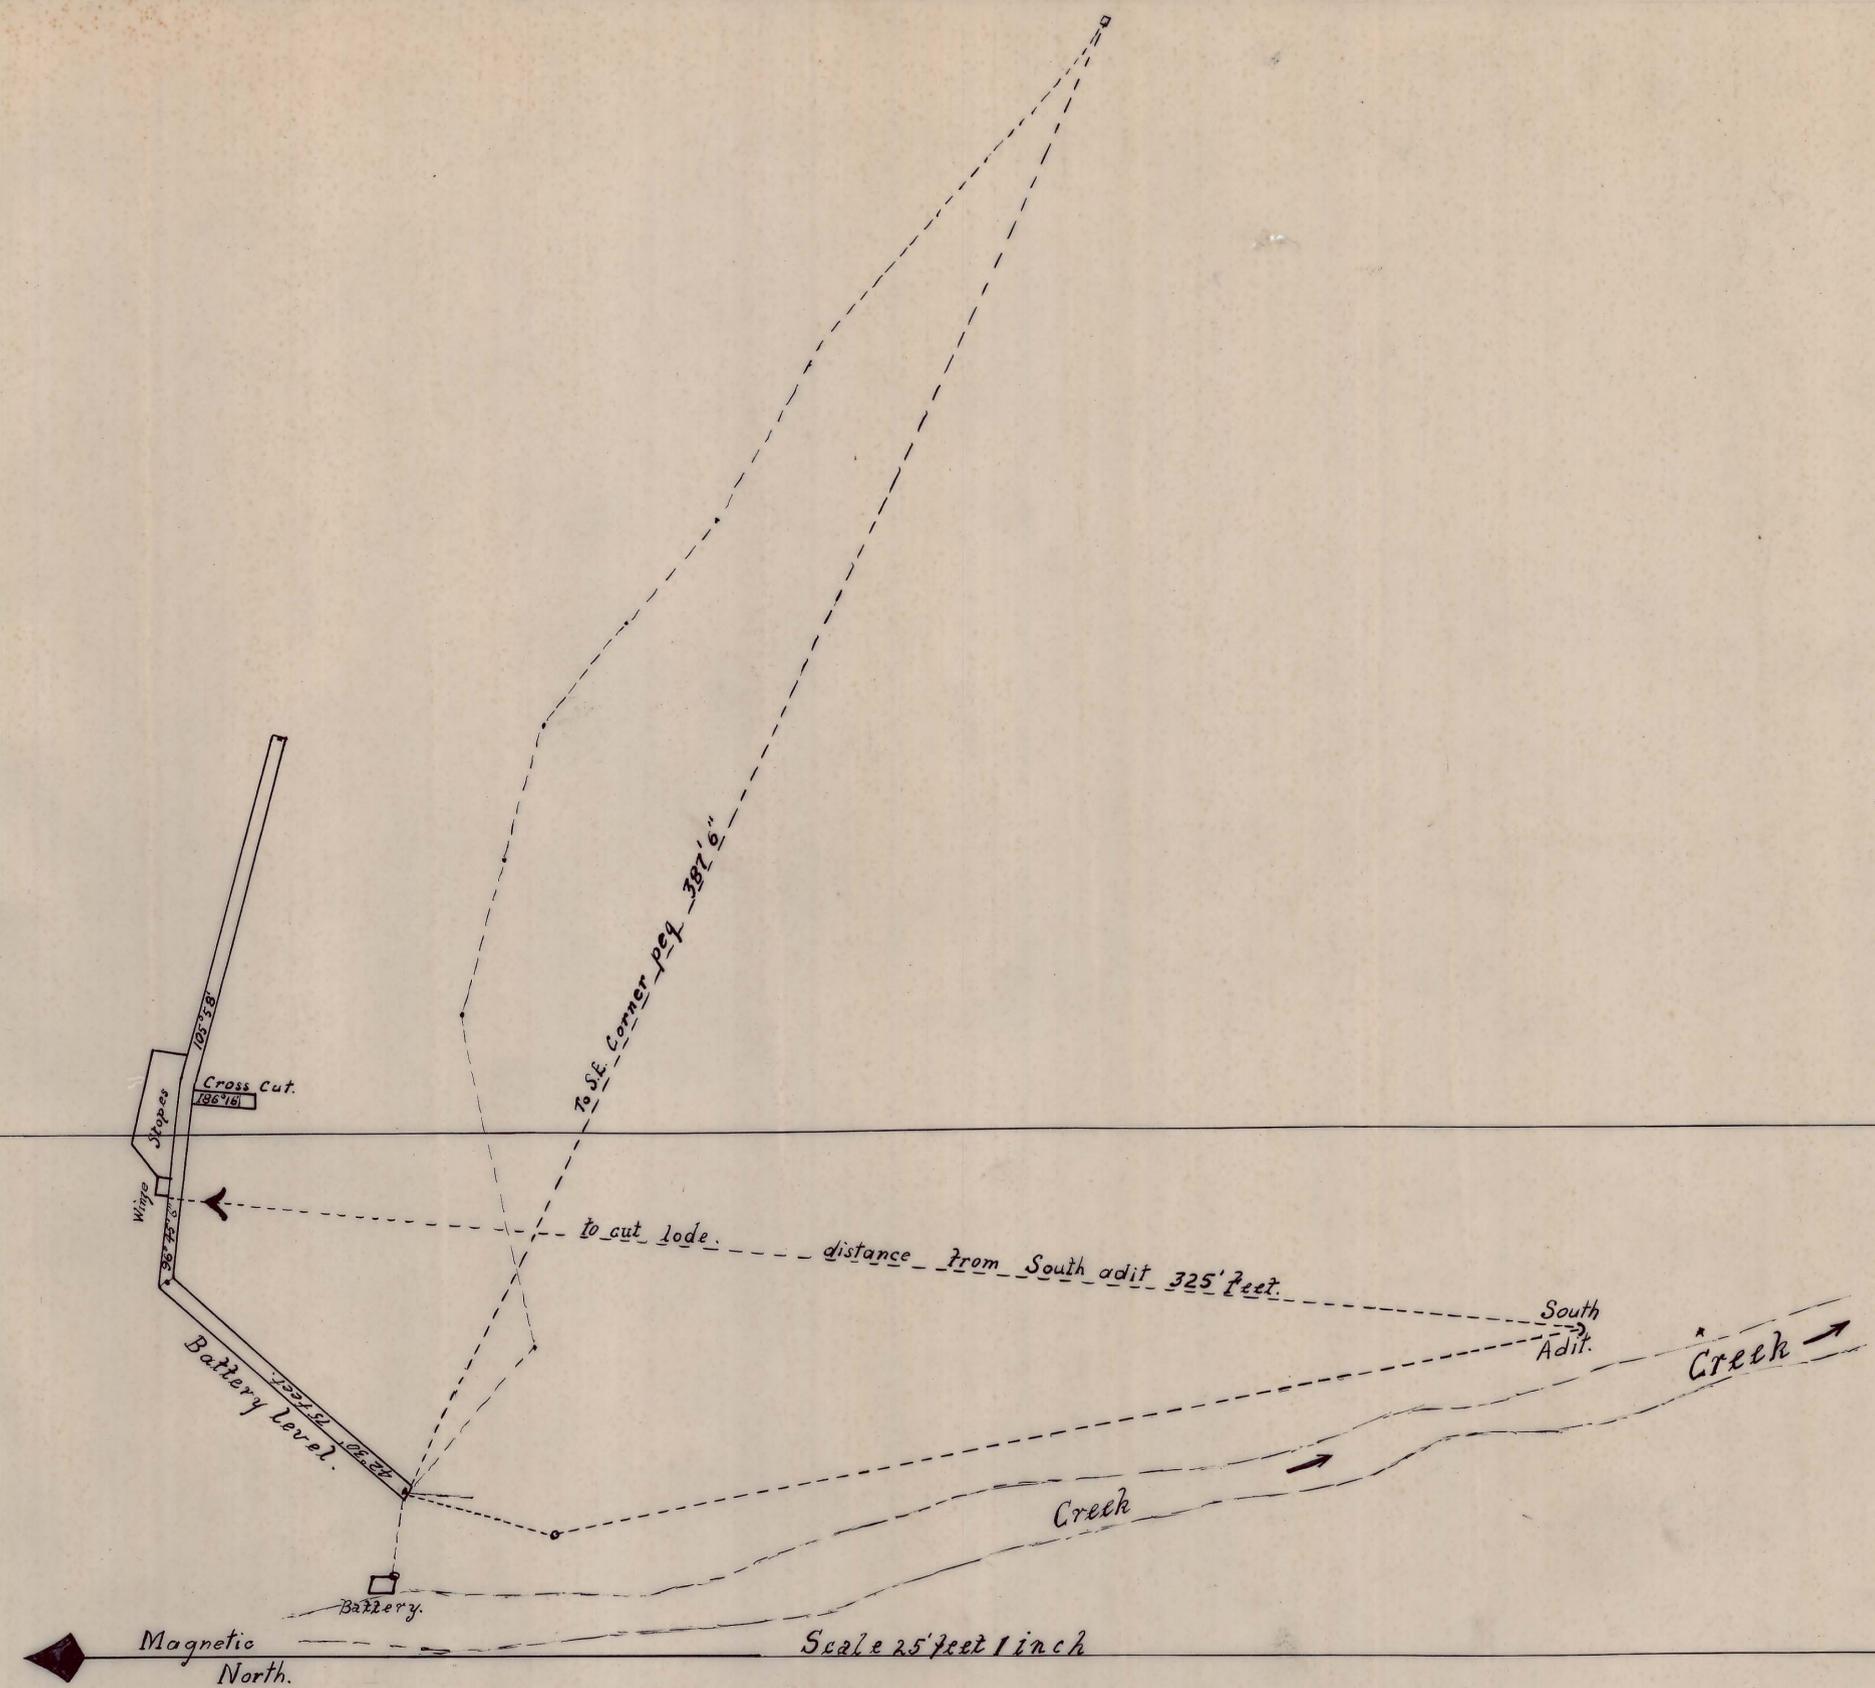

Longitudinal Section Battery Level.

Scale 25 feet to 1 inch.

Plan of the Mount Lindsay Mining Company NL.