







WESTERN ADIT

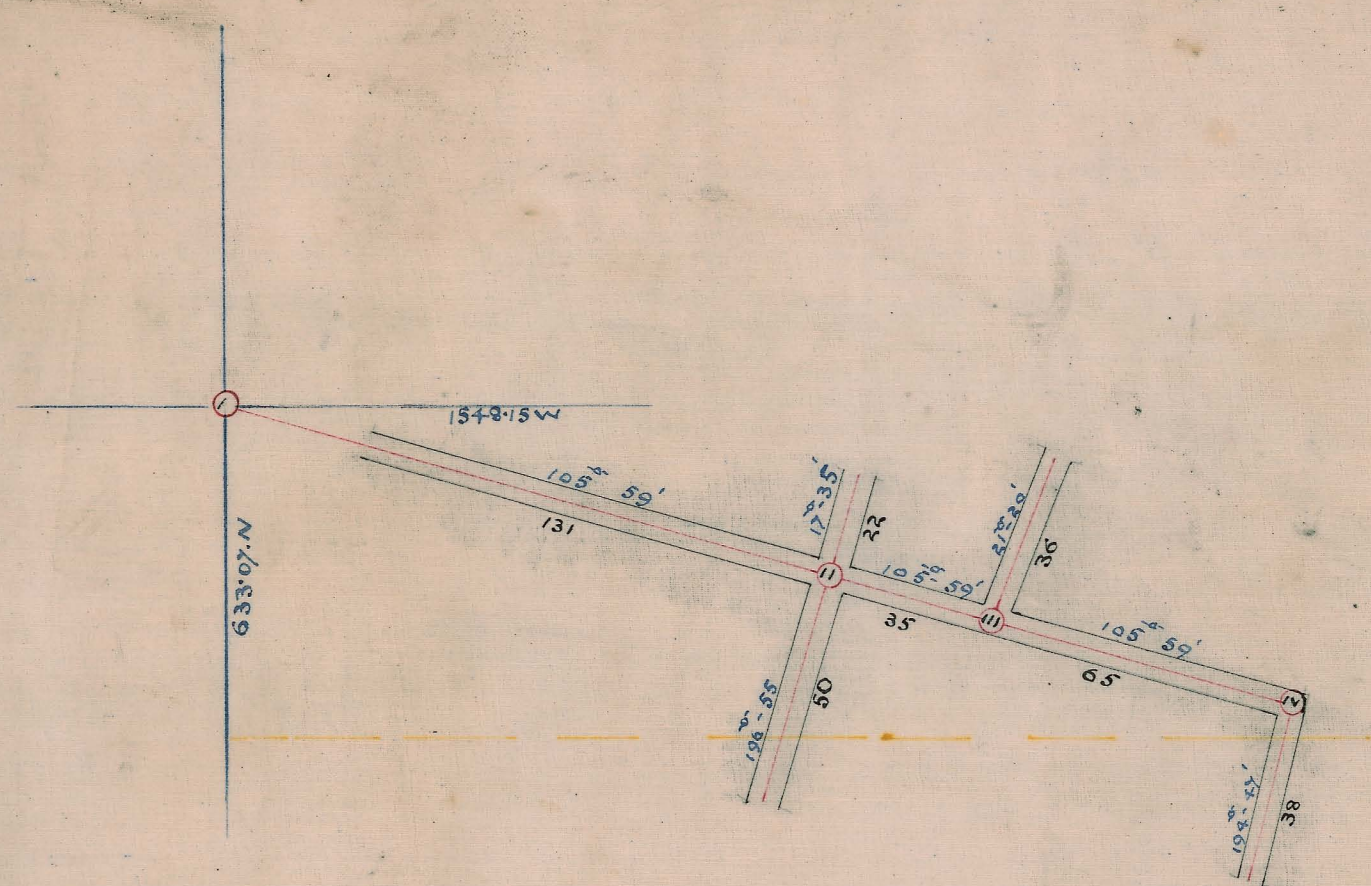

N°1 WEST X-CUT

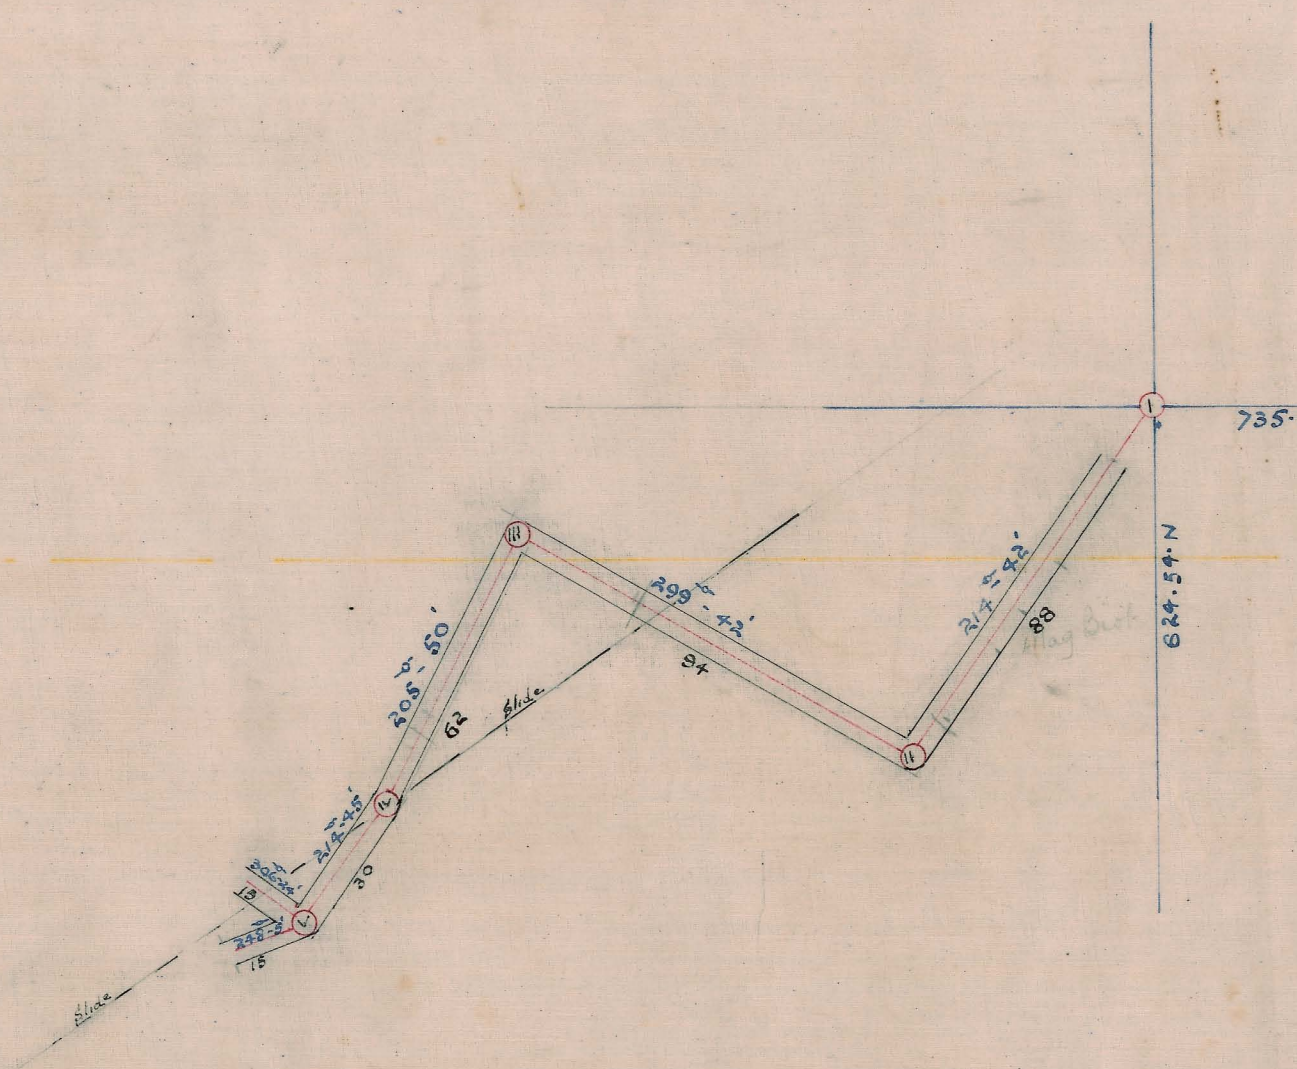

SOUTH-EAST ADIT

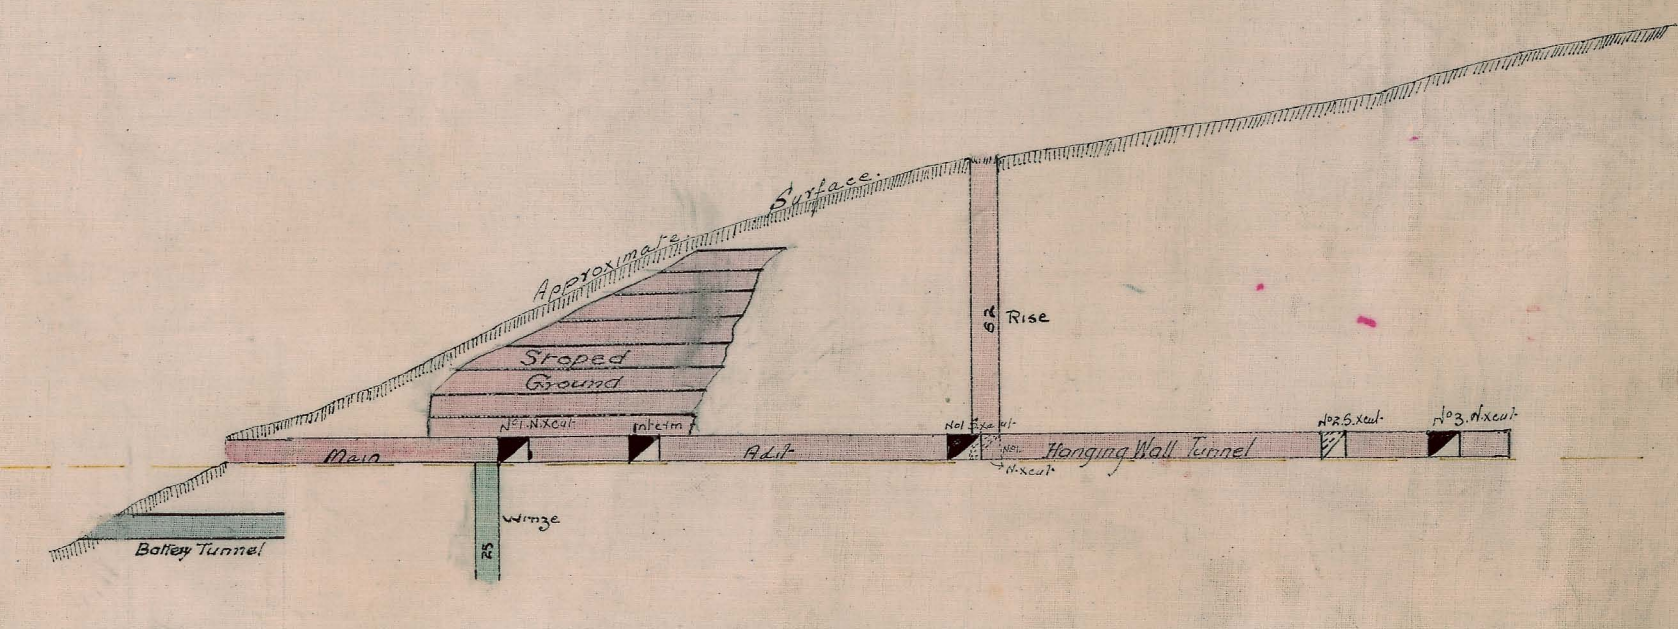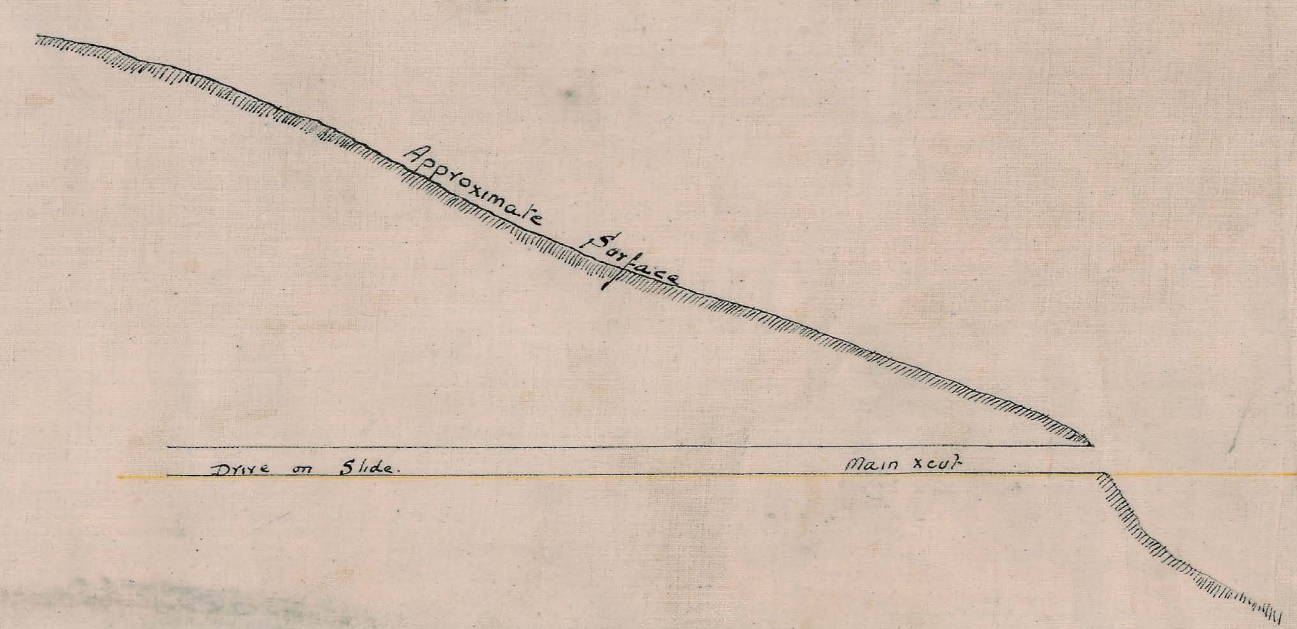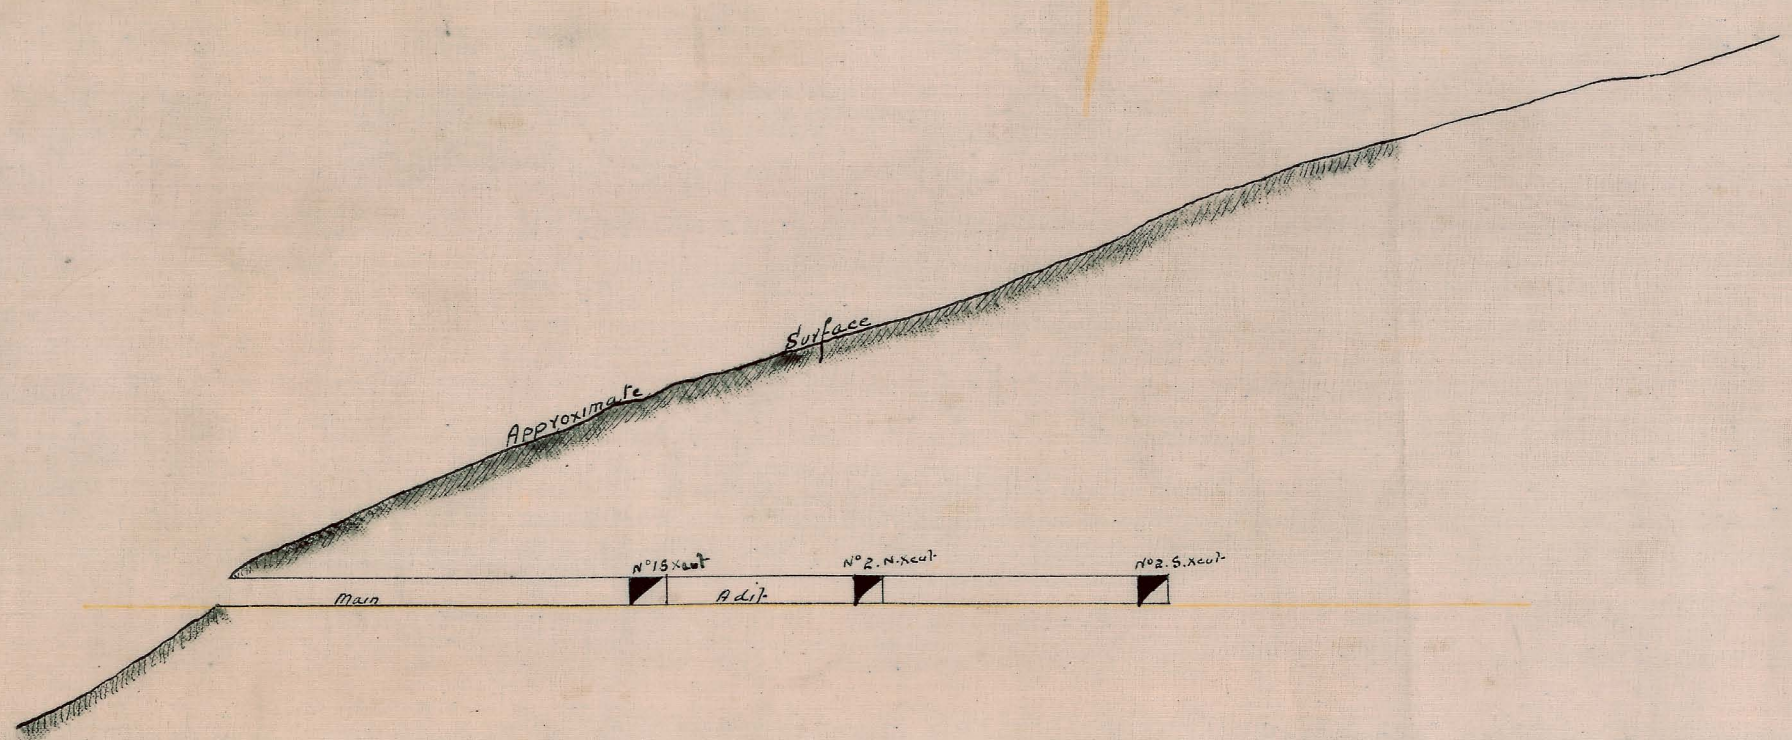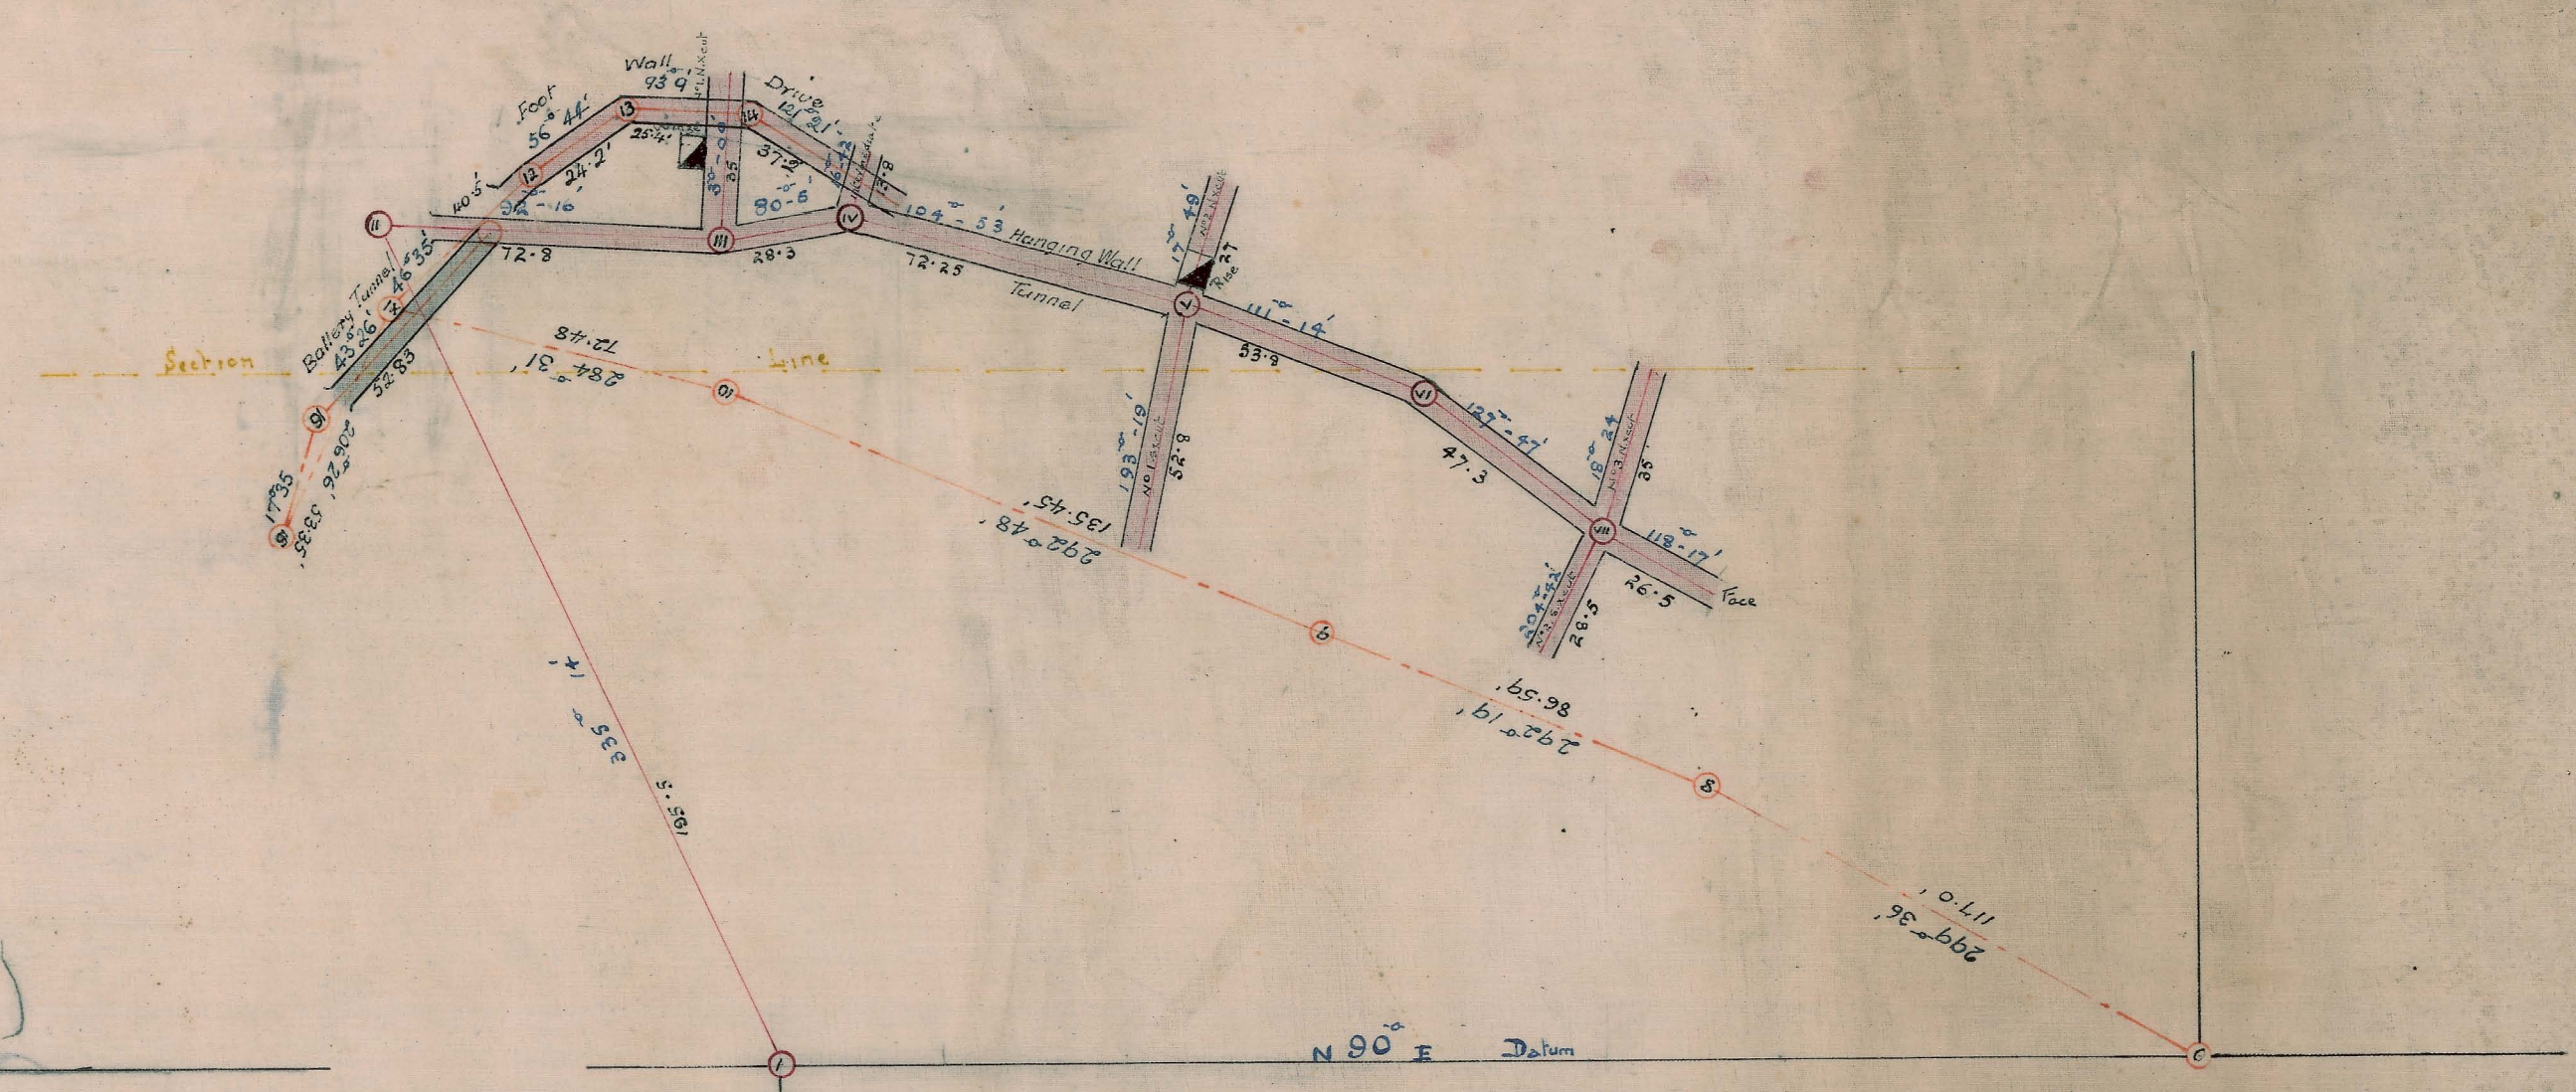

MOUNT LINDSAY

SCALE: 40 FEET = 1 INCH

Survey made with 8 inch Transit & 6 inch Level by J.B. Scott
 additions for years 1915-1916. Survey and Plan by J.B. Scott
 Instrument used 5 inch Transit theodolite.



J.B. Scott