







WESTERN ADIT

N°1 WEST X-CUT

SOUTHEAST ADIT

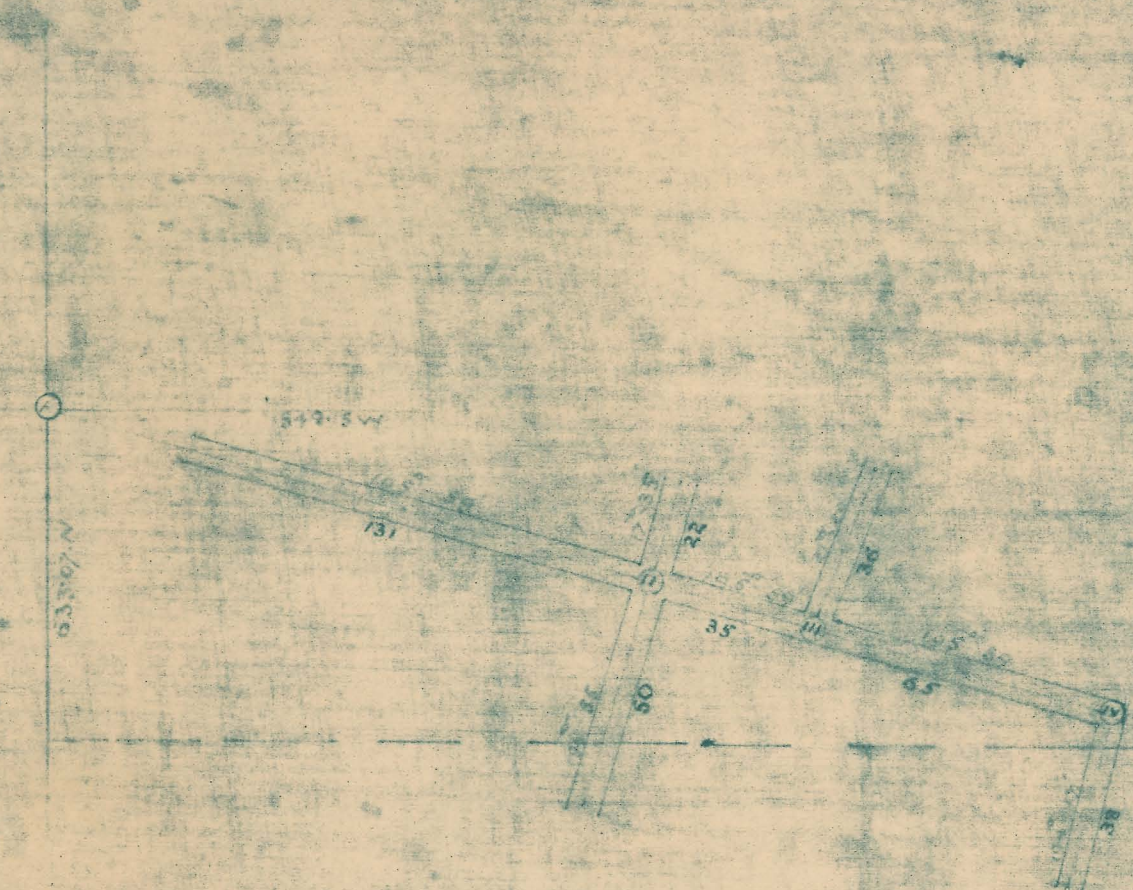

Line of Section

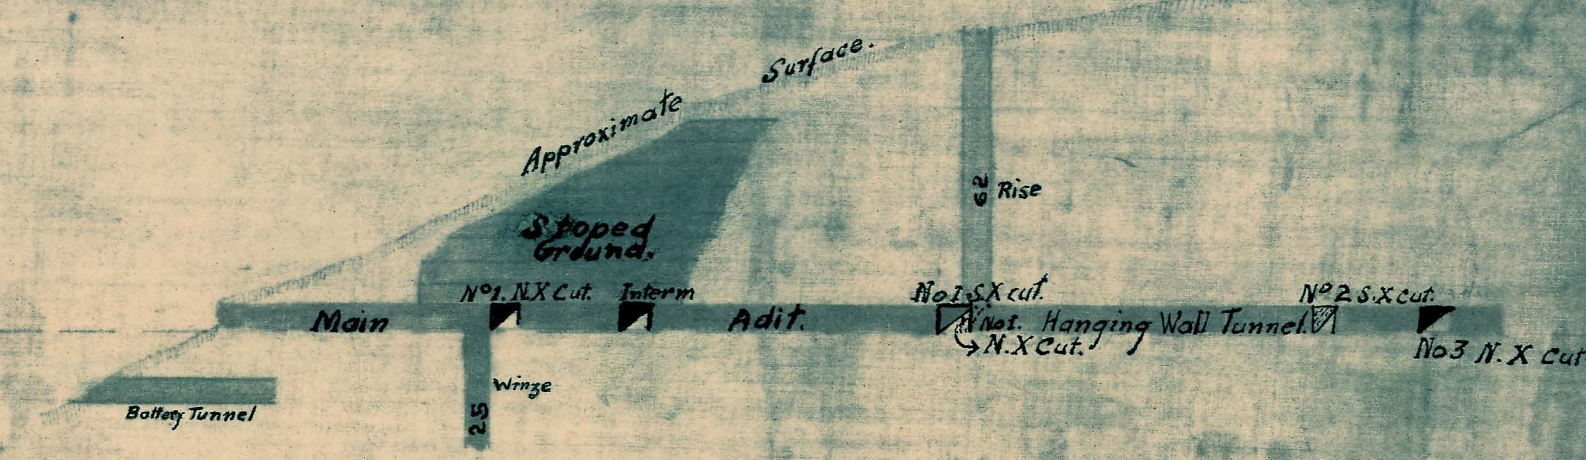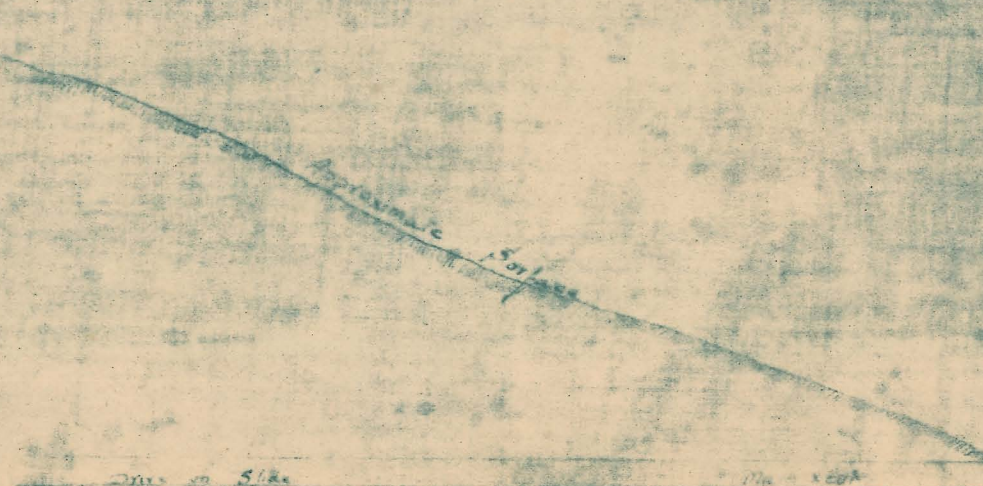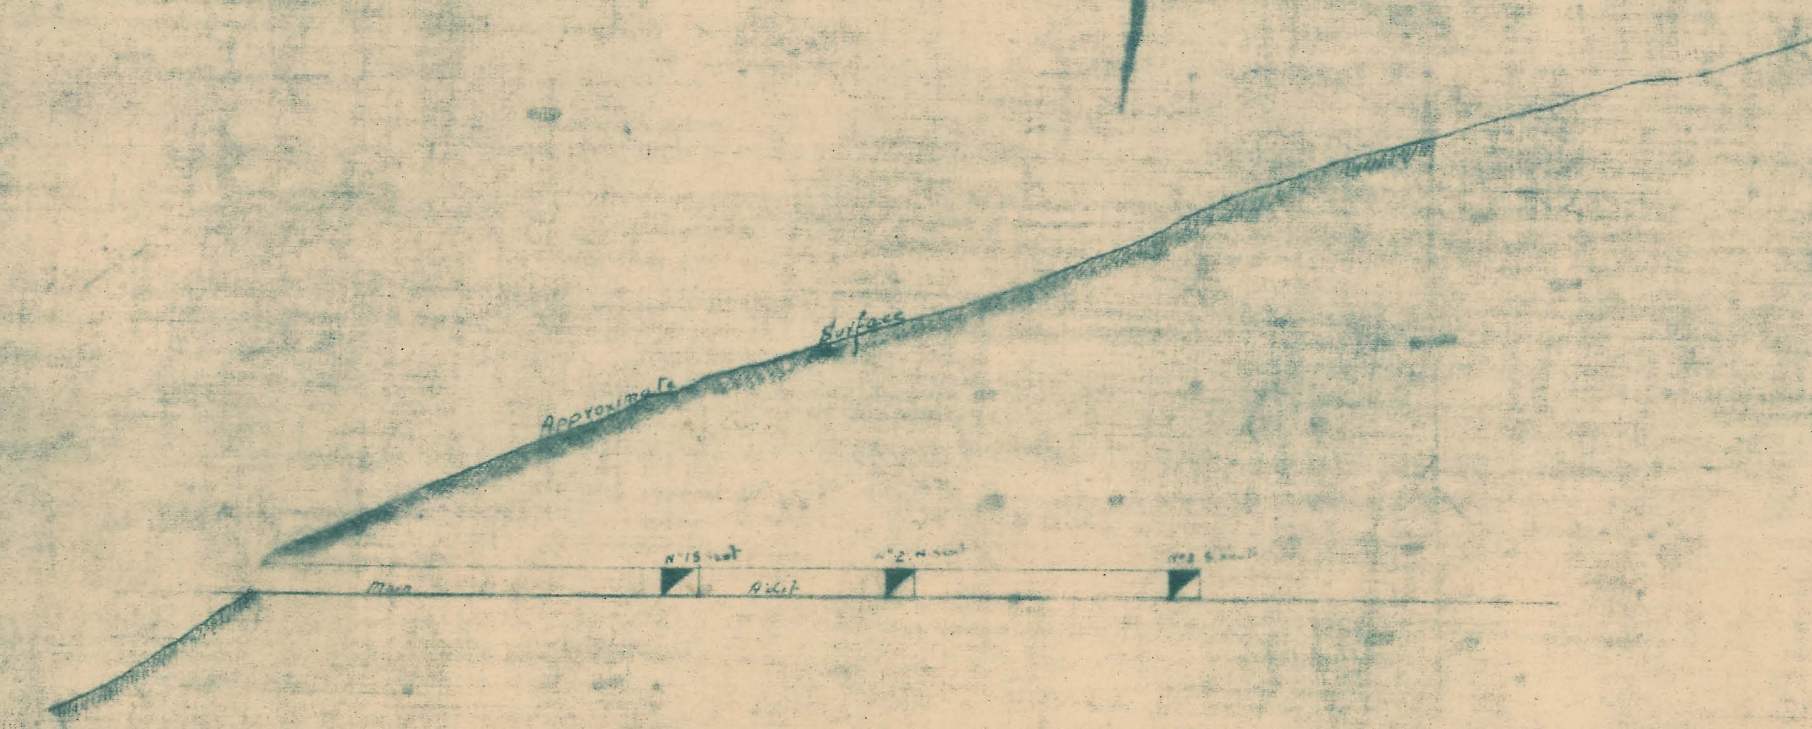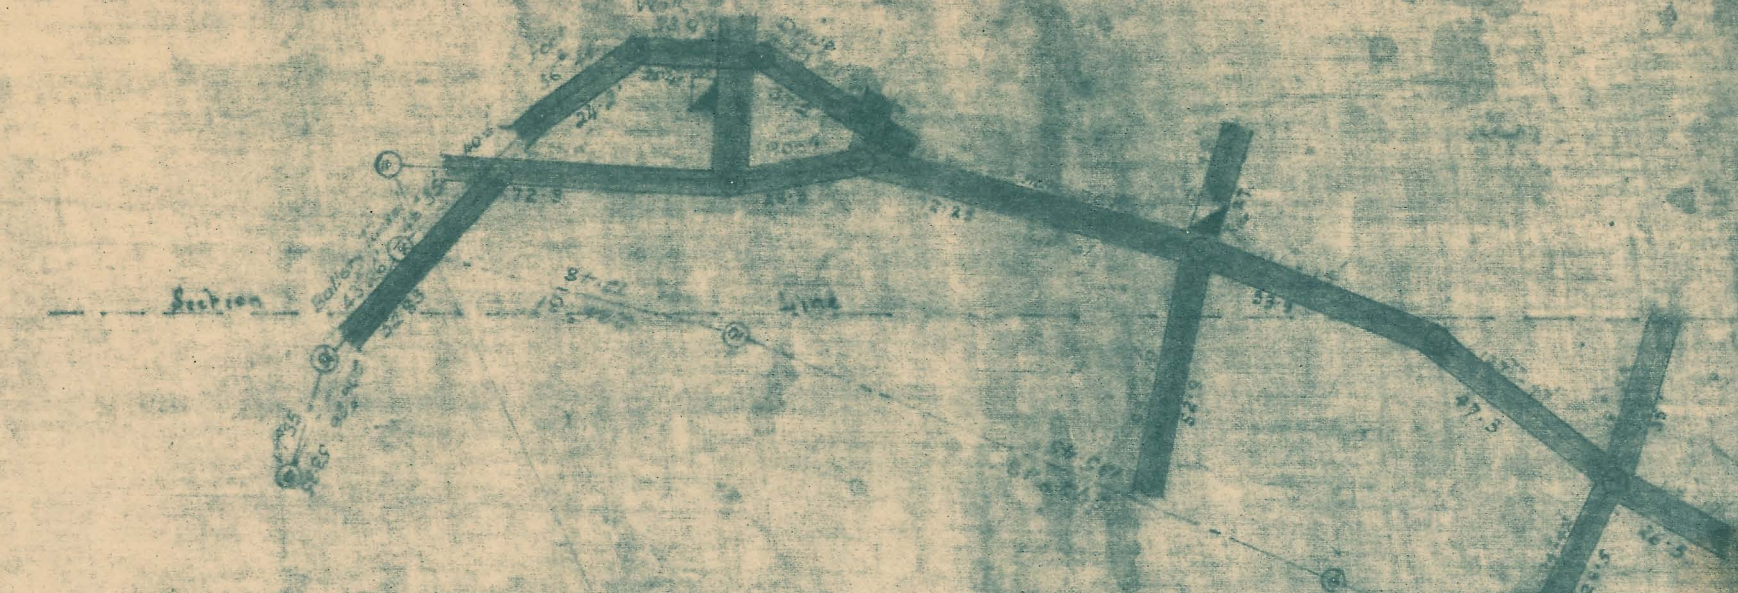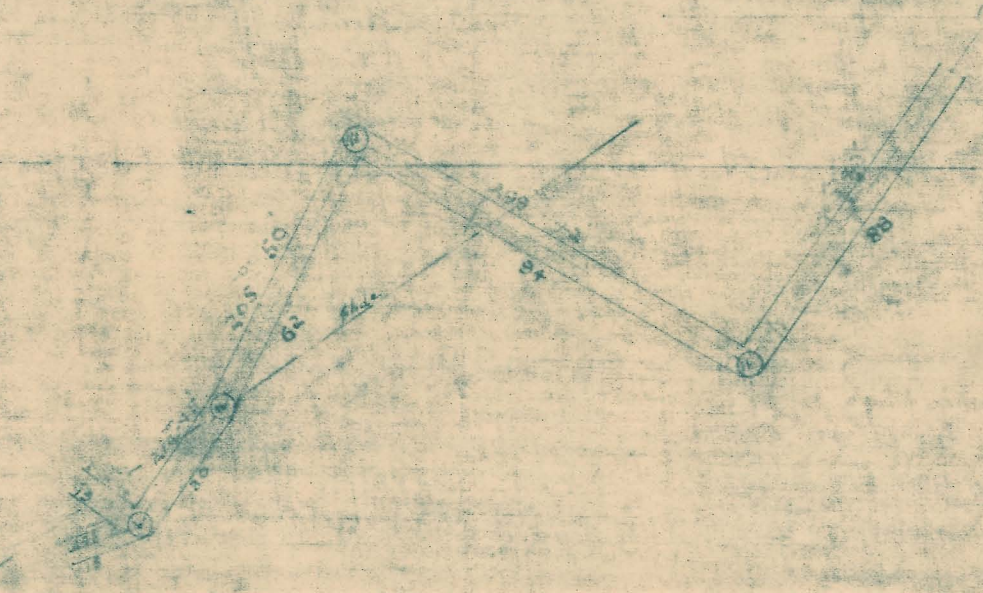

MOUNT LINDSAY

SCALE: 40 FEET = 1 INCH

5 cm

Some made into Area Tunnelled 8/10/12 by all hands
concerned to save 2000 lbs. of dynamite
to make small 5' and 6' long tunnels