



303
.02

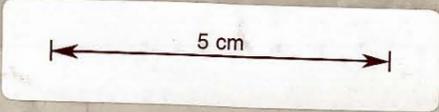

Plan

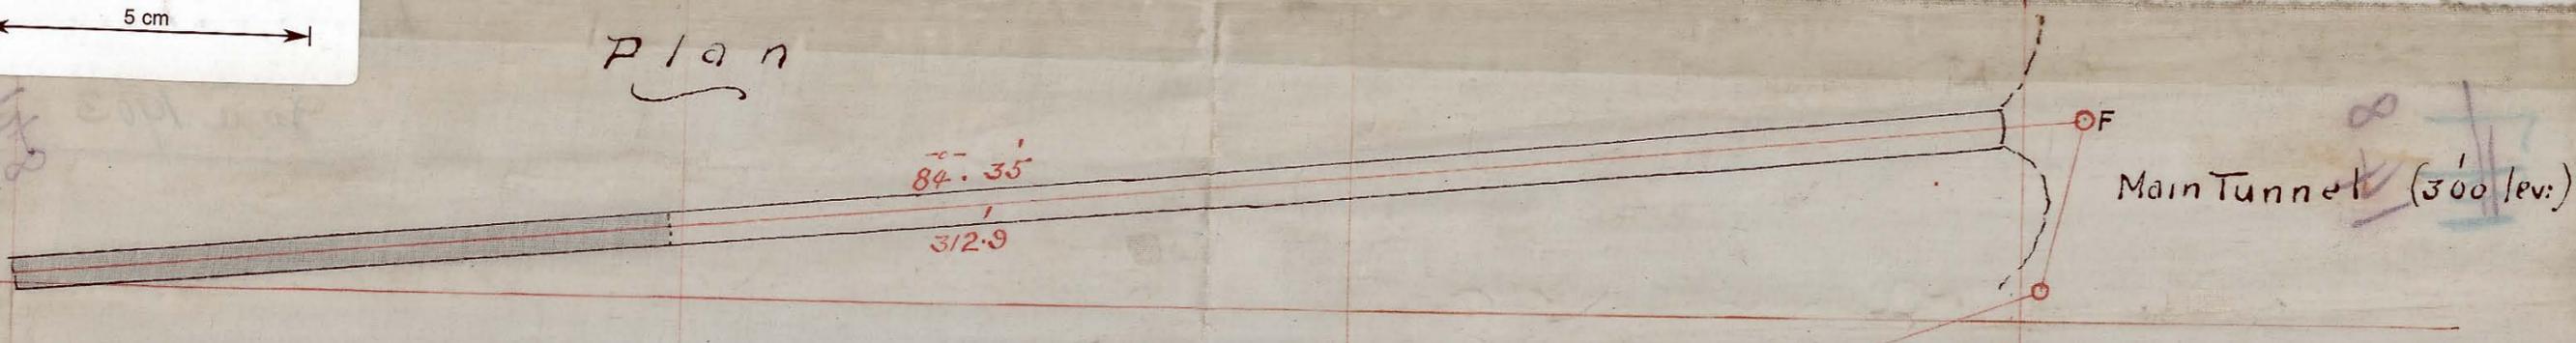

Dunne's Mount Read M. Co. N.L.

Scale 1 in = 25 ft.

Extension of workings for 1902.

R. C. Bird

Chf. Mine Manager,

W. Read

20th June 1903

Section

