
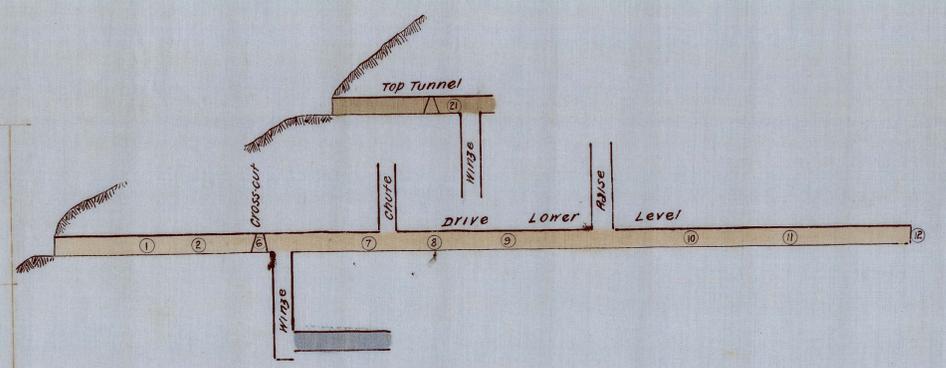



LEASE 1374, JOHN DUNN.

Scale - Twenty five Ft. to One In.



*Geo. W. Reid, Surveyor, Zeehan.
1914/11
Instantaneous Transit Theodolite.*

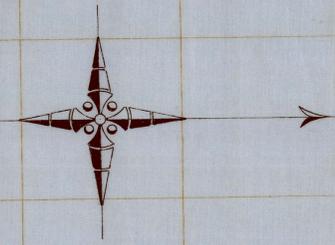

LONGITUDINAL SECTIONS
Facing North West

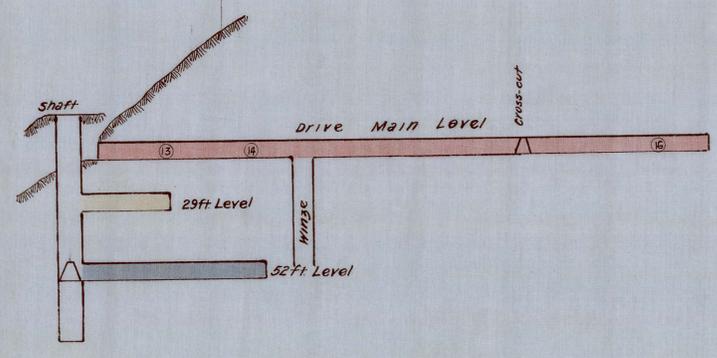

TRANSVERSE SECTION

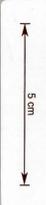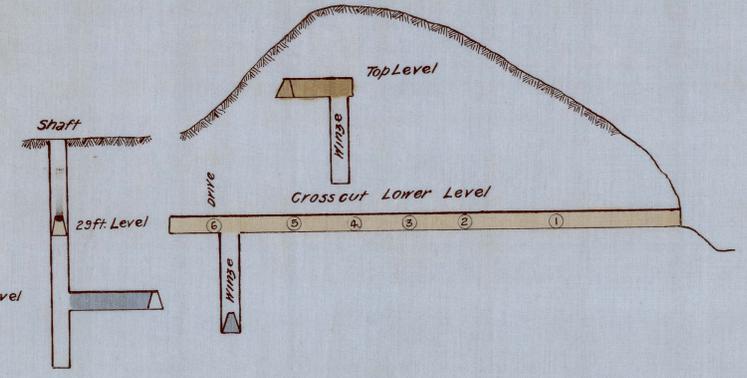

10
405