


900



SECTION E & W

NORTH HERCULES
96 94 97 94

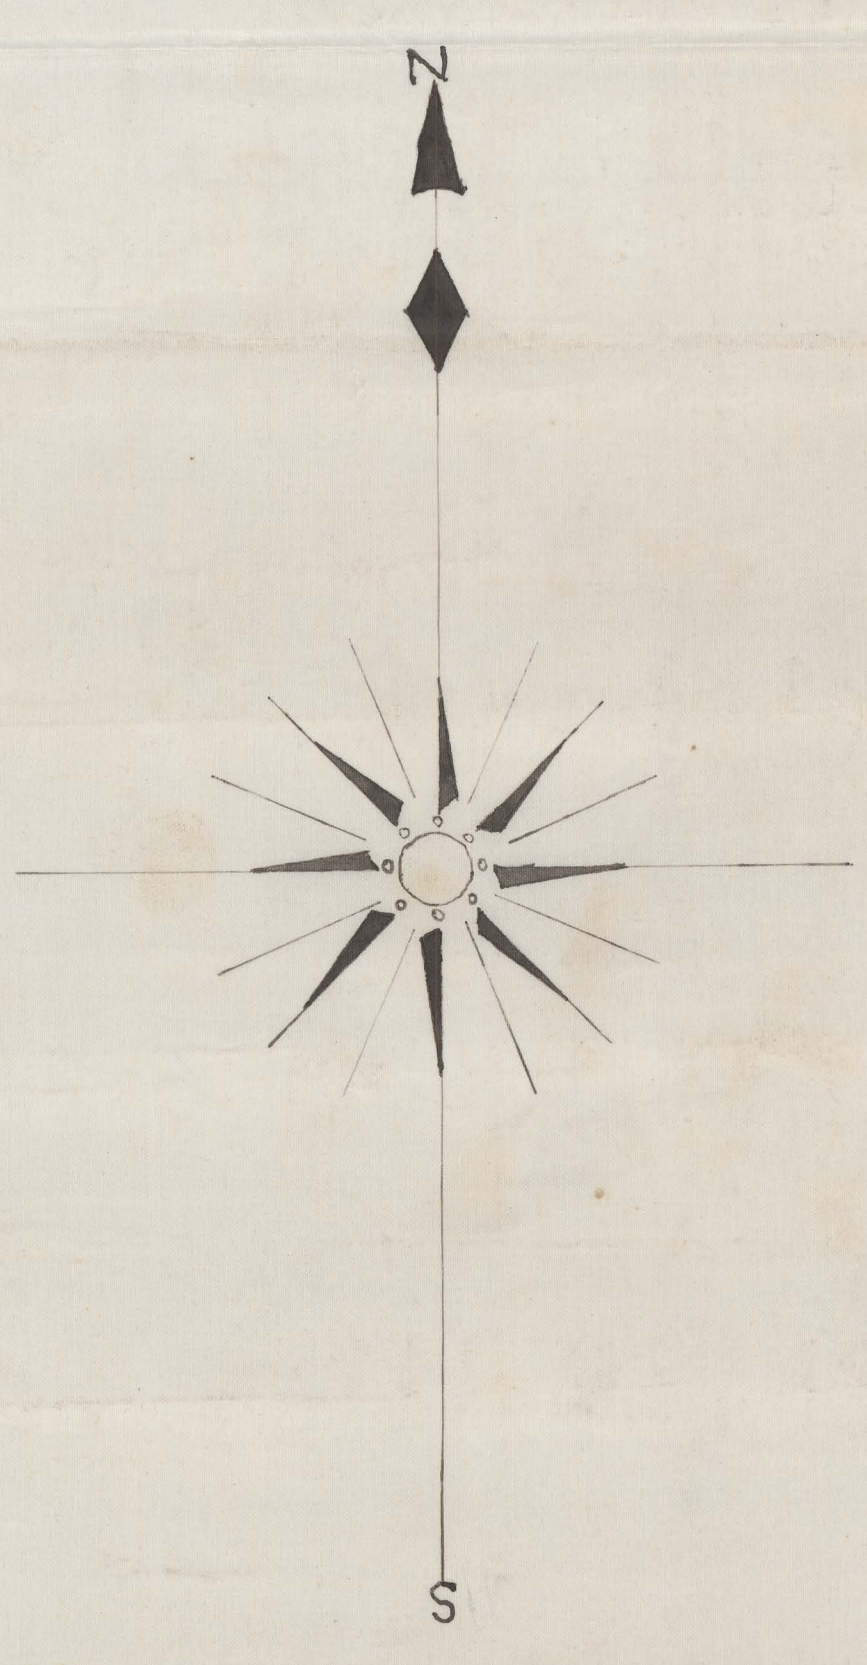


200
93 M



PLAN
OF
BARLEN-HERCULES. C. S. & C. M. COY

Scale 20 ft to 1 inch

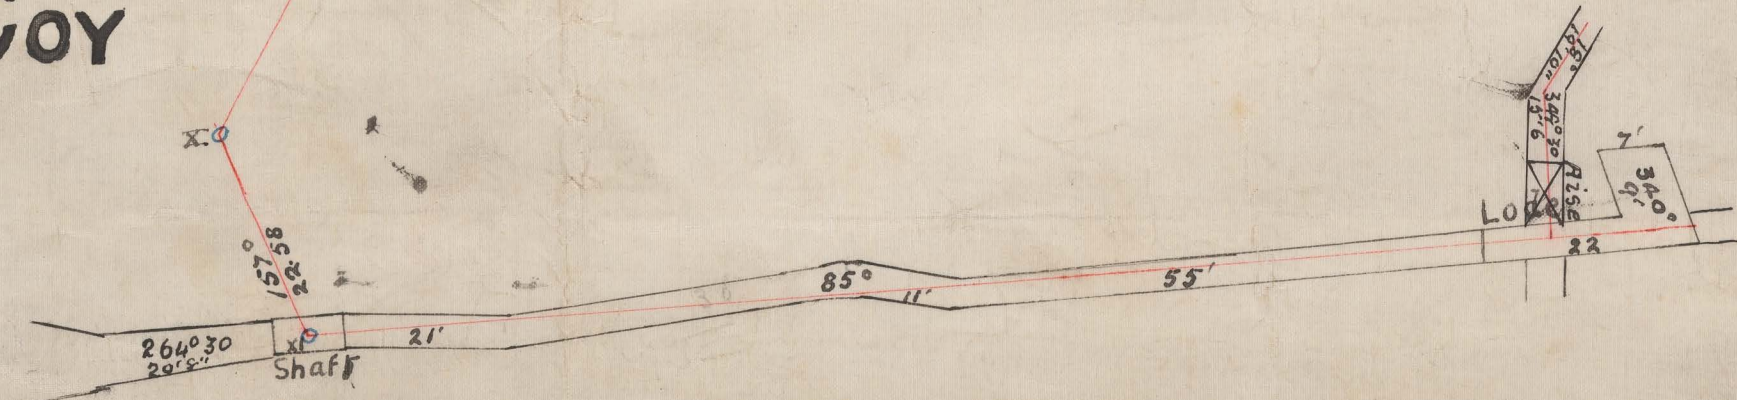

100
94
HERCULES

*N. B. Stark, Surveyor, School of Mines
No. 100, Kansas
July 1897
Surveyed with
Wm. L. Hartshorn*