


The Barlen Hercules Mining Company

Tracing from Plan prepared by M. Sinclair

Scale 1"=20'

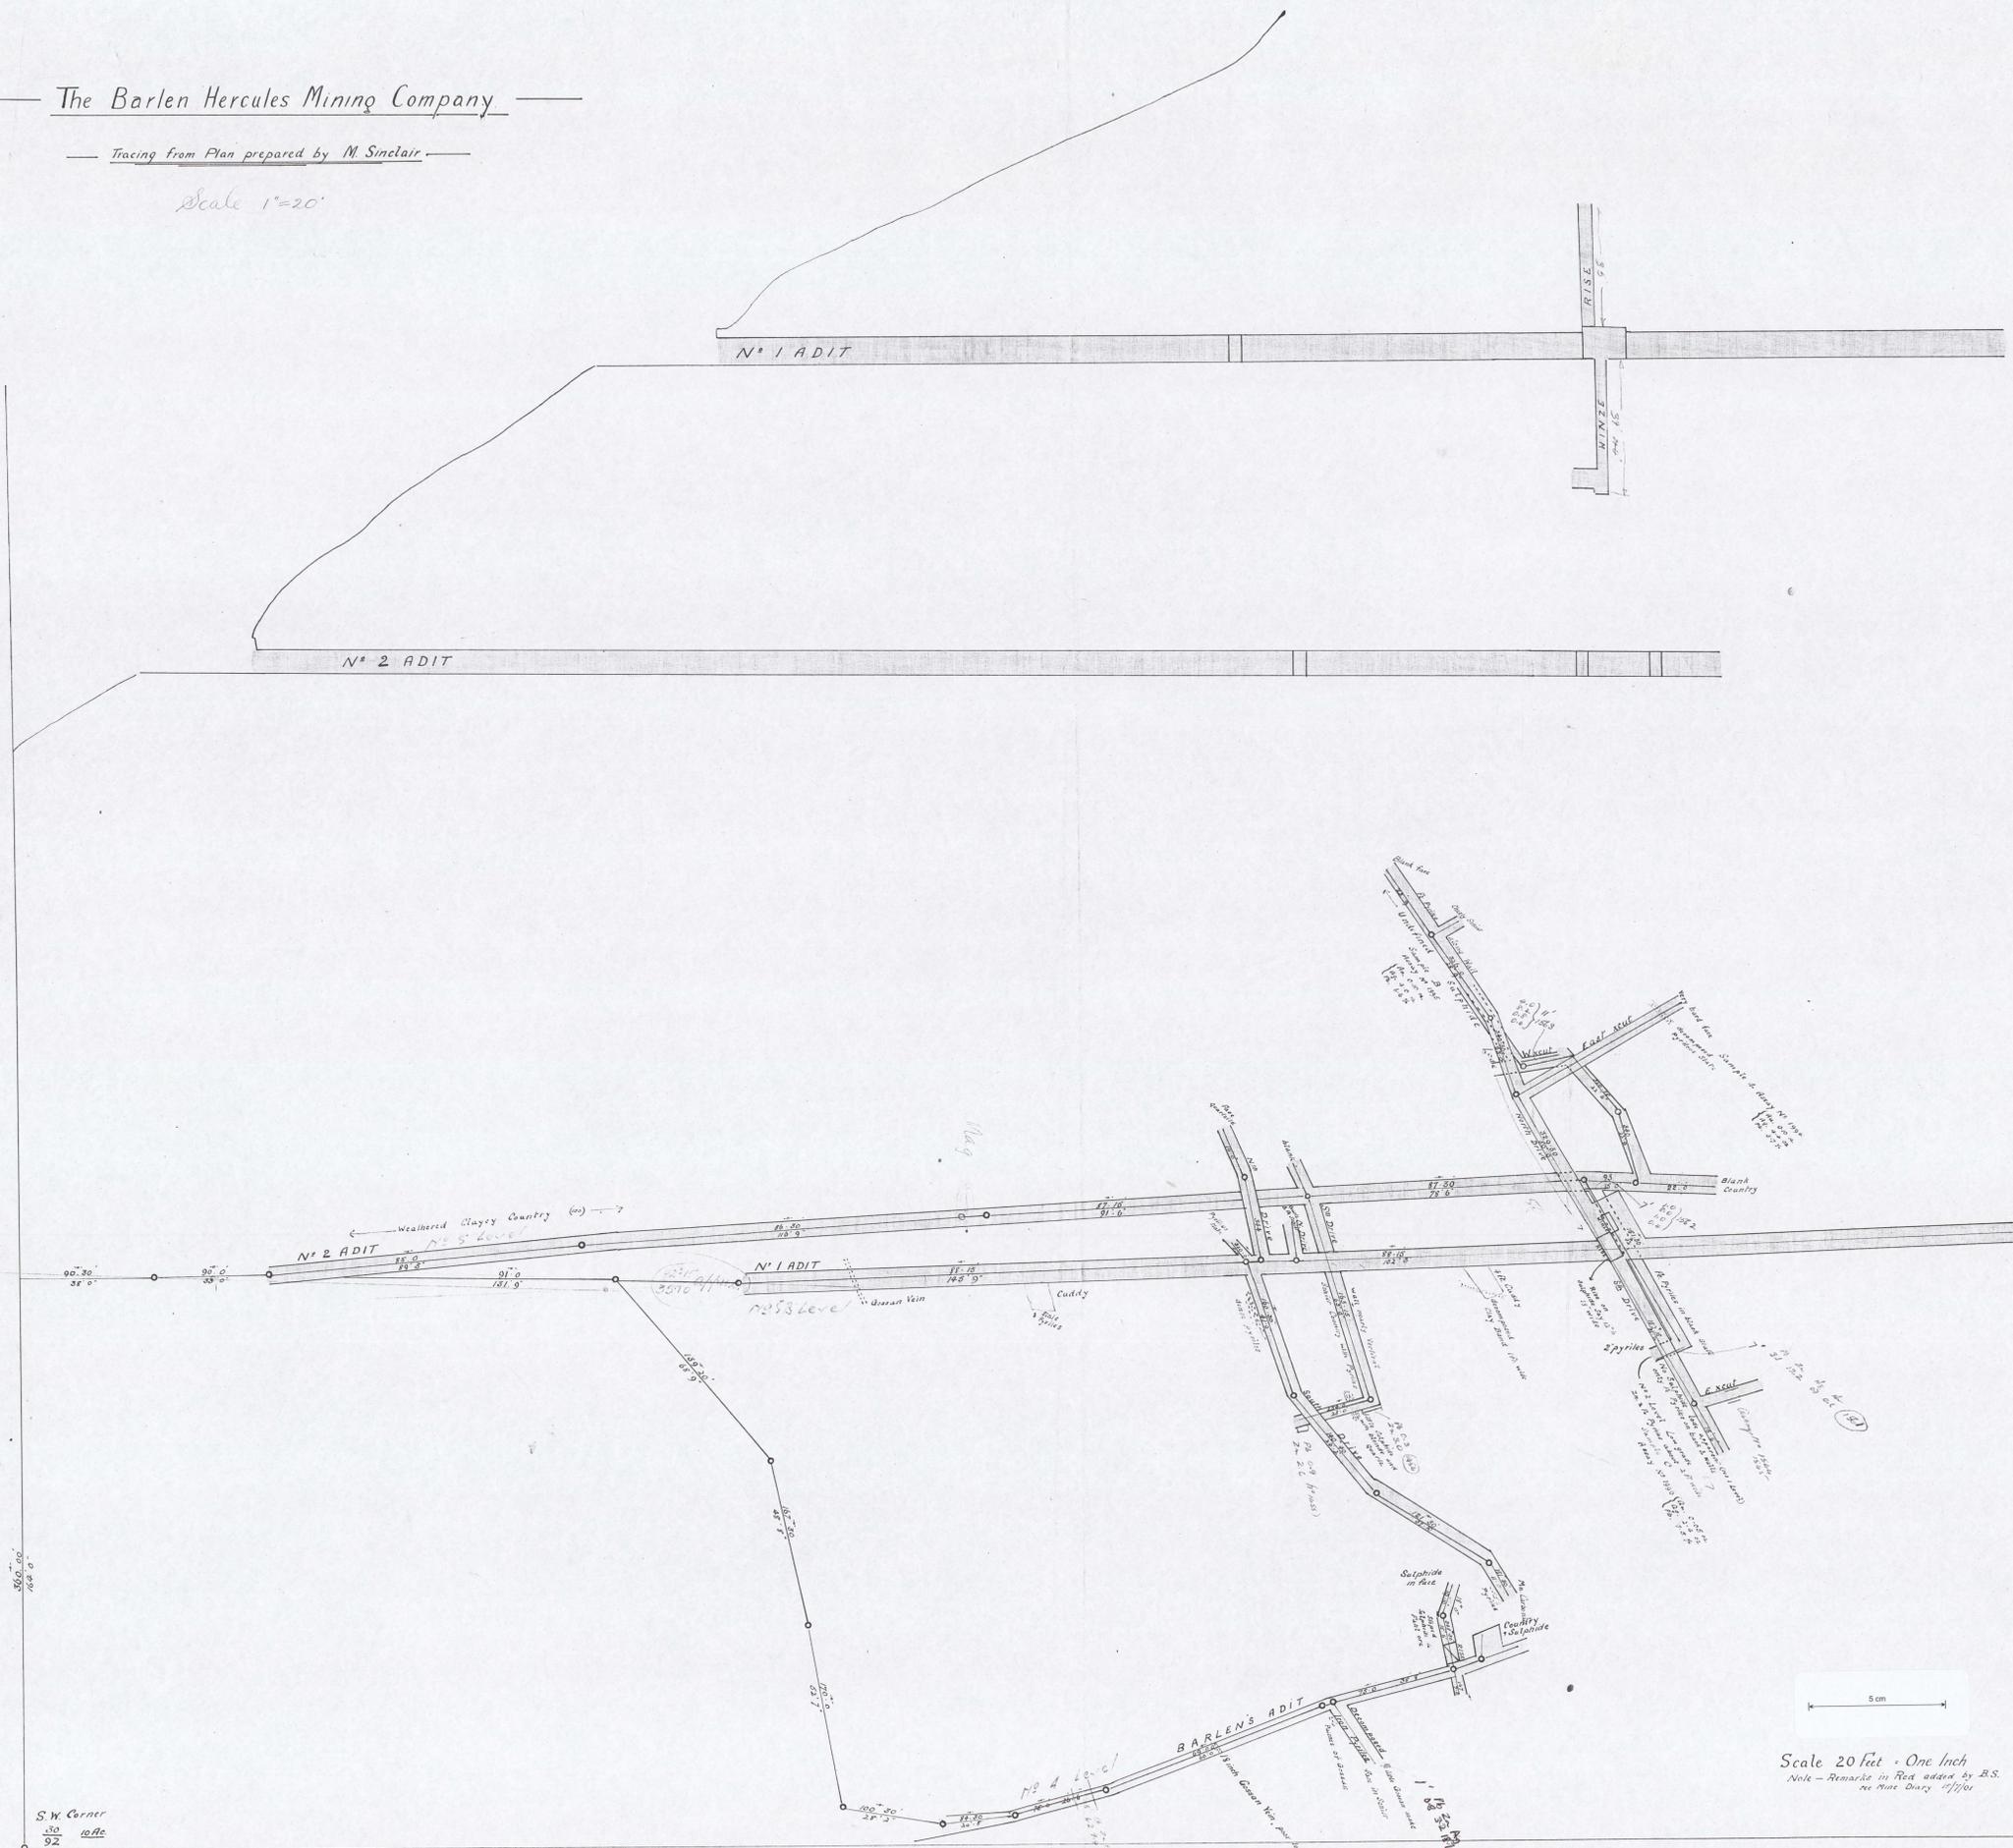

0306-003

Levels Plans
Barlen Hercules

Scale 20 feet = One Inch
Note - Remarks in Red added by B.S.
see Mine Diary 1910

All relevant information transferred to new survey-plans Sept 1944. This tracing is not required to select of survey-office 1944.

N° 5, 5B & 4 Levels (Barlen)
checked in 1944 level

43

S.W. Corner
320
92