

307
01

5 cm

1891

— THE PRIMROSE MINING COY. NL. —

— Longitudinal Section —

— Scale 20 ft to 1 inch —

George B. Hunter
M. Eng.
17/1/12


— North —

— South —

— TAS. COPPER COY. LTD. —

— 2707 M. —

— 454 Ac. —

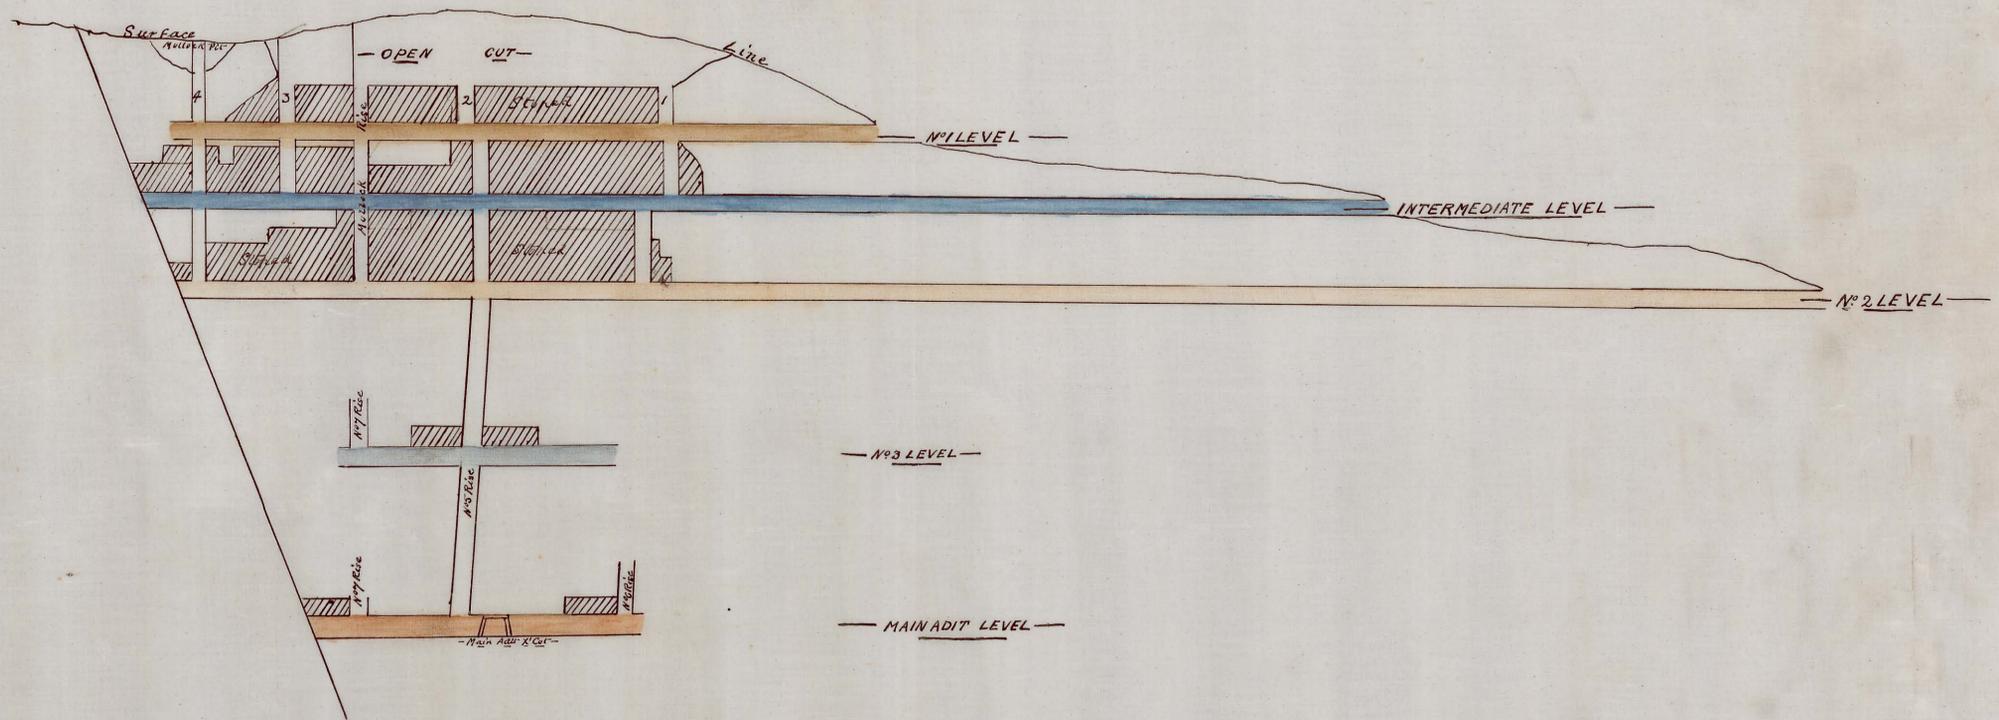

1891