


5 cm

NORTH  
BOUNDARY

Main Adit Level  
No 3 Level  
No 2 Level  
Intermediate Level  
No 1 Level

THE PRIMROSE MINING CO. NL  
PLAN  
of Underground Workings

Scale 40 = 1  
Eng. Butler  
Mine Manager  
2/1/04

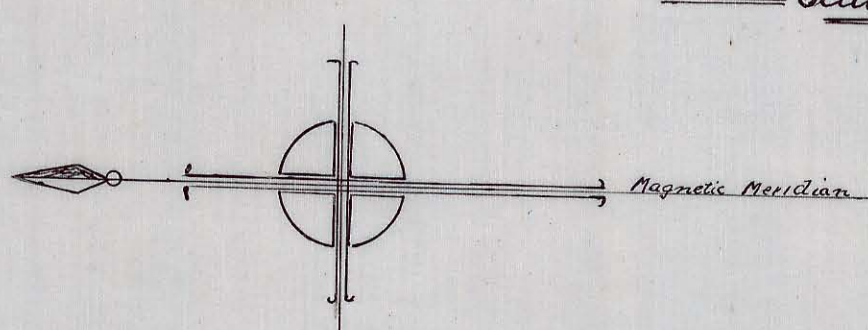

NEW ADIT