




308
01

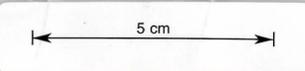

TASMANIAN COPPER CO. LIM^{TD}

Underground Surve for 1905

Scale 40 feet = 1 Inch

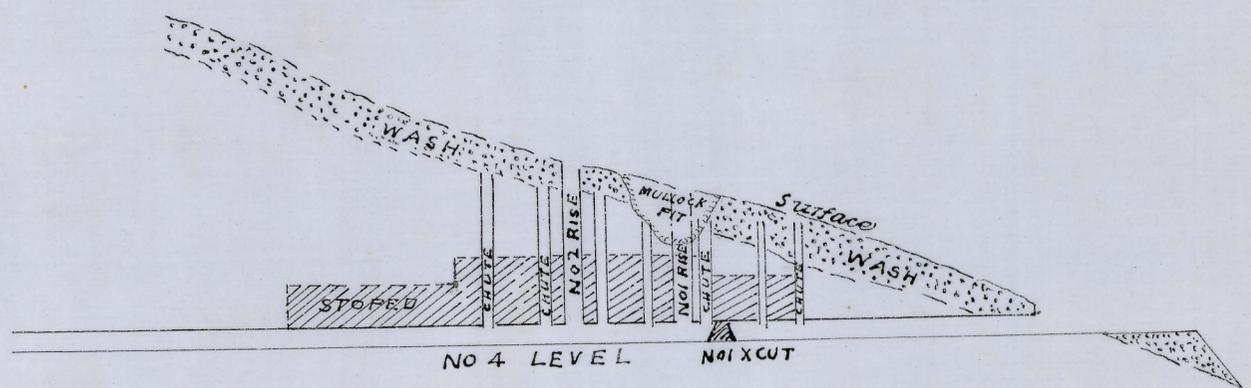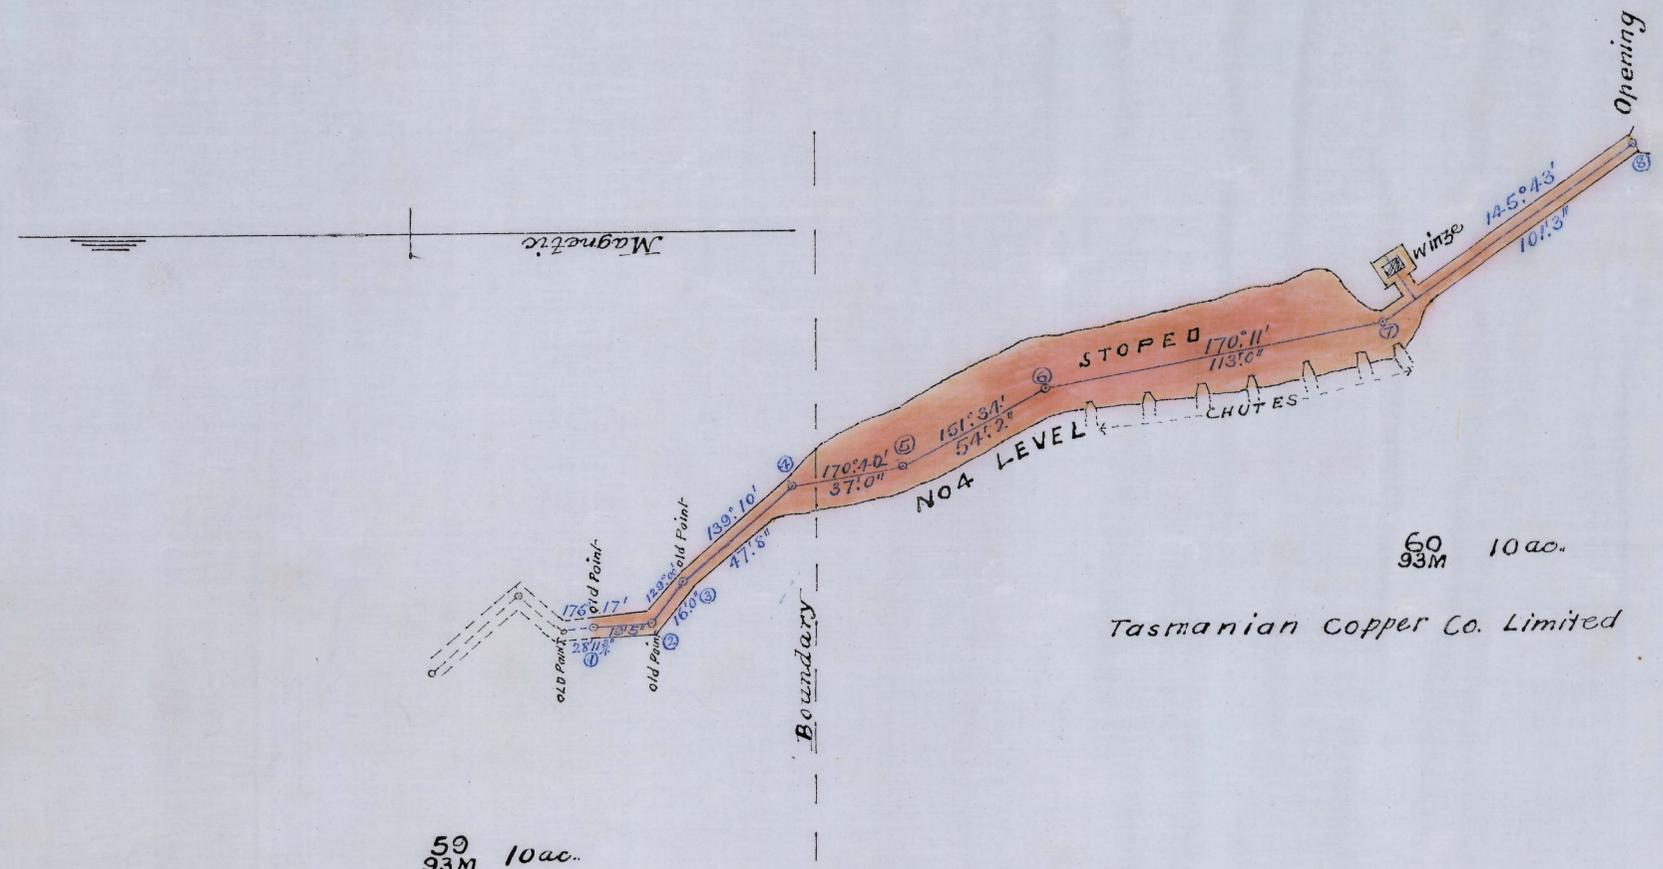

Survey made with a theodolite
 John Power
 Authd. Surveyor
 17.4.06

181
182

18P