


308
02

5 cm

RING RIVER P C (Tasmanian Copper Co Lim)

Longitudinal Section

Scale - 40 feet to an Inch

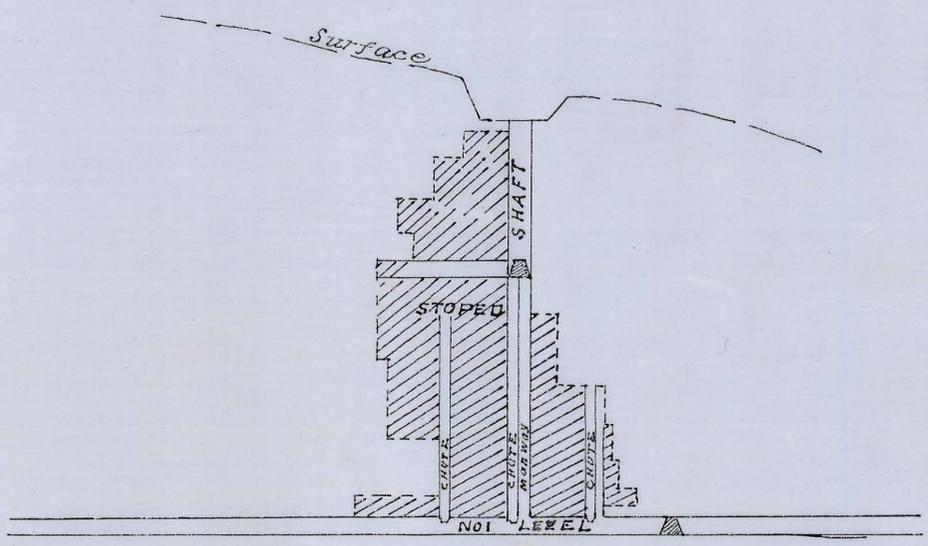

*John Power
Auth. & Surveyor
21.4.06*

