


TASMANIAN COPPER CO LIM^D

Underground Survey for 1905

scale 40 feet = 1 inch

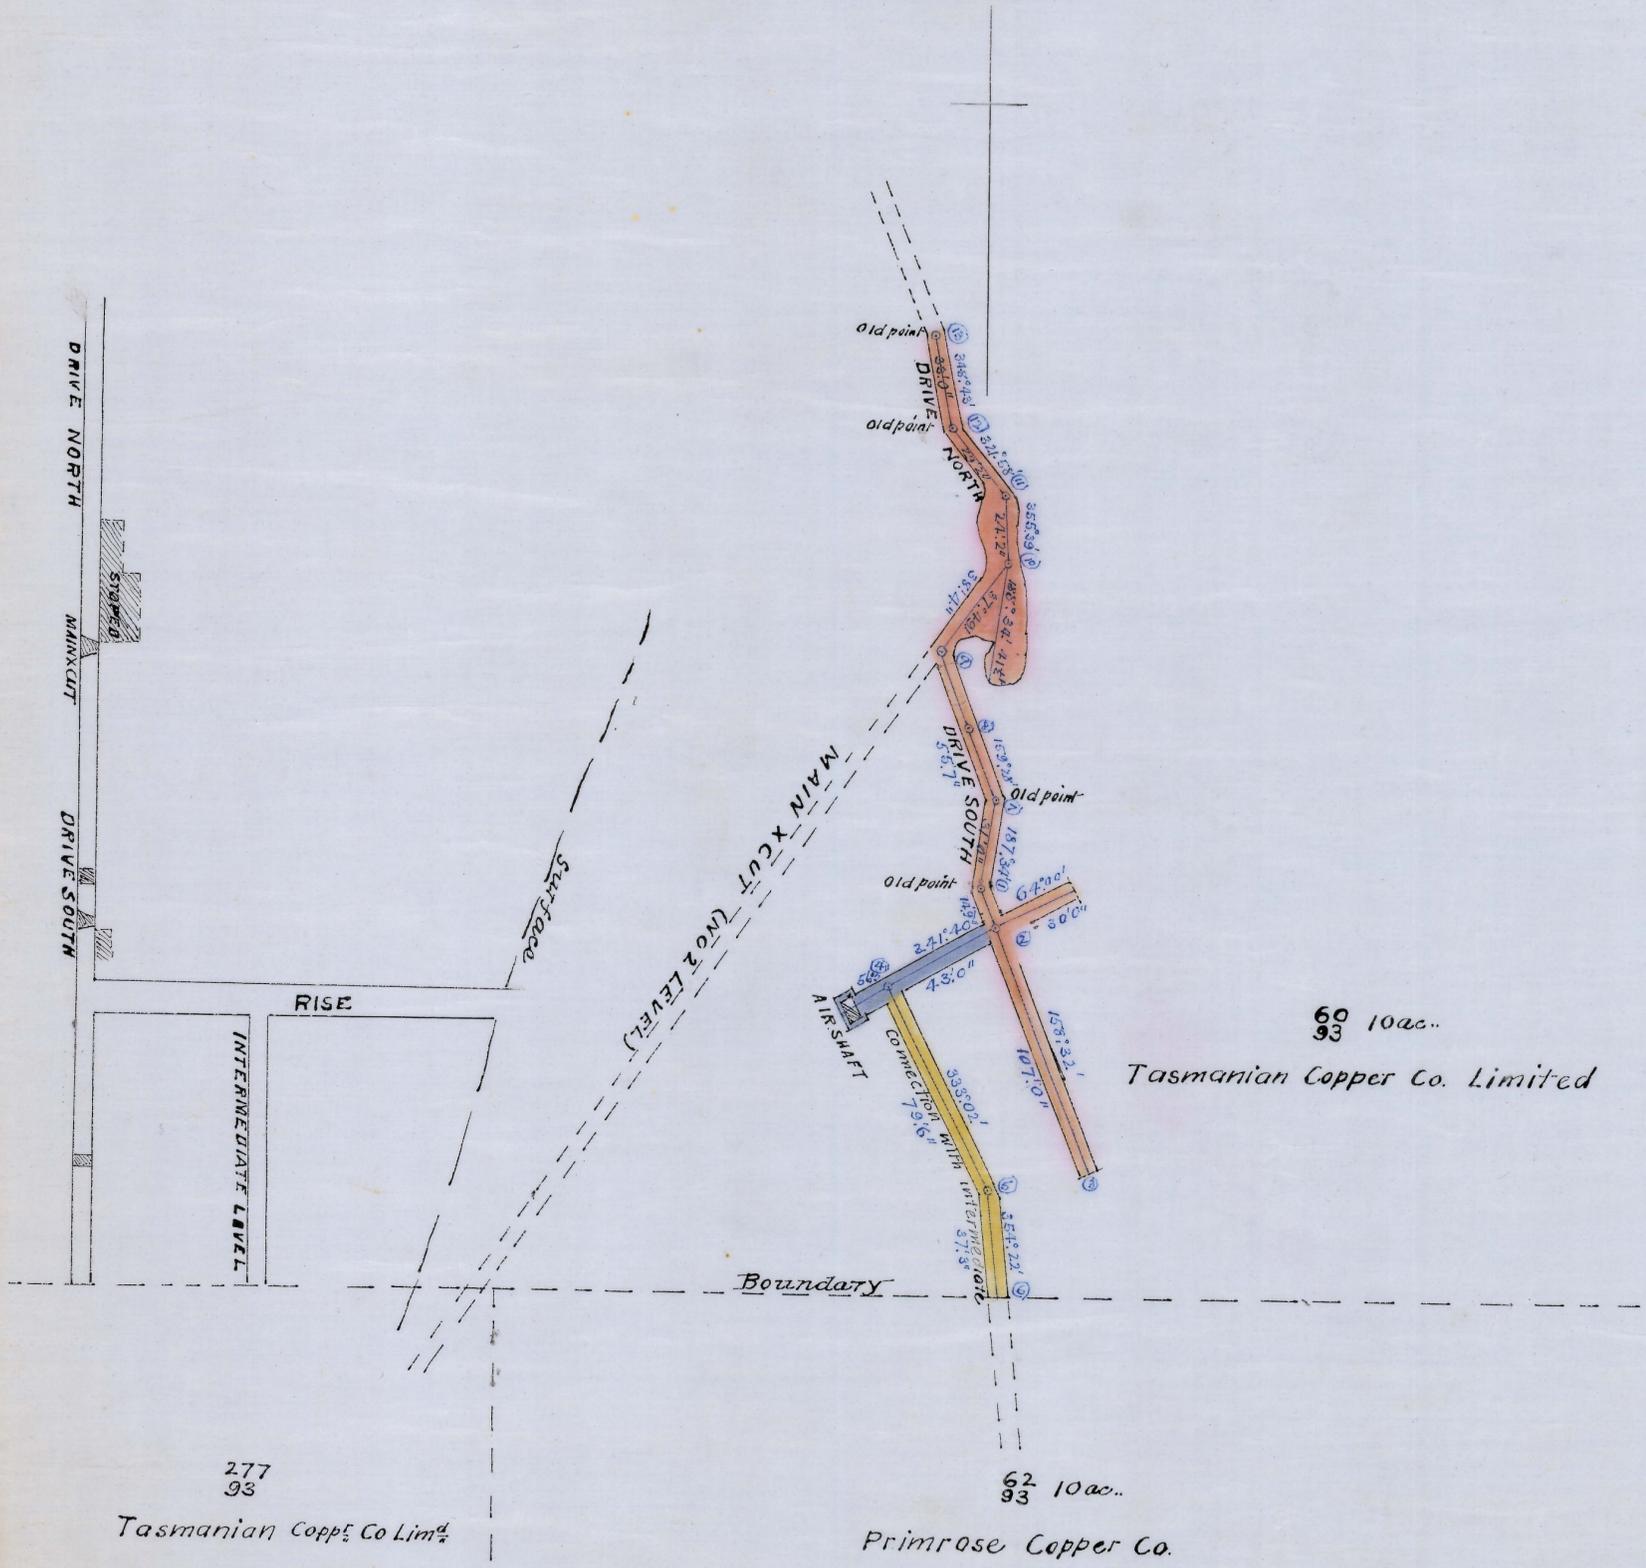

60
93 10ac..
Tasmanian Copper Co. Limited

277
93
Tasmanian Copper Co Lim^d

62
93 10ac..
Primrose Copper Co.

Survey made with 4" theodolite

John Snow
Aust^d Surveyor
15. 14. 06



Handwritten notes:
20/10/06
20/10/06