


PLAN OF MINE WORKINGS




ON
BLOCK 297

SCALE
25 FEET = 1 INCH

266
93M
80 AC
MOUNT REID MINING COY LIM
M.L.

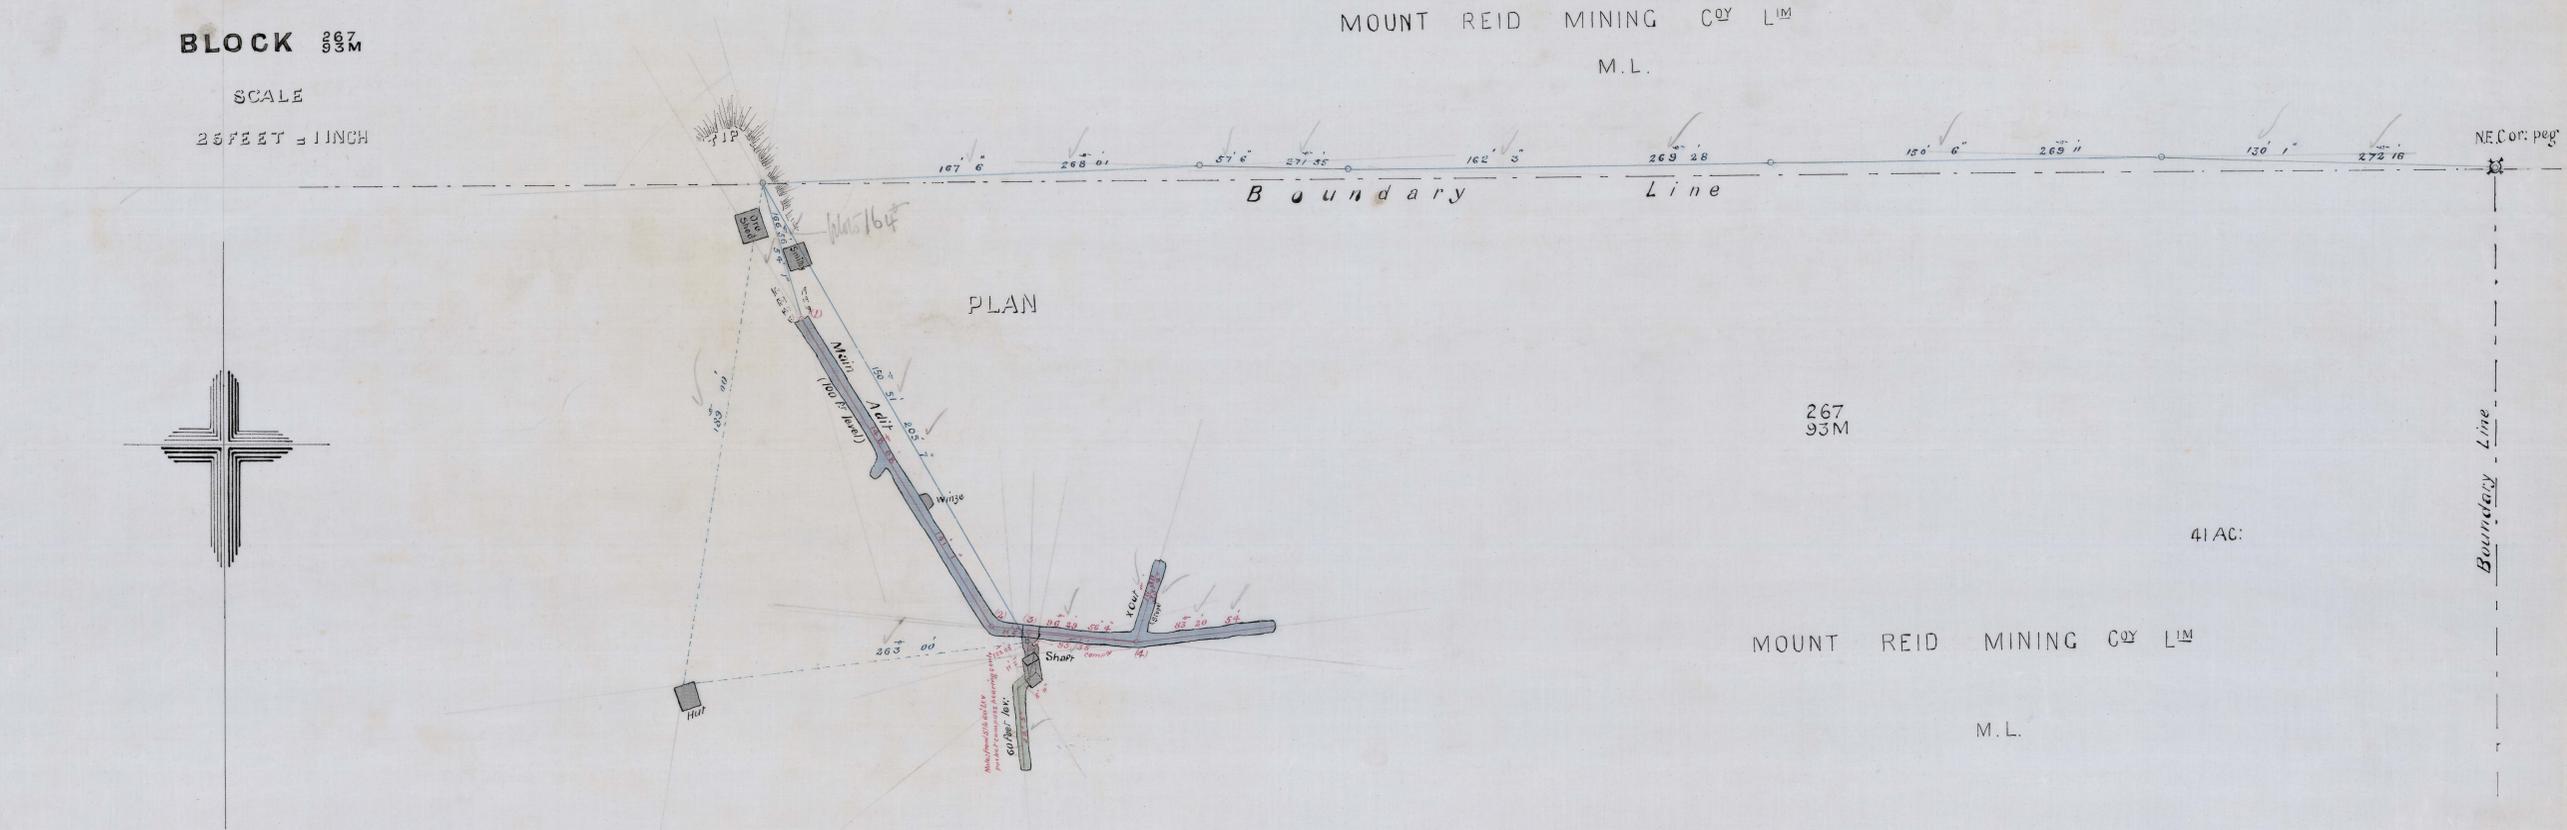

267
93M
41 AC
MOUNT REID MINING COY LIM
M.L.

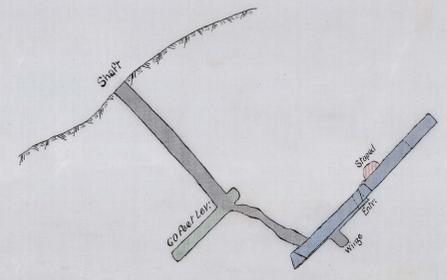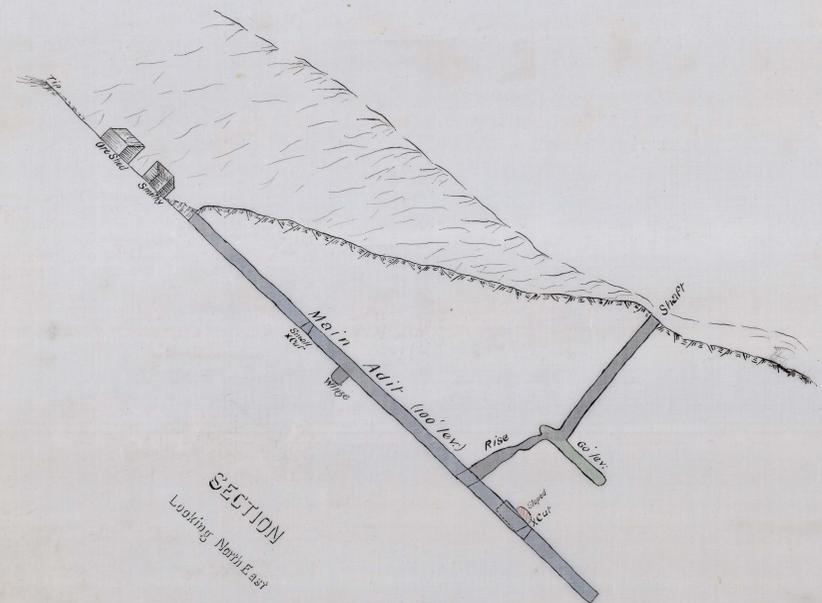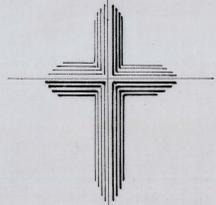

SECTION
Looking North West

Handwritten signature
District Surveyor
27.1.1900

310
205

8 cm

Handwritten notes in top left corner:
... ..
... ..
... ..