


PLAN

Mount Reid Mining Coy. Lim:


Mine Workings

Scale 25 feet = 1 inch

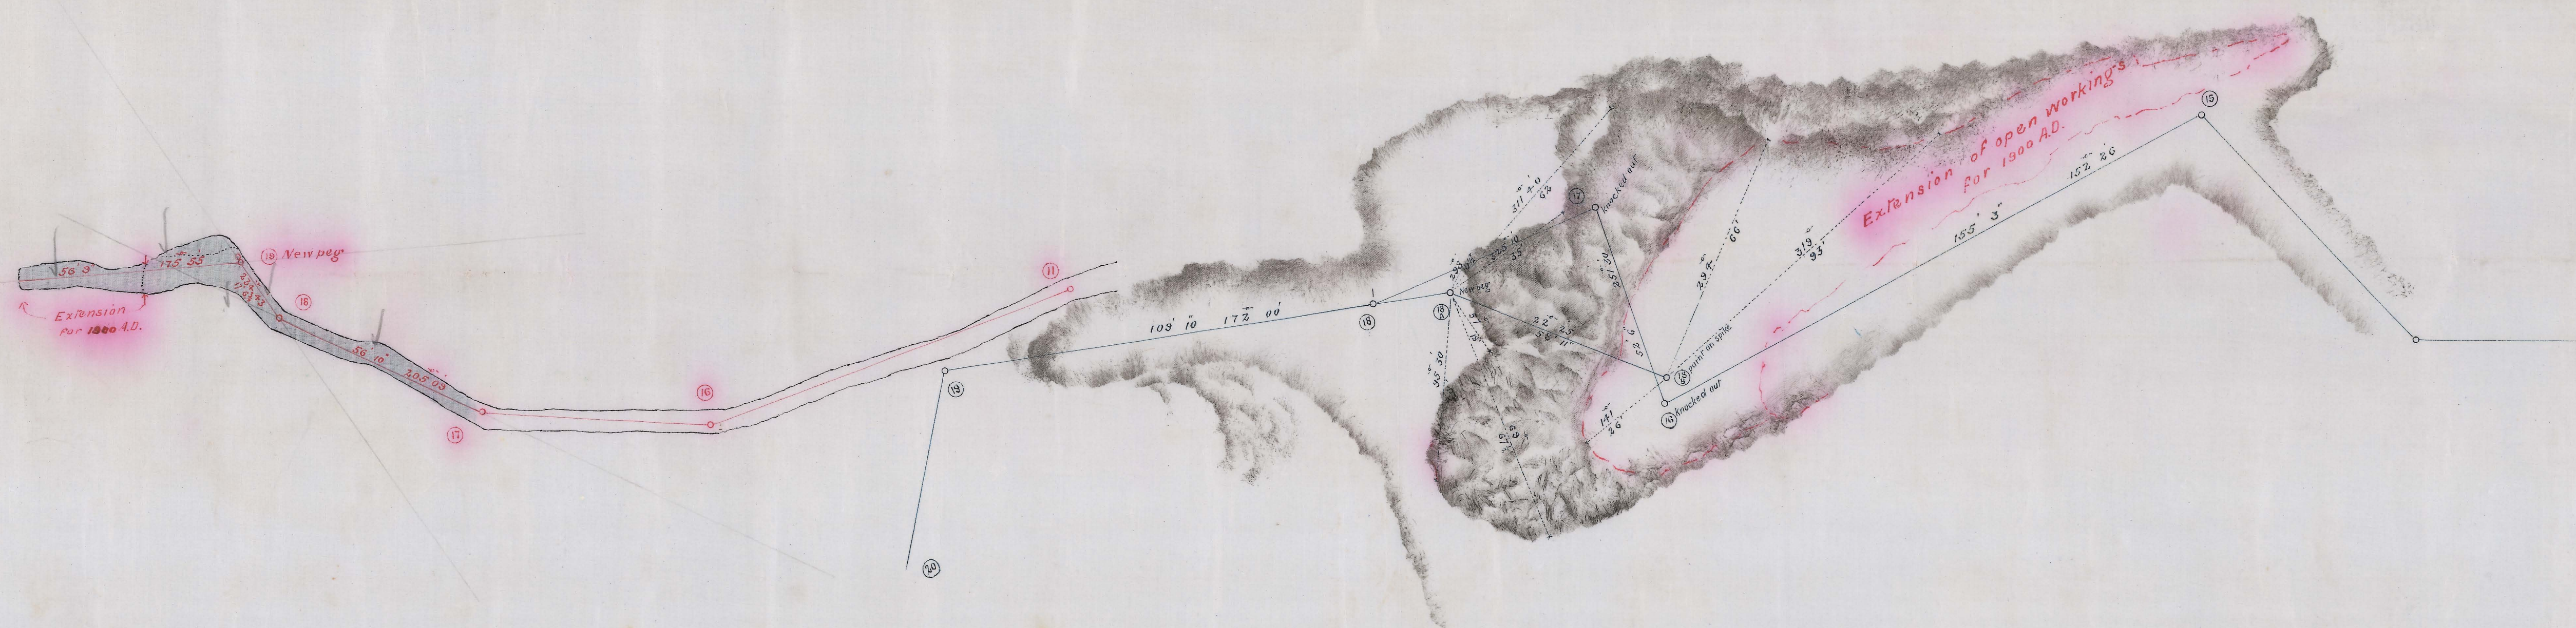

LONGITUDINAL SECTION

Looking West

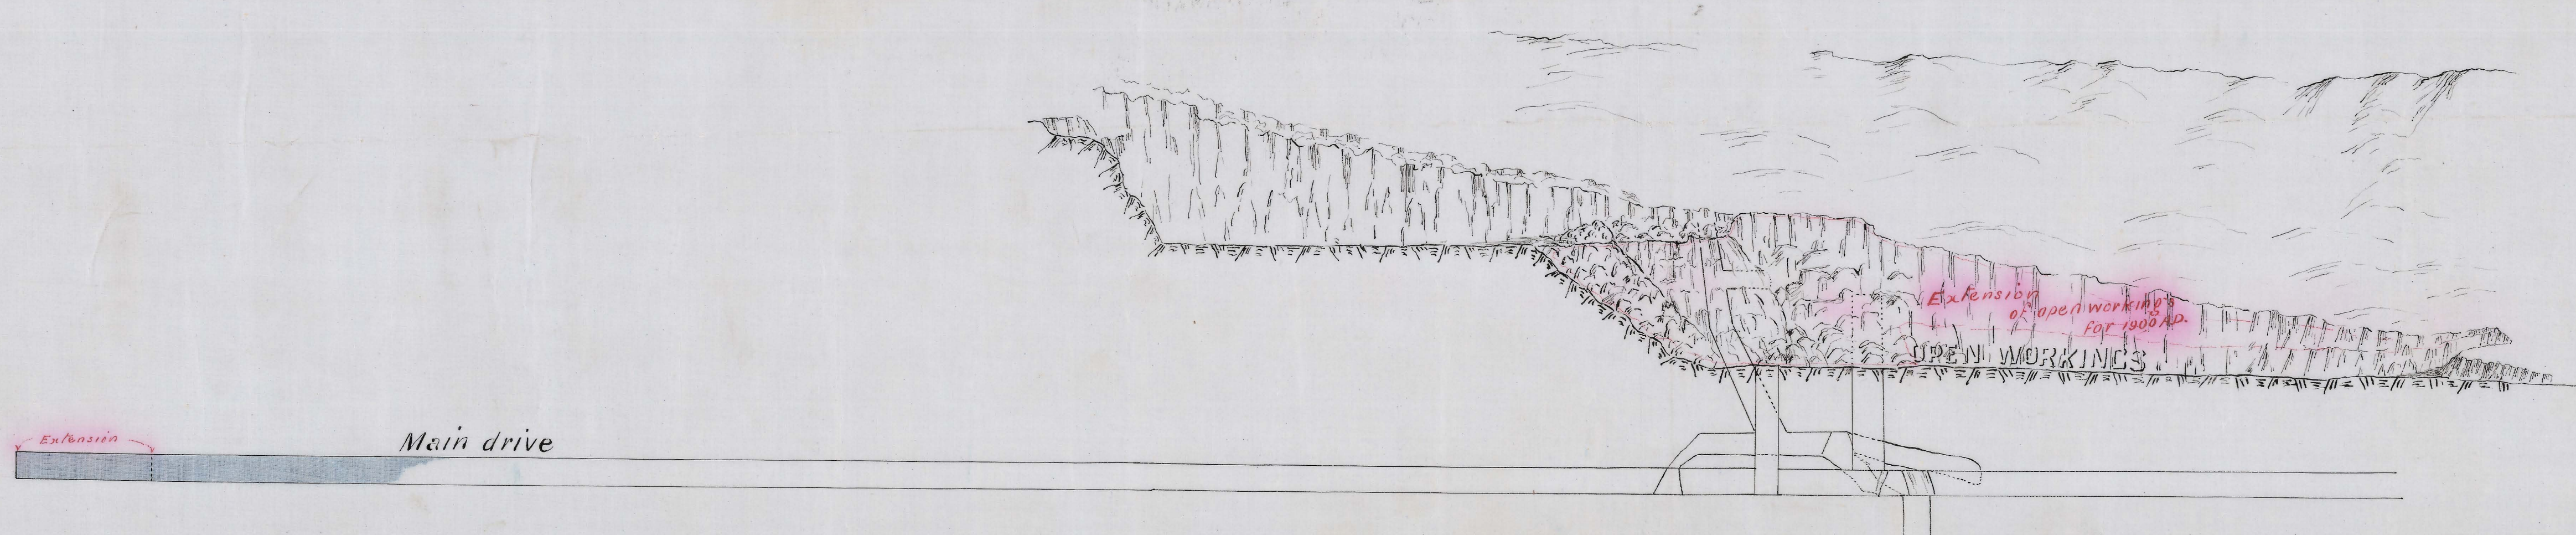

R. B. Montgomery

auth. Surveyor
Jan 13th 1901