
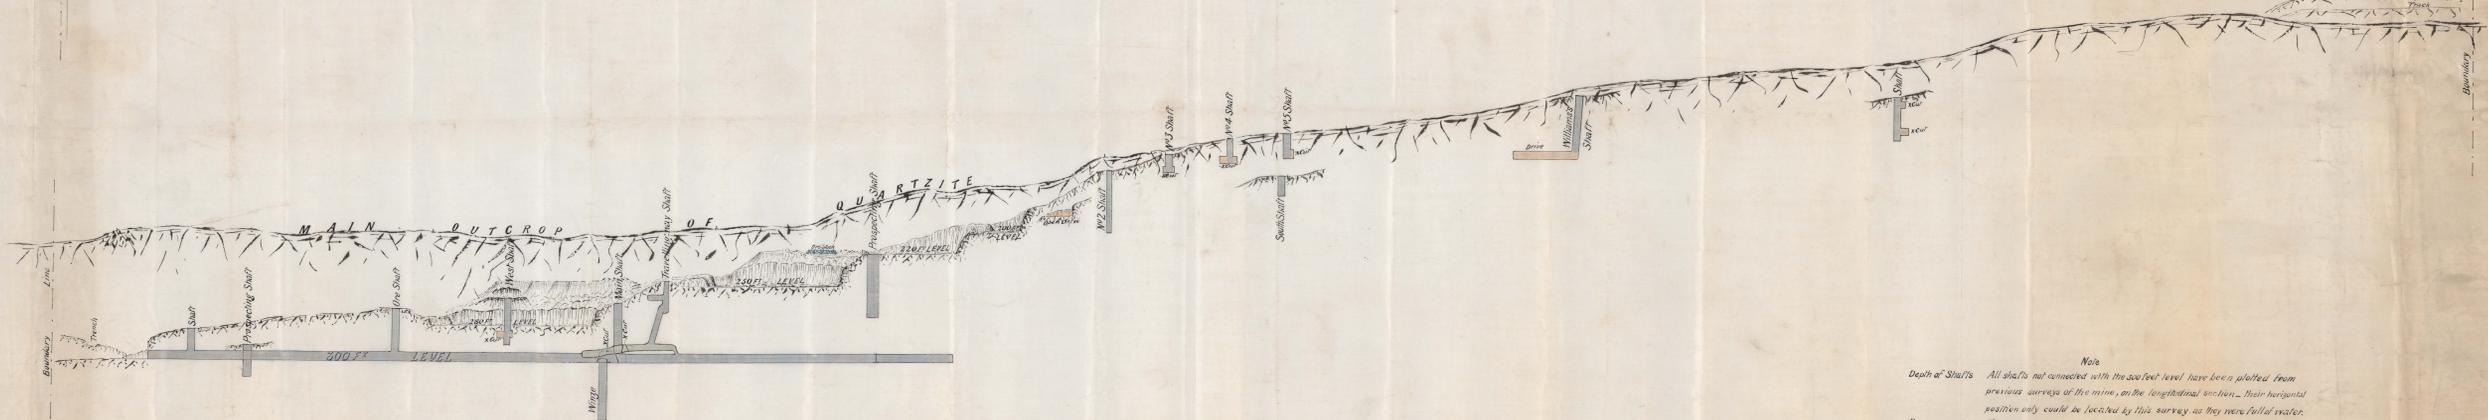


PLAN OF BLOCK 3302
87 M

MOUNT REID MINING COY. LTD.

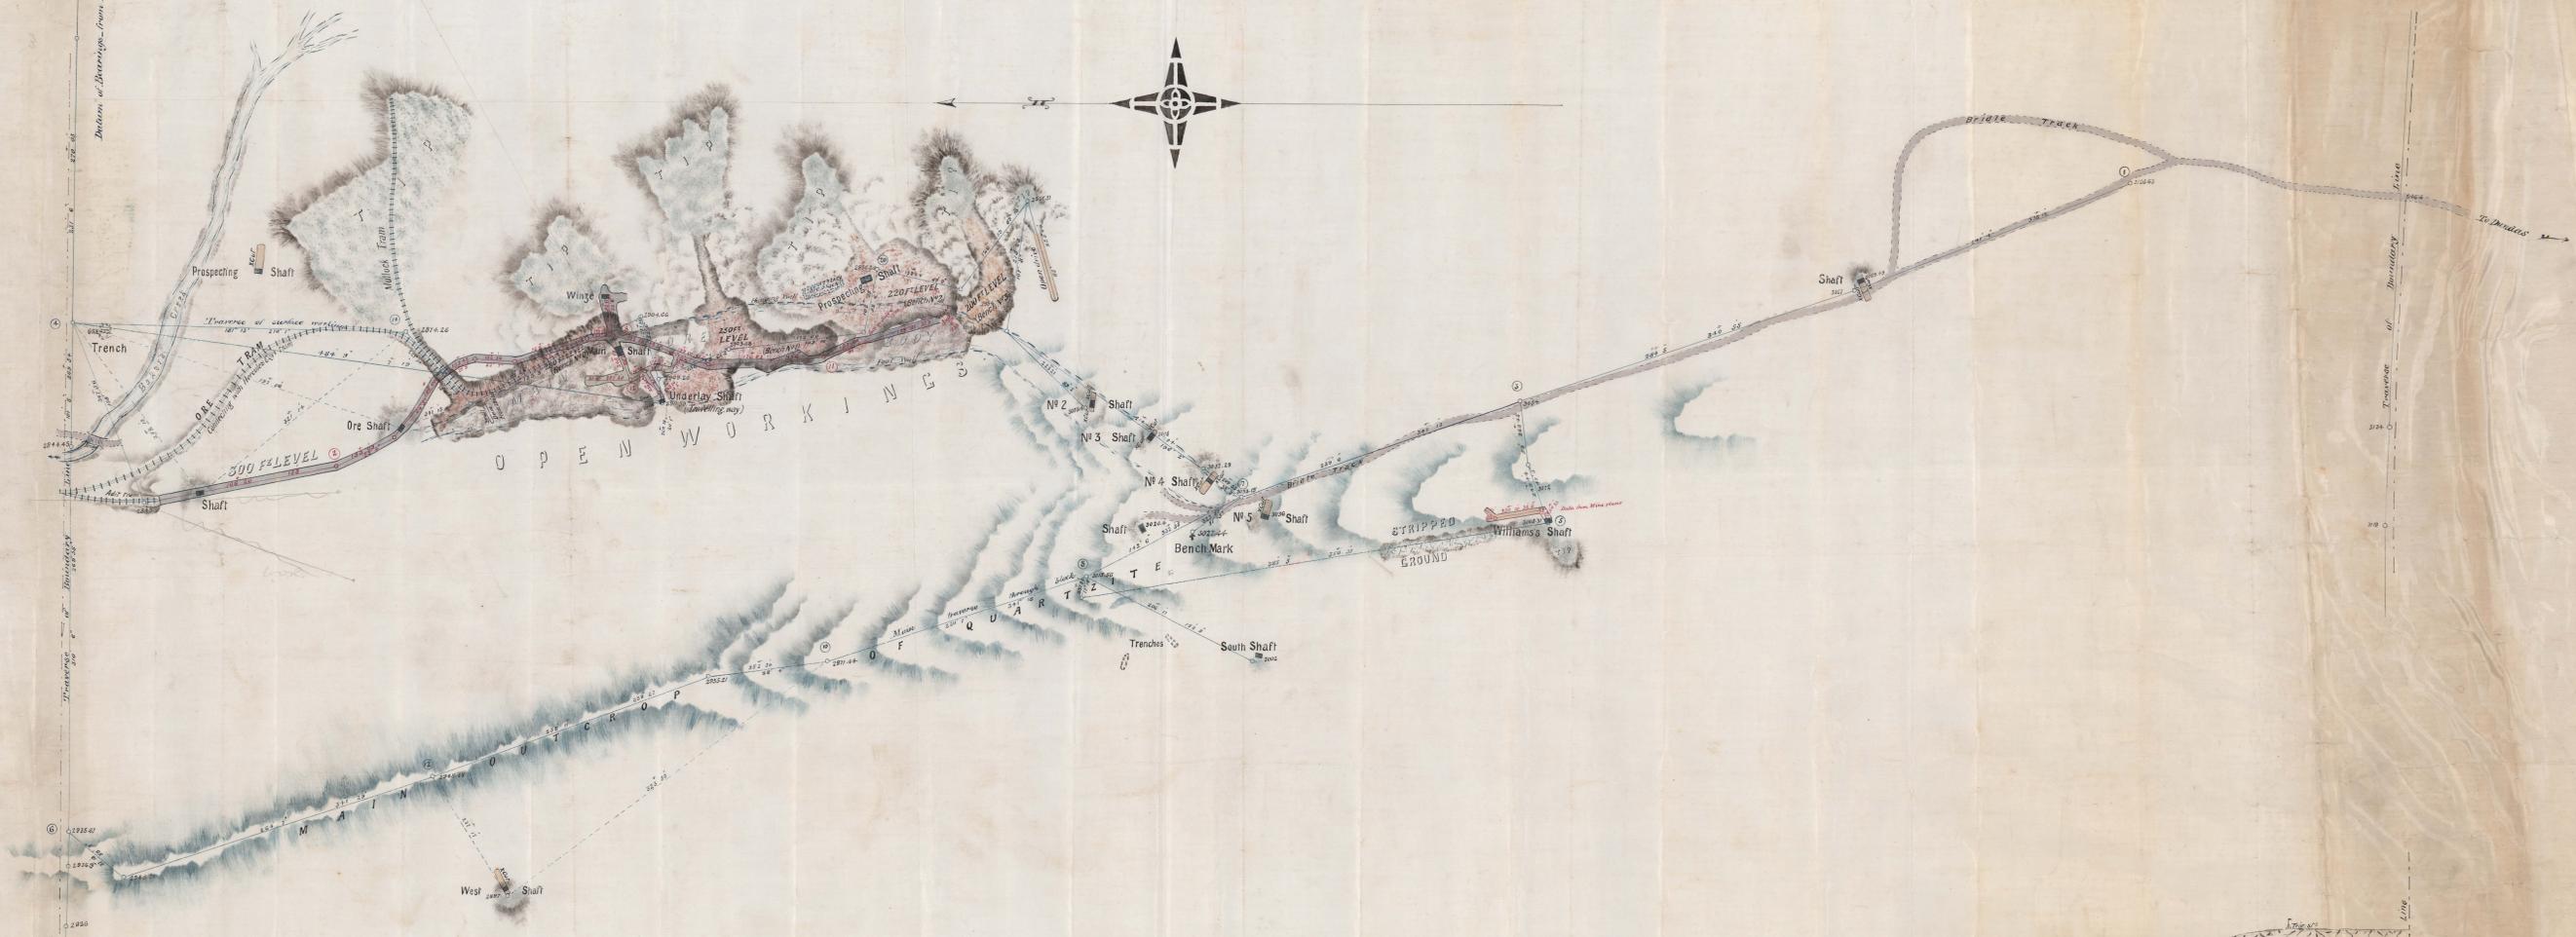

LONGITUDINAL SECTION

The projection on a plane, vertical and parallel to the North Point, of all the principal Mine Workings and of the Main Outcrop of Quartzite

Note
Depth of Shafts All shafts not connected with the 300 feet level have been plotted from previous surveys of the mine, as the longitudinal section - their horizontal position only could be located by this survey, as they were full of water.
Boundary Lines The traverse lines in blue are along the marked line - the straight dot and dash line, is the straight line joining the corner pegs.

W. H. Helms
District Surveyor
August 1897

5000
1000
500
200
100
50
20
10
5
2
1
0