


LONGITUDINAL SECTION
Looking West

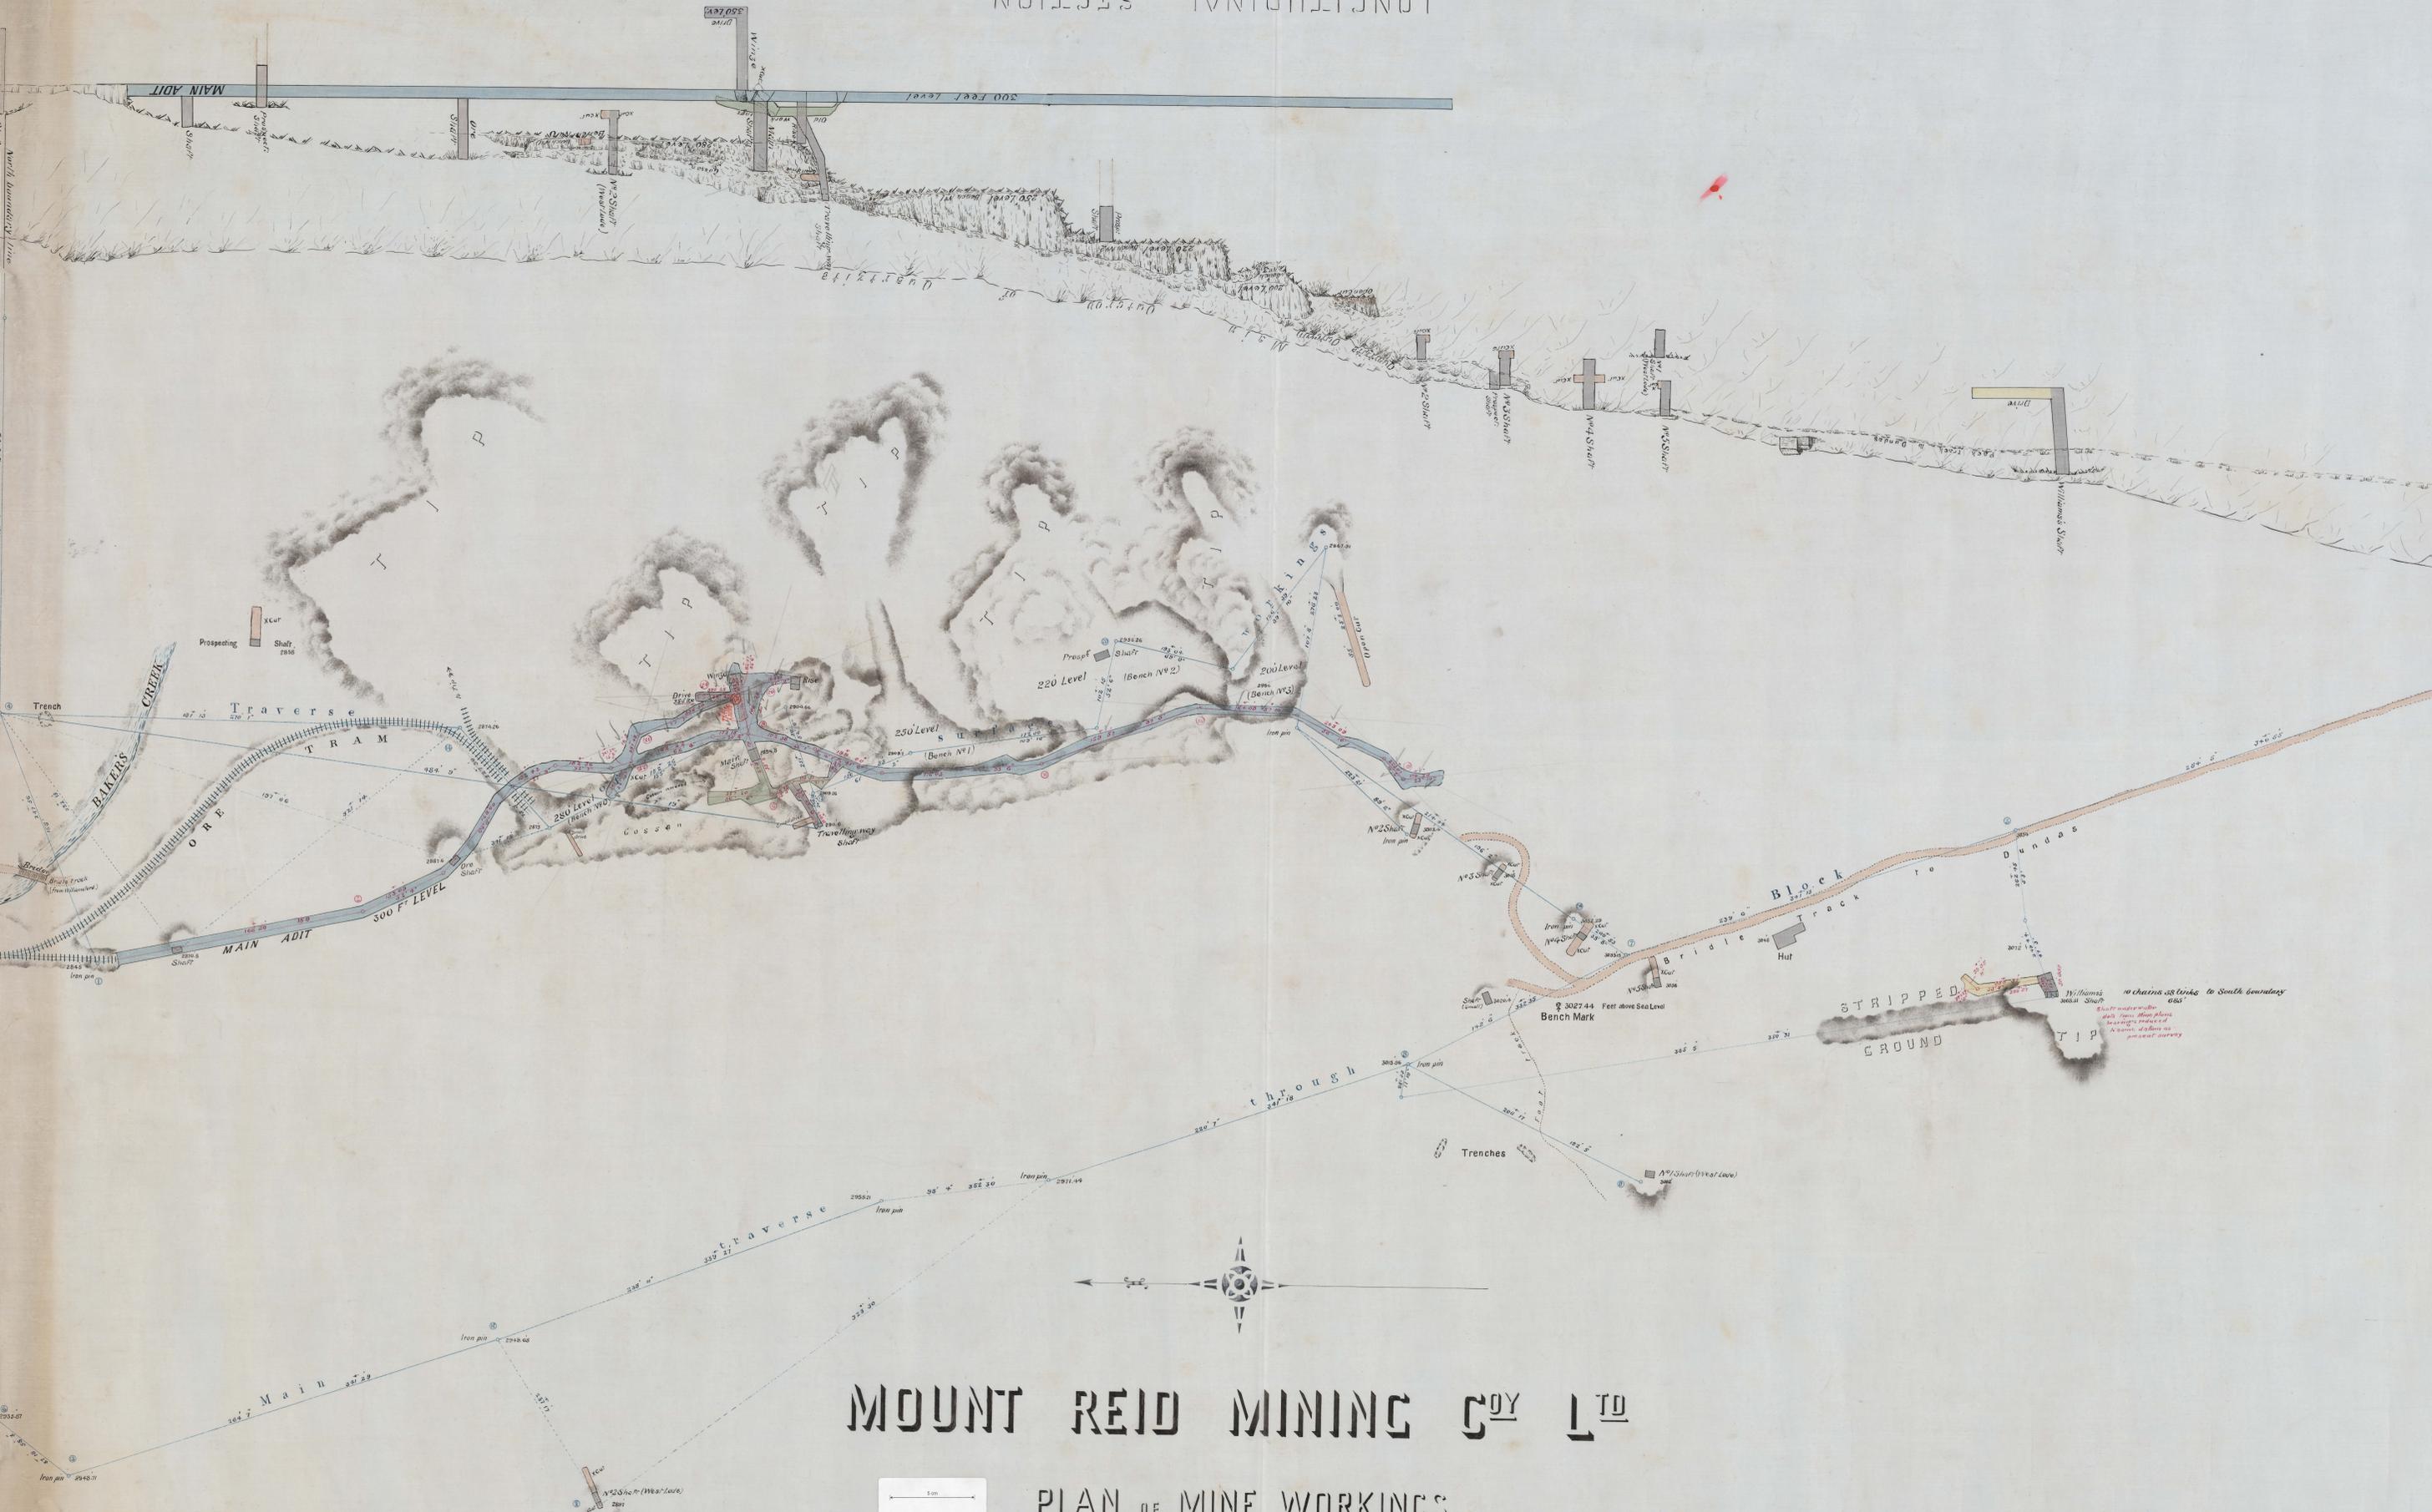

MOUNT REID MINING COY LTD

PLAN OF MINE WORKINGS

ON BLOCK 3302
37M

SCALE
25 FEET = 1 INCH

W. H. Wilson
District Engineer
27.1.1900

