


# TRANSVERSE SECTION

Looking South

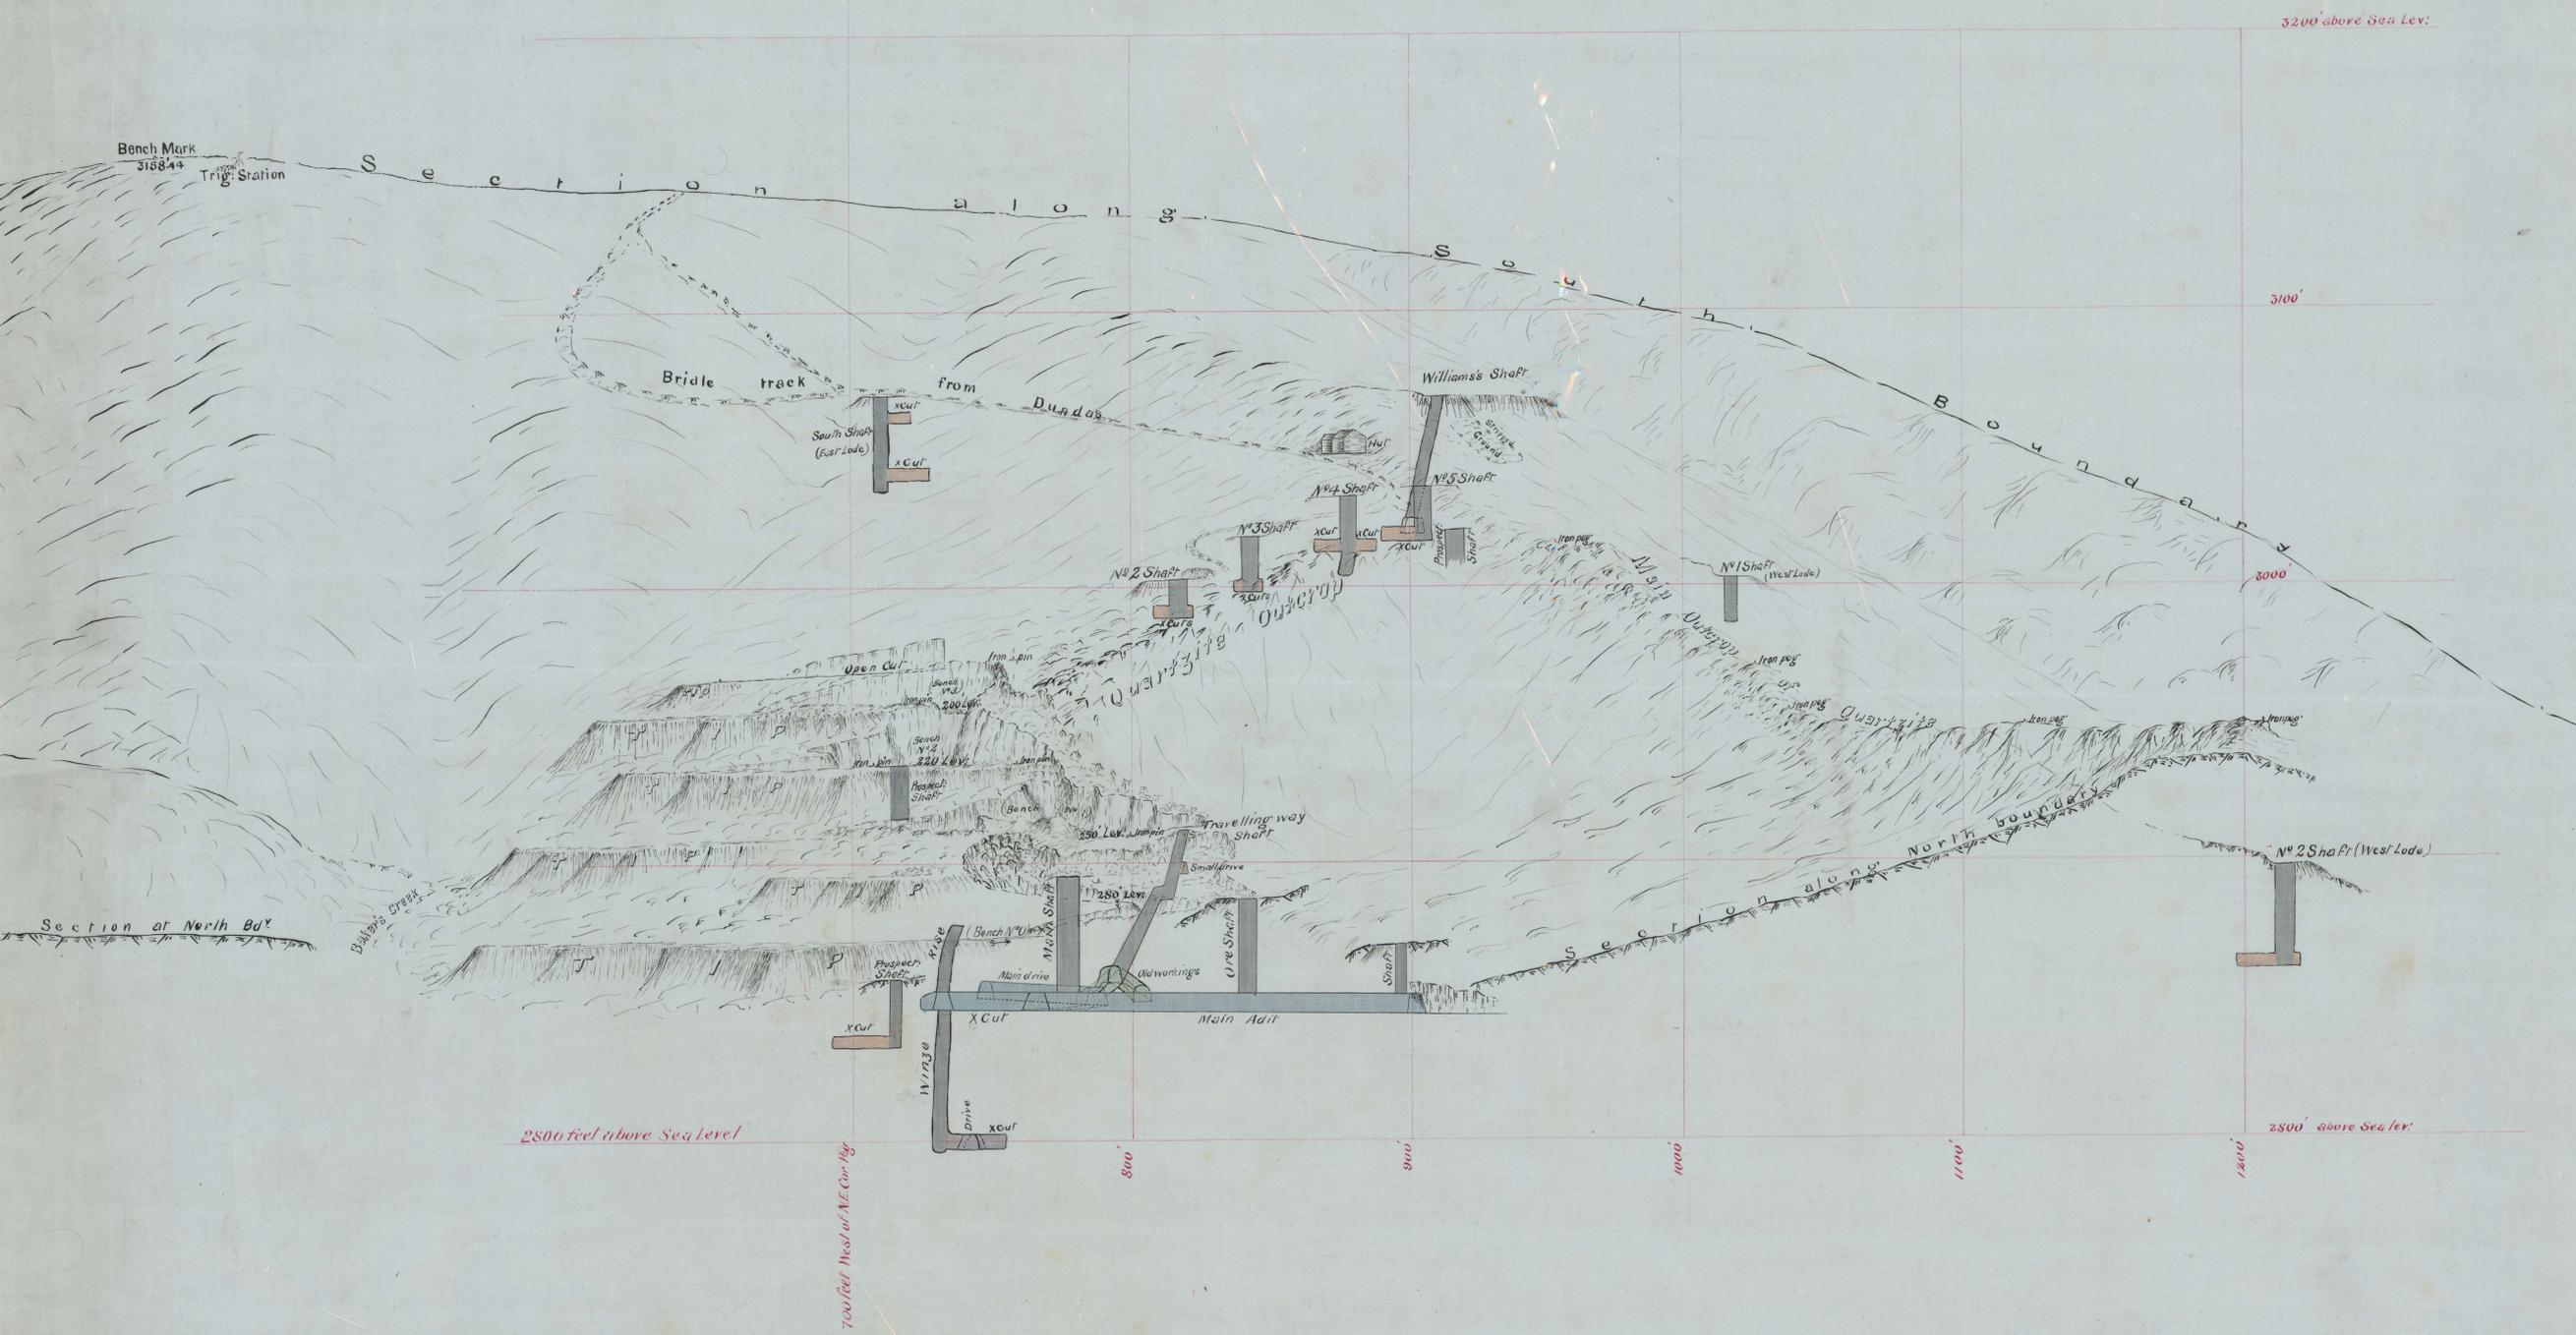

Wm. Gibson  
 District Surveyor  
 27.1.1900