

311
-01



5 cm

NORTH TASMANIAN COPPER COY. N.L.

Scale 1 inch = 40 ft.




W. H. Roberts
Mining Engineer
12/14/06

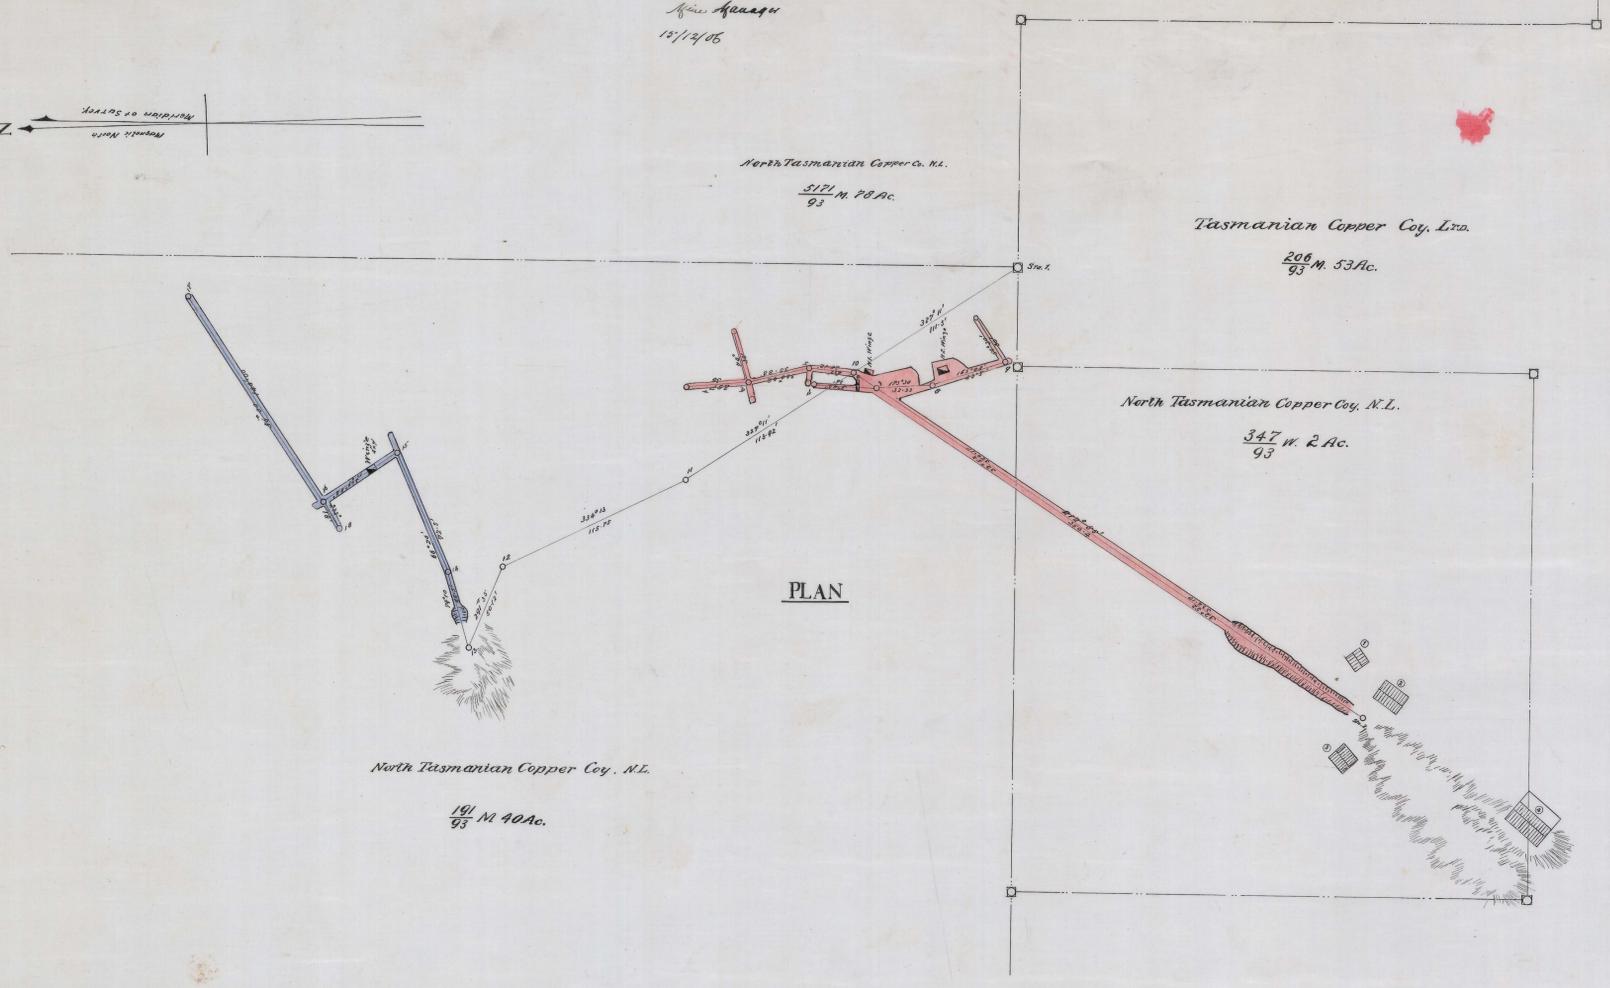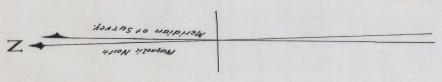

PLAN

SECTION

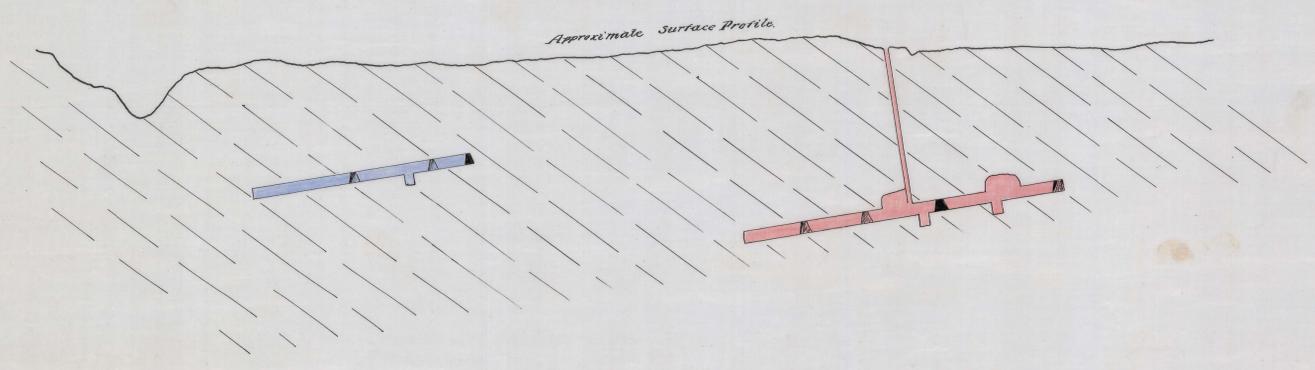

- Legend
- Instrument used
 - 5" Transit (by R.M. Street)
 - 100' Steel band.
 - N^o. 1 Funnel Coloured
 - N^o. 2 " "
 - Toolhouse
 - Timber Shed
 - Smithy
 - Orthead & Hopper

W. H. Roberts
Mining Engineer