


311
04

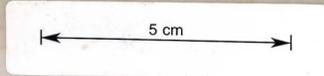

North Tasmanian Copper Co. plan sheet


UNDERGROUND WORKINGS NORTH TASMANIAN COPPER CO

NO LIABILITY

SECTION 191 - 93 M

SCALE - 25 FEET TO 1 INCH

NORTH TASMANIAN COPPER CO
MINING EASEMENT - 2 ACRES

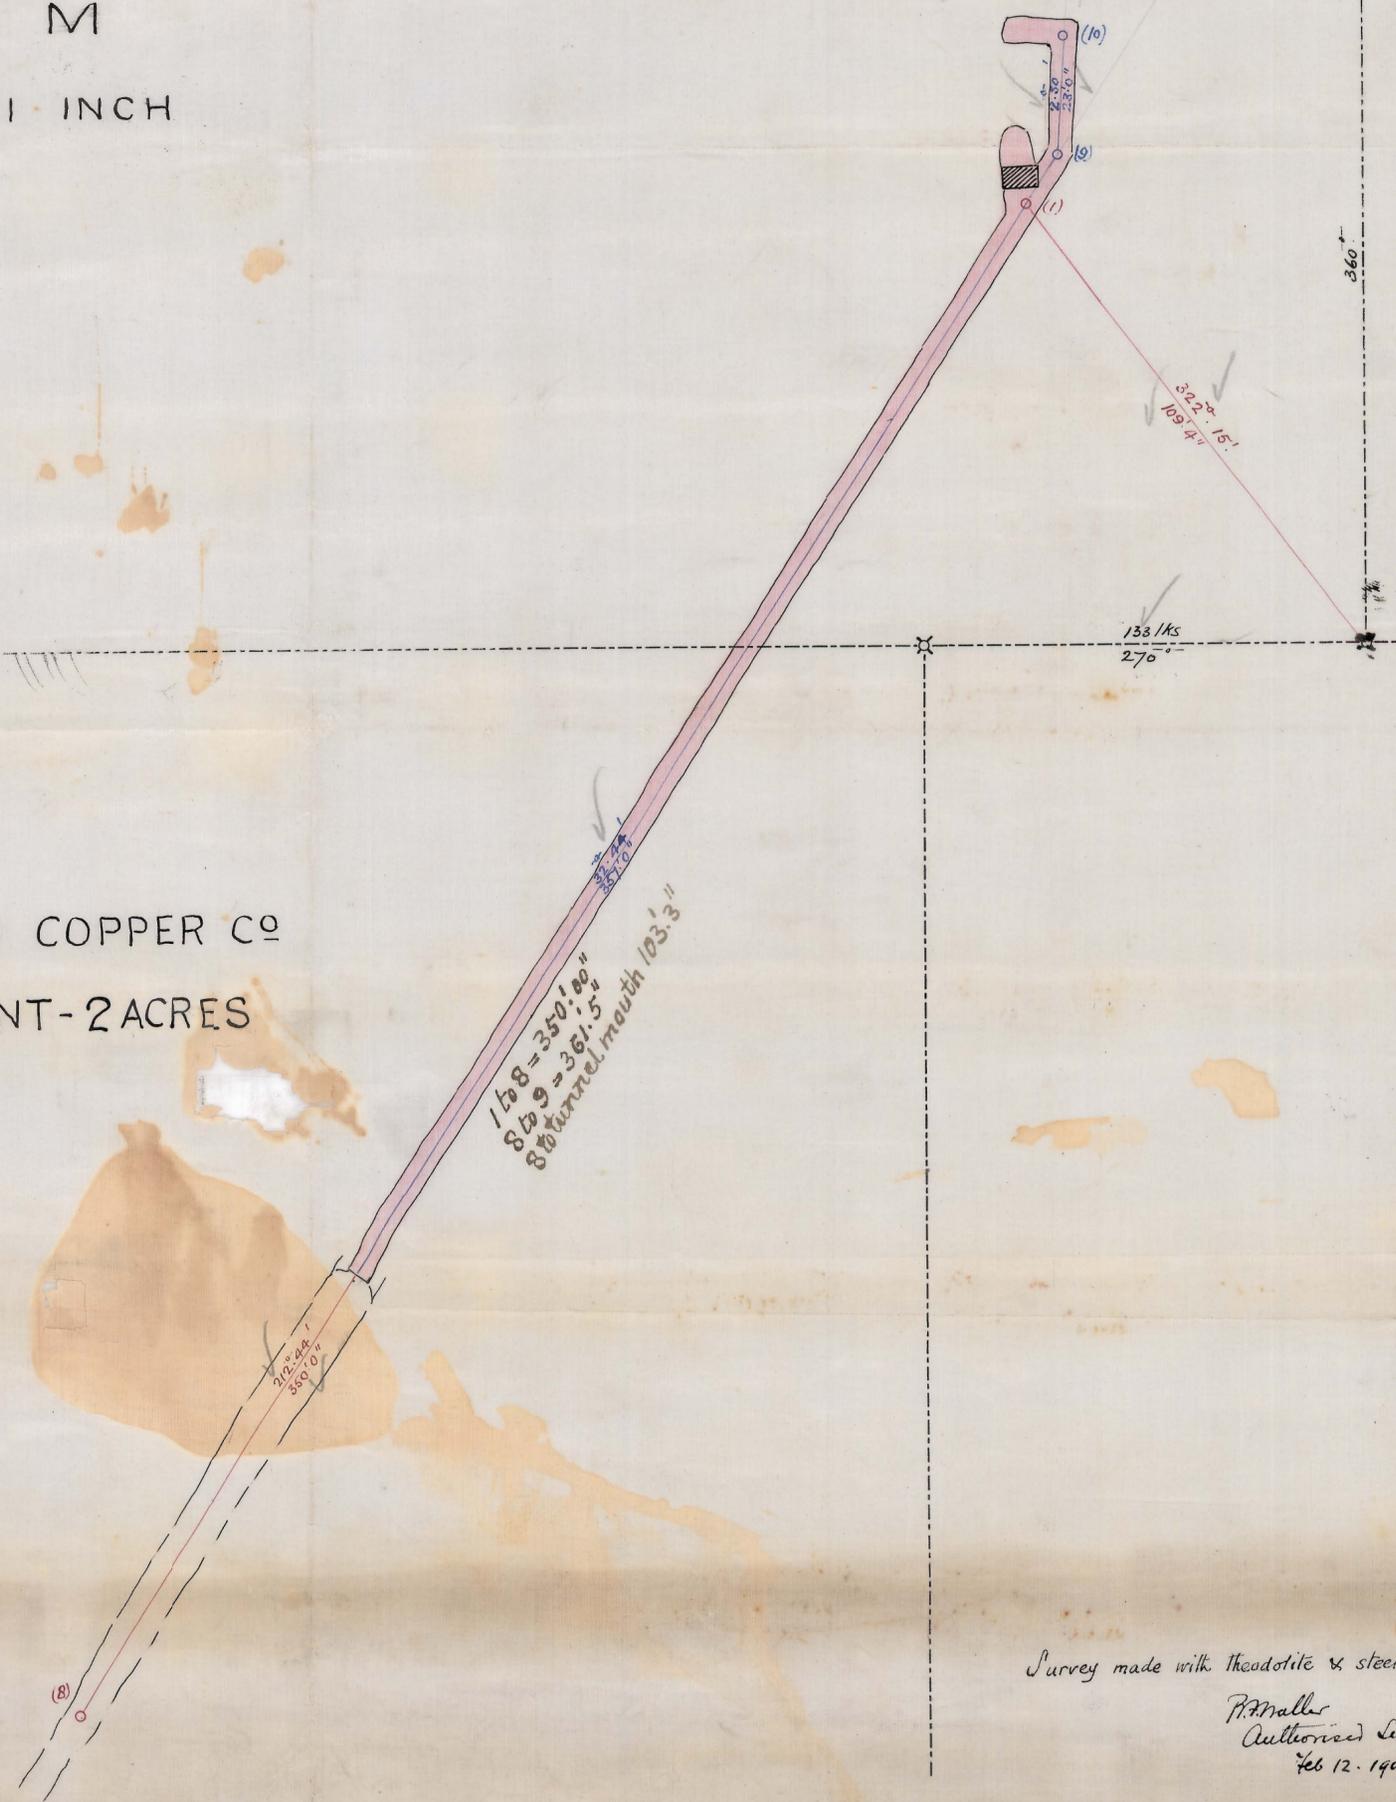

*Survey made with theodolite & steel band
R. Muller
Authorized Surveyor
Feb 12. 1900*

North Tasmanian Copper Co. plan sheet