


311
-05

5 cm

NORTH TASMANIAN COPPER CO

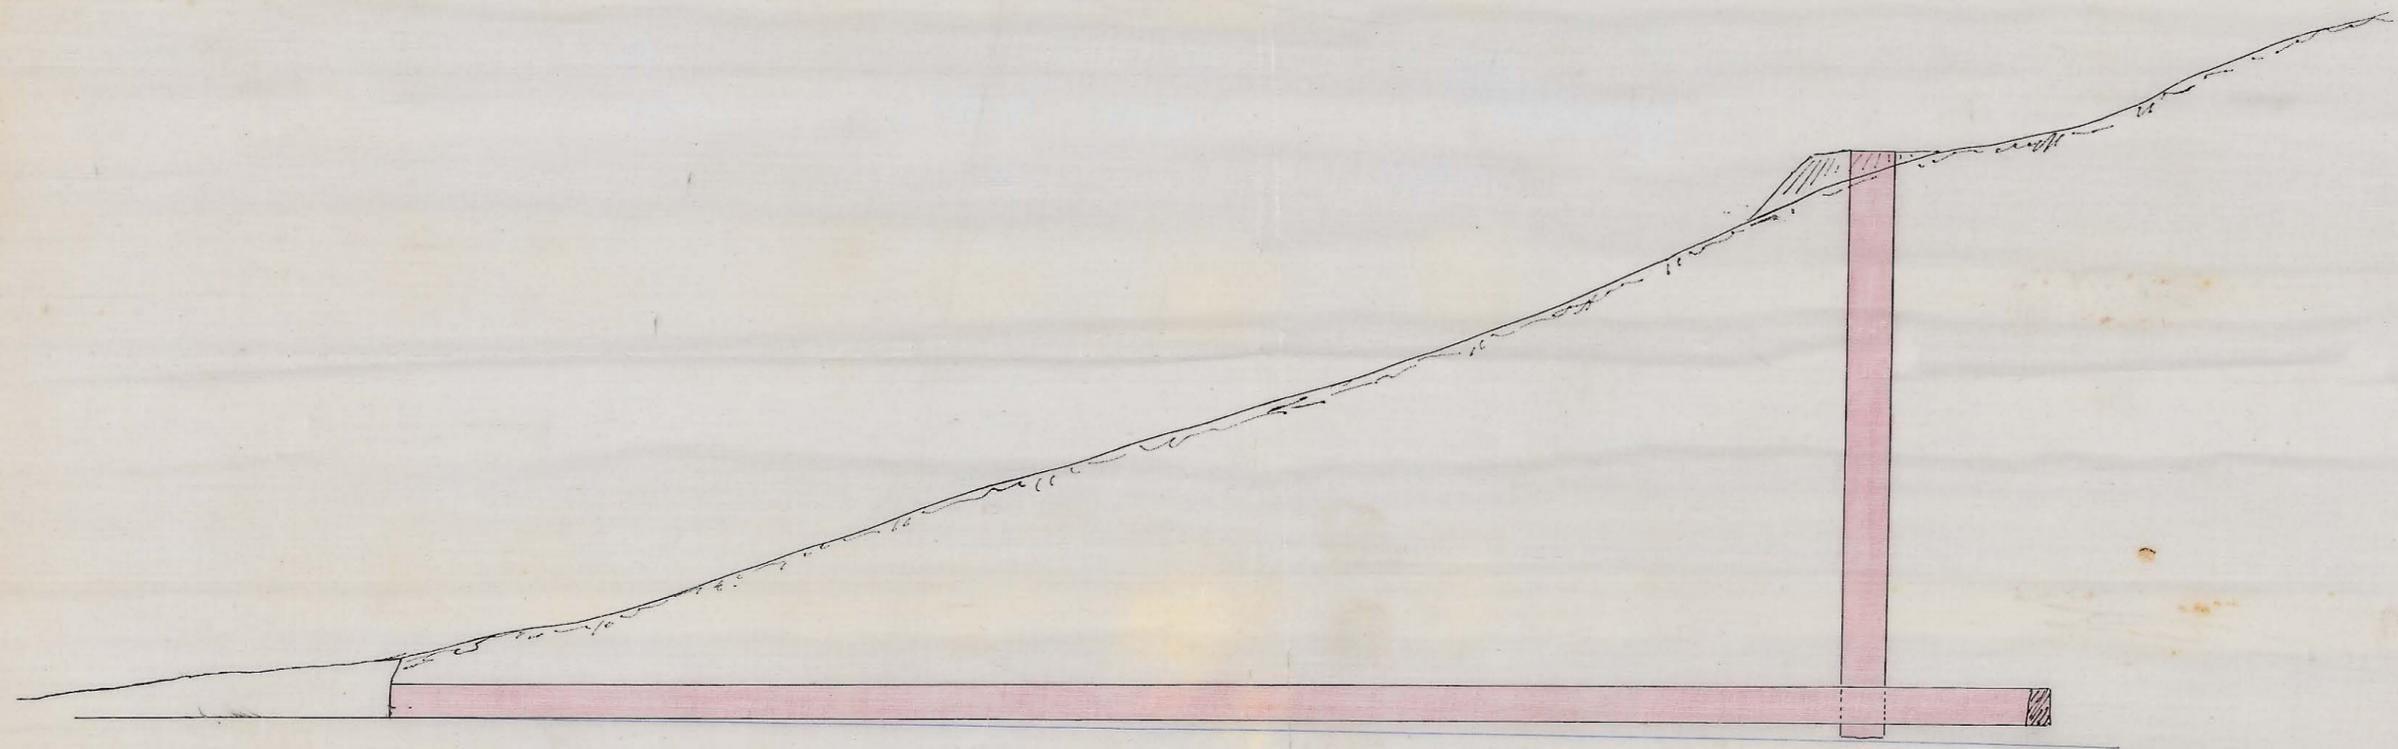

SECTION ON LINE OF TUNNEL

P.A. Waller
Authorized Surveyor
Feb 12. 1900