
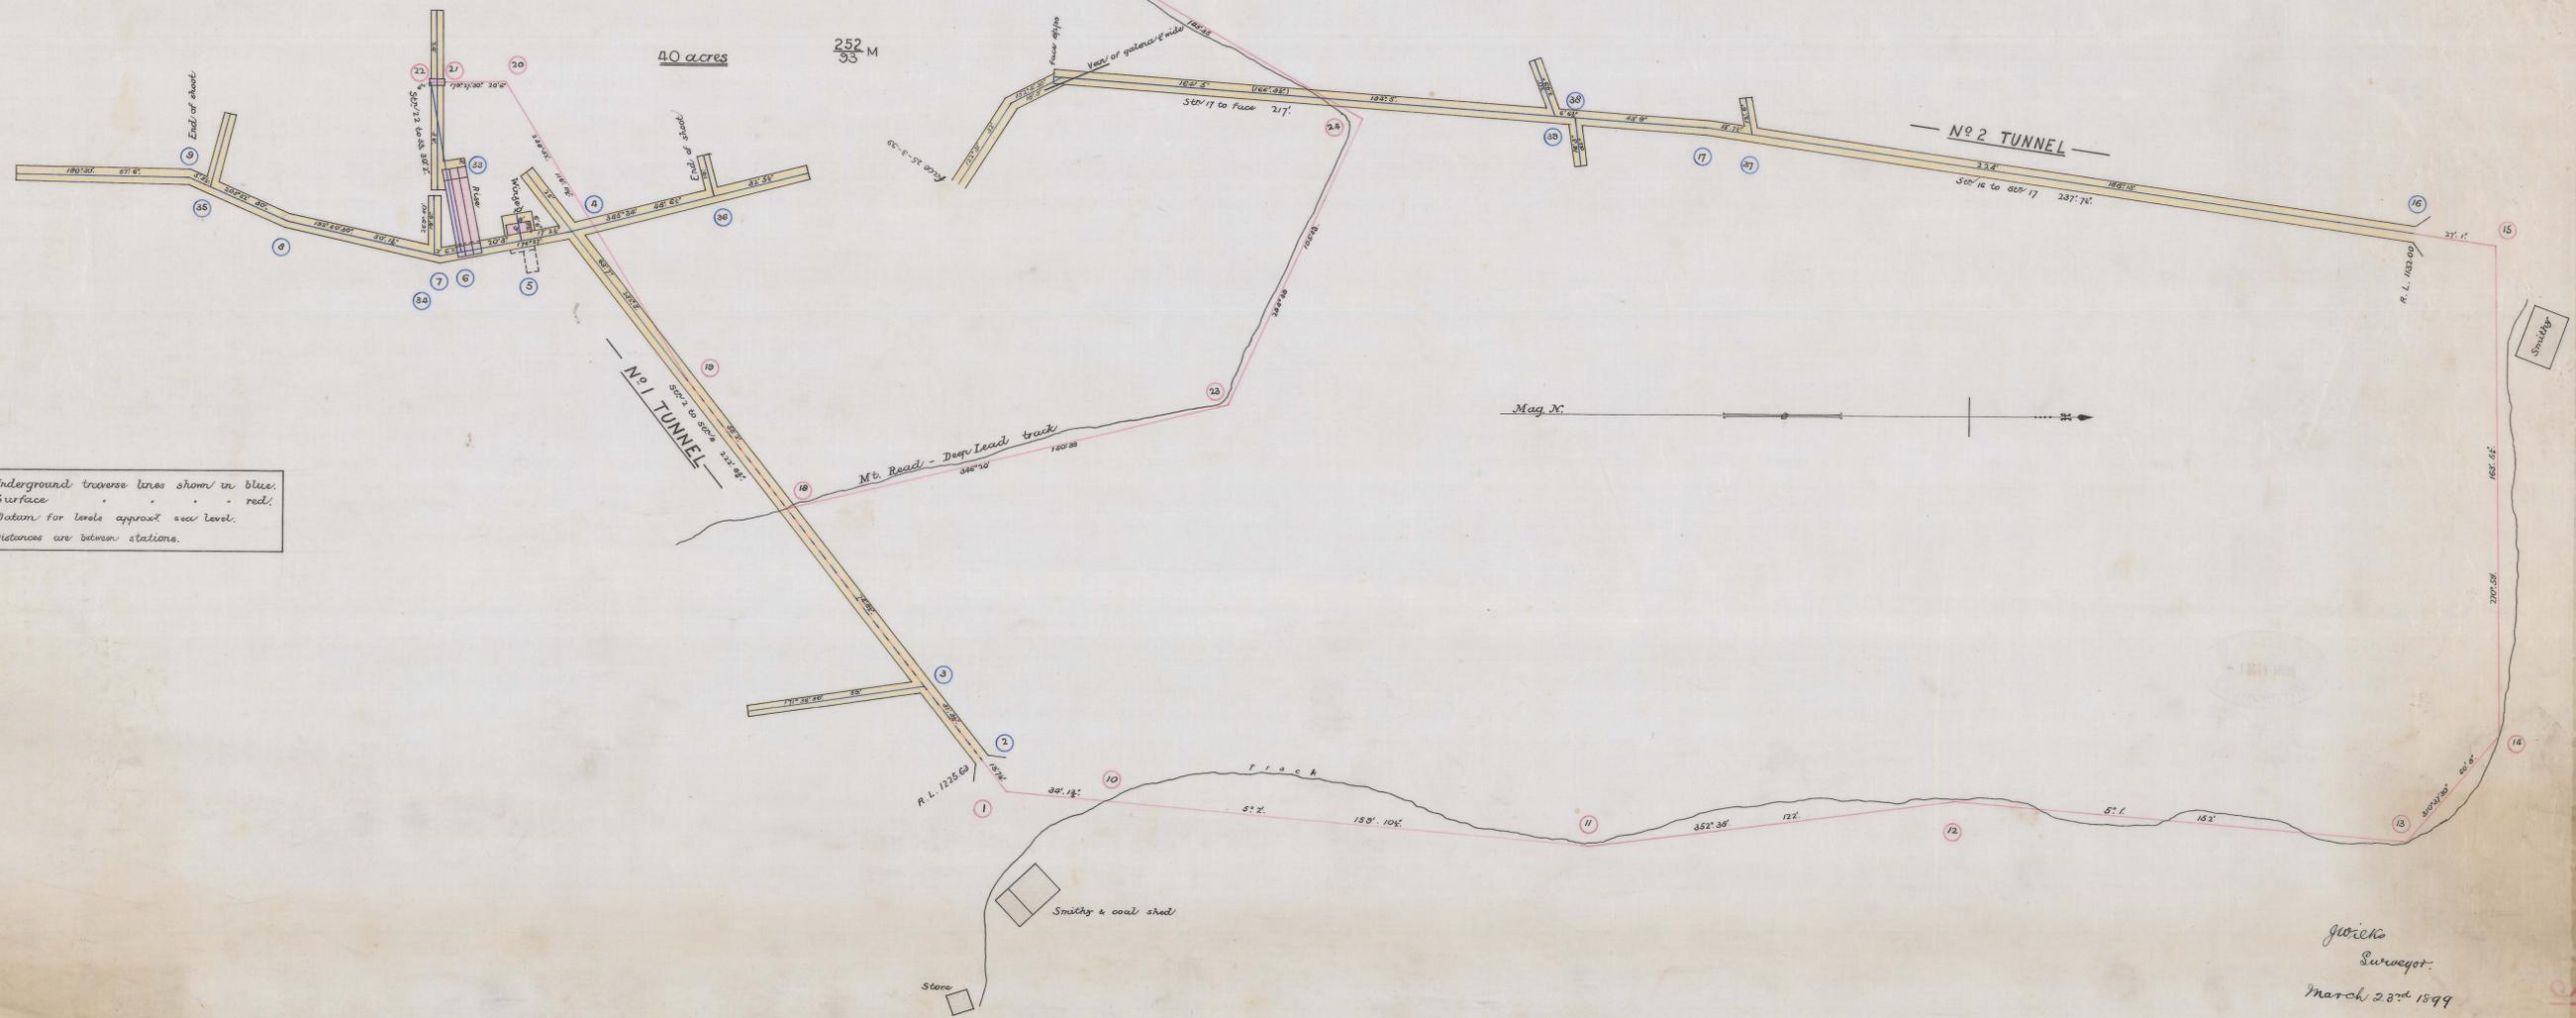
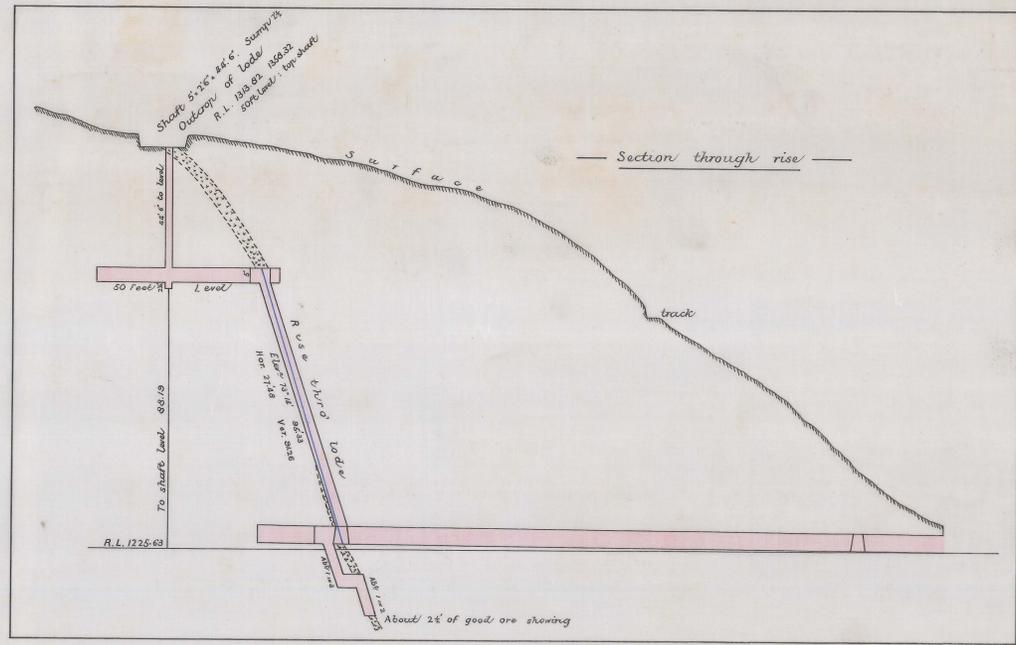


Handwritten notes in the top left corner, including "1899" and other illegible text.

RINC RIVER P.C. (Lately purchased by the Tasmanian Copper Co^y Ltd.)

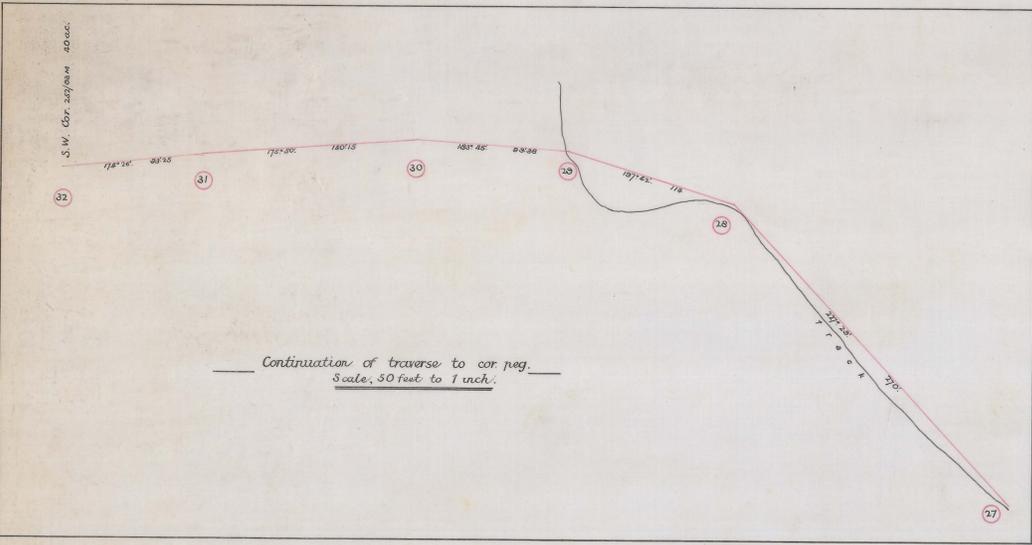

Note Underground traverse lines shown in blue.
Surface red.
Distances for levels approx area level.
Distances are between stations.

John
Surveyor.
March 23rd 1899

Handwritten notes on the right margin, including "p 81" and other illegible text.



312
02