



382 05

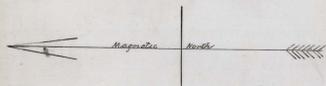

5 cm

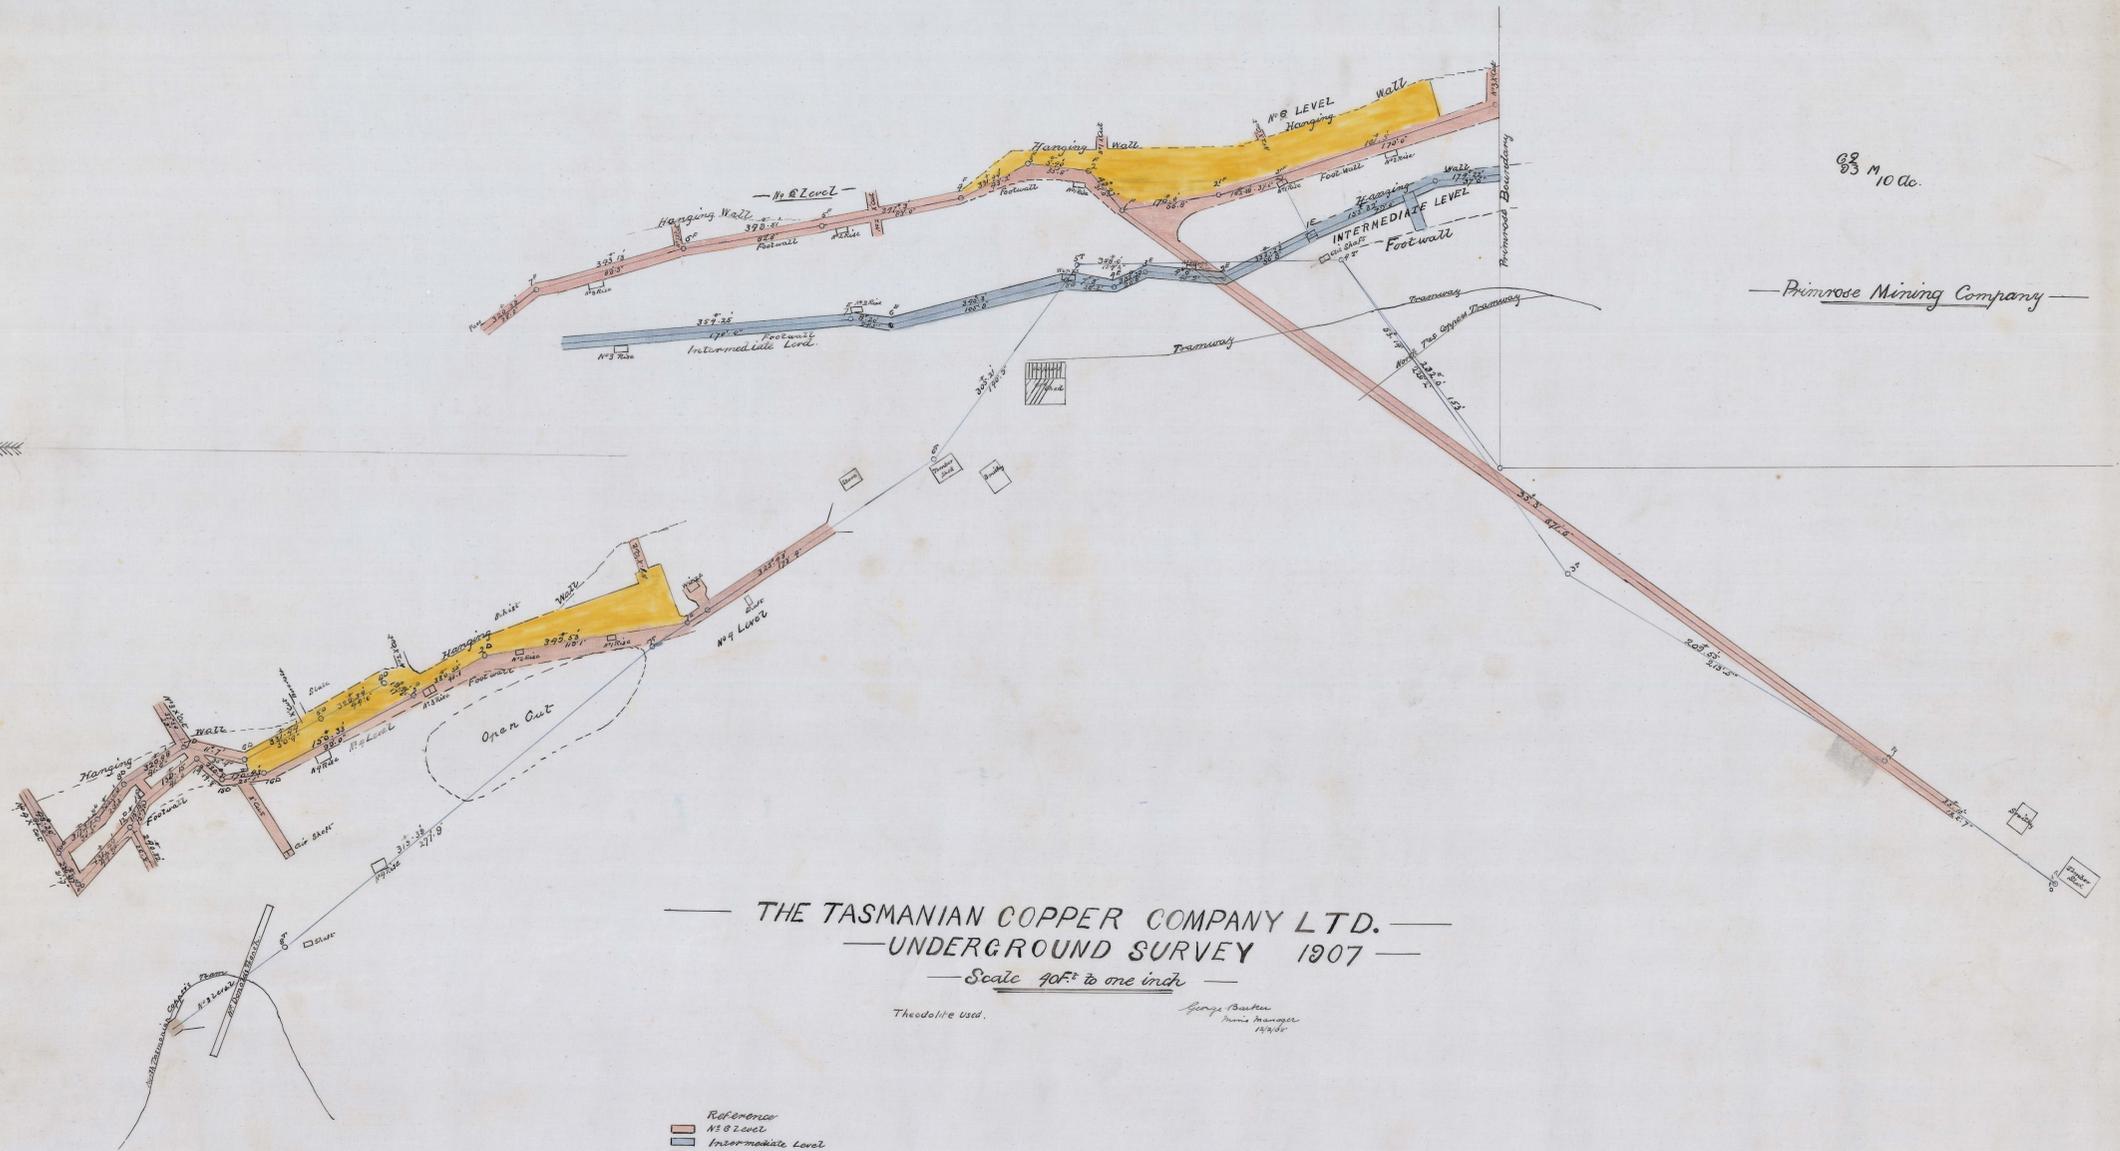

68
63 M 10 do.

— Primrose Mining Company —

— THE TASMANIAN COPPER COMPANY LTD. —
 — UNDERGROUND SURVEY 1907 —

— Scale 40' to one inch —

Theodolite used. George Baskin
 Survey Manager
 1906

- Reference
- No. 8 Level
 - Intermediate Level
 - No. 9 Level
 - M. S. Level
 - Ground Stoped

