


Sheet 2

95  
93 M  
ML.  
22 ac.

59  
93  
C.L.  
10 ac.

60  
93  
C.L.  
10 ac.

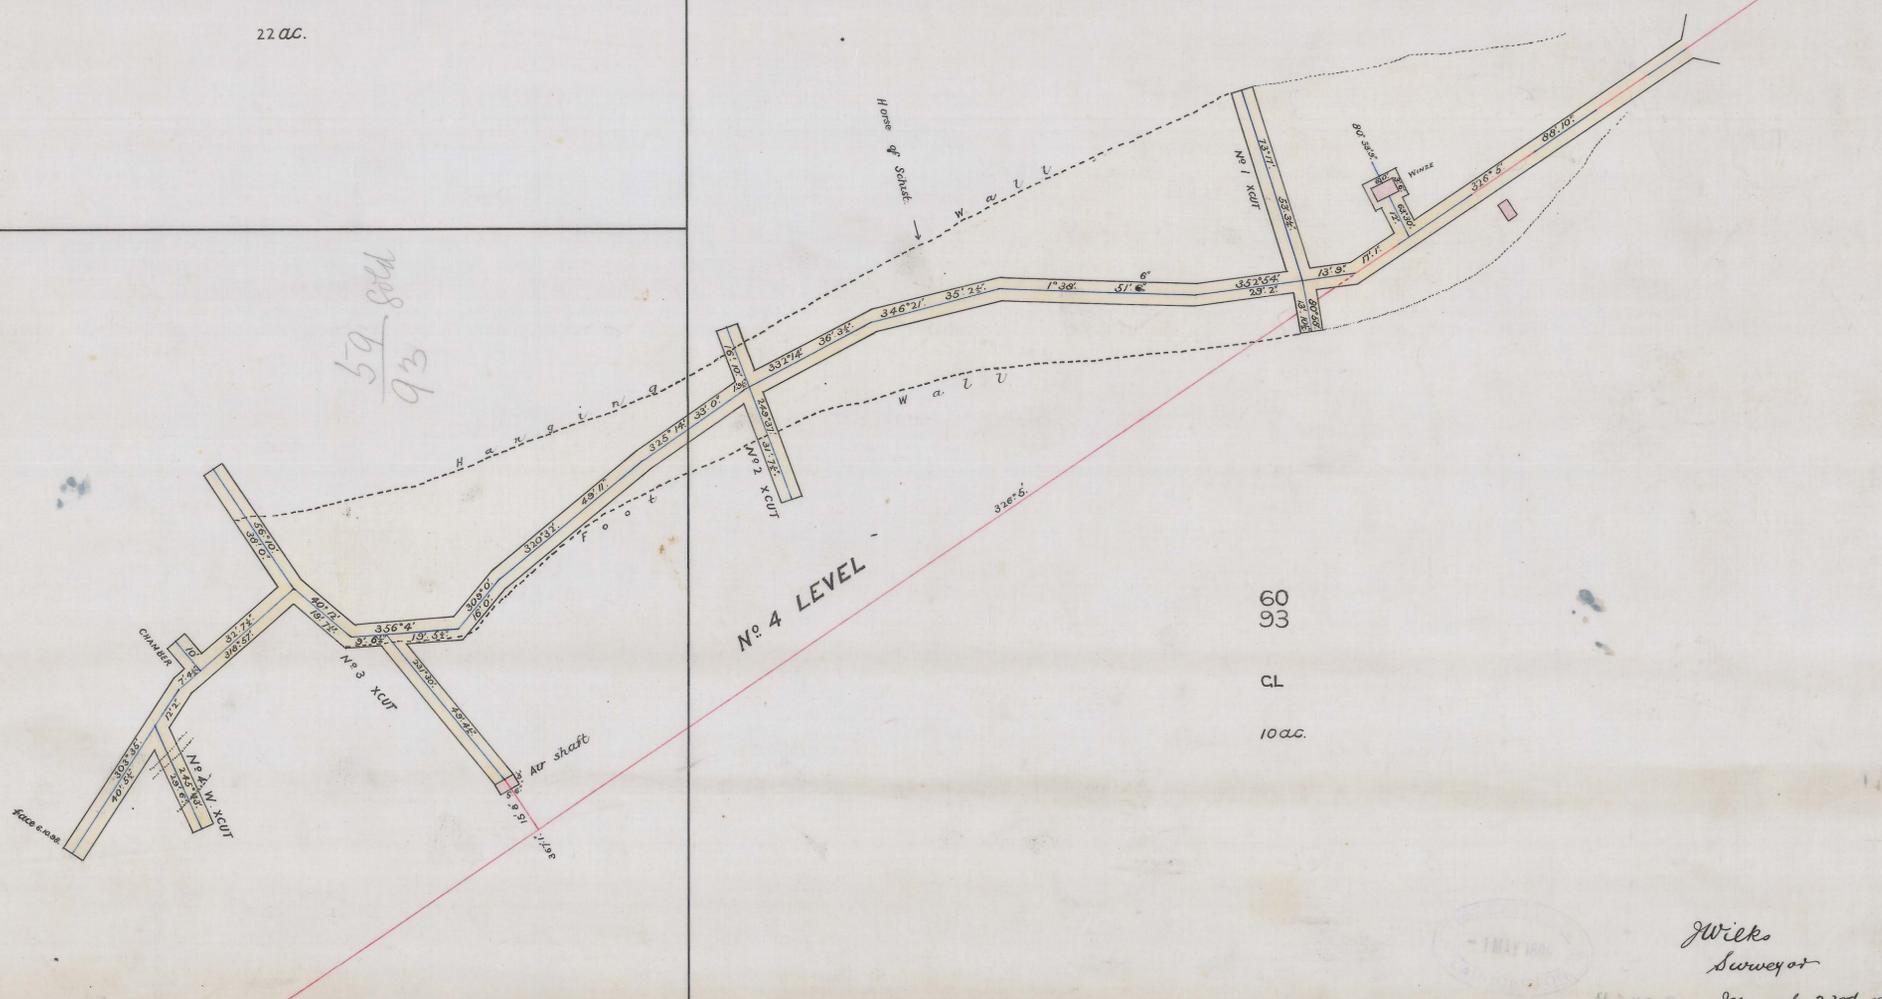

59-800  
93

No. 4 LEVEL

Wills  
Surveyor  
March 23rd 1899.