



# TASMANIAN COPPER COY. LIM.

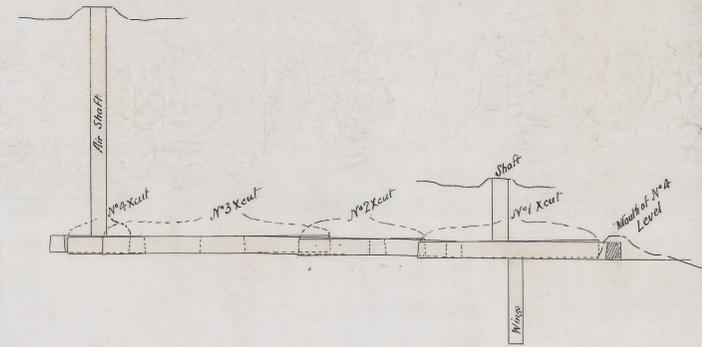

PROJECTION ON EAST AND WEST PLANE

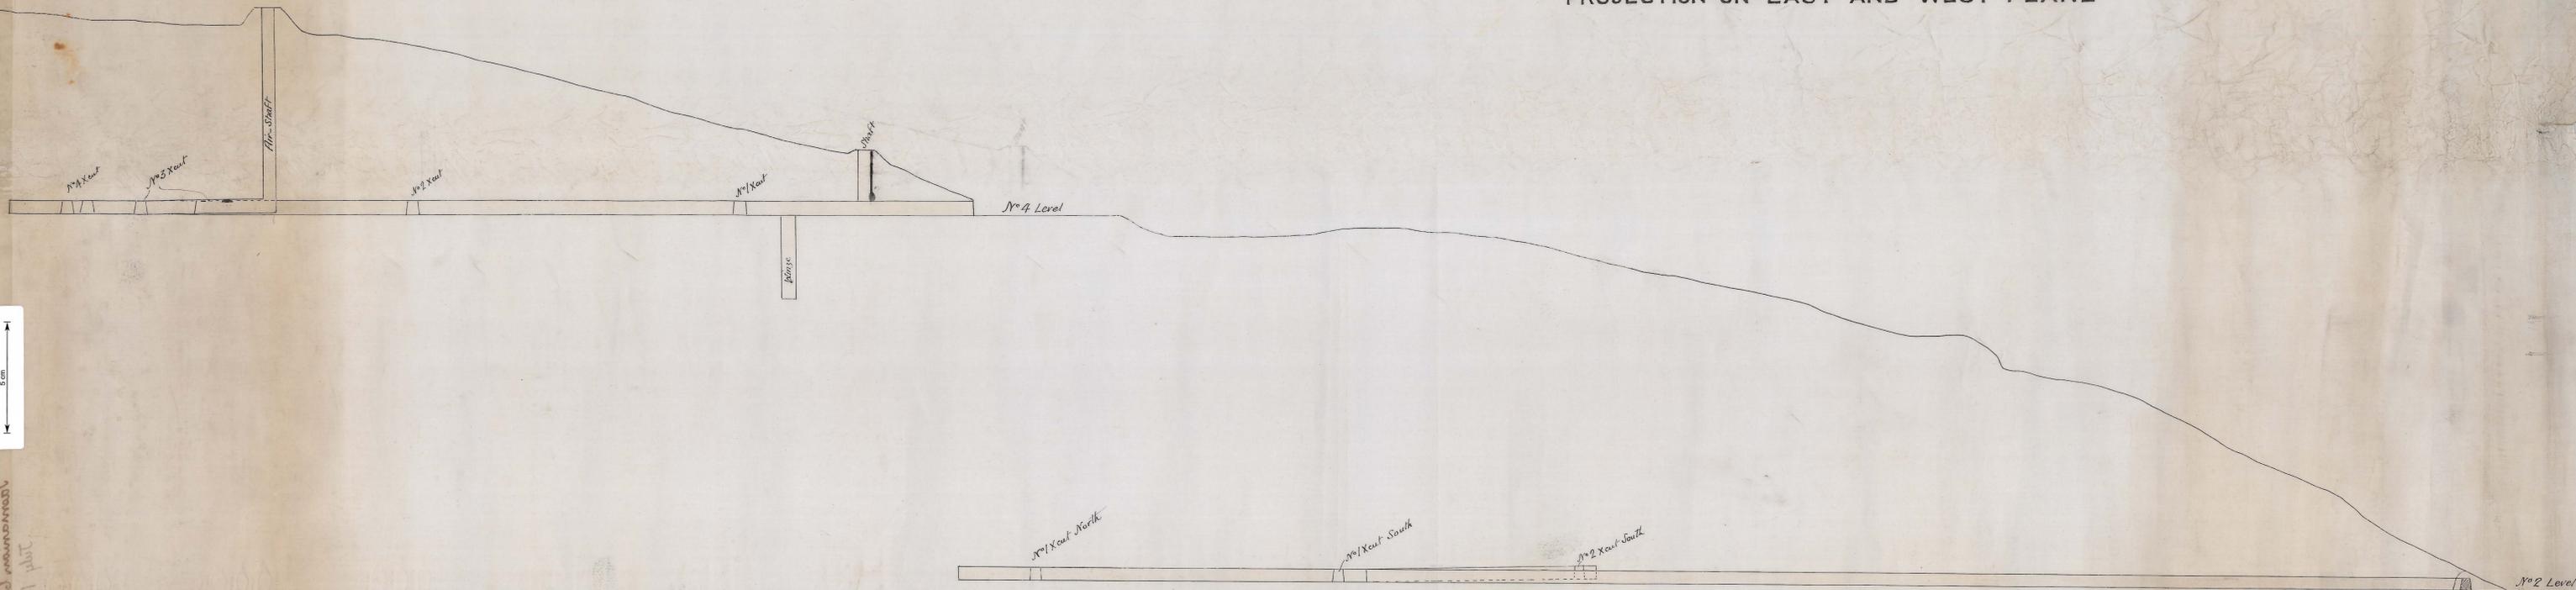

PROJECTION ON NORTH AND SOUTH PLANE

Compiled by R.F. Waller from data on plans of  
Mine from Surveys by J. Wilks. Auth. & Surveyor  
R.F. Waller  
Authorised Surveyor  
July 20. 1899.

3/2

5 cm

ed. ruled mainmast  
eeal plot

10

10