


THE HERCULES C. & S. M. CO., N.L.

MOUNT READ, TASMANIA

PLAN OF MINE WORKINGS

SCALE

Twenty five feet to an inch

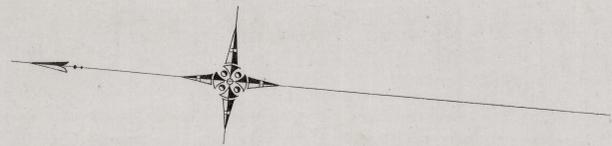

*Survey made with theodolite
by W. S. Reid
12 April, 1911.
Checked
W. S. Reid
12 April 1911*

