


THE HERCULES C. & S. M. CO. LTD.

MOUNT READ TASMANIA

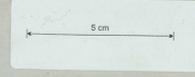

SCALE
Twenty five feet to an inch

Sheet No 5

Work done to January 31st 1902

Spencer Thom
20/11/04

Spencer Thom
23/4/05

B. Sawyer
9.5.01

Island & Moxon
18/1/09



F. Clinie
12/2/08

F. Clinie
18/3/09

F. Clinie
April 21st 1910


Alex. Mc. Skid
12.11.1911

W. G. Boydell
JUN 28 1912

W. G. Boydell
APR 8 1913

John G. Burns A.M.I.
MAR 31 1914

CROSS SECTION A B

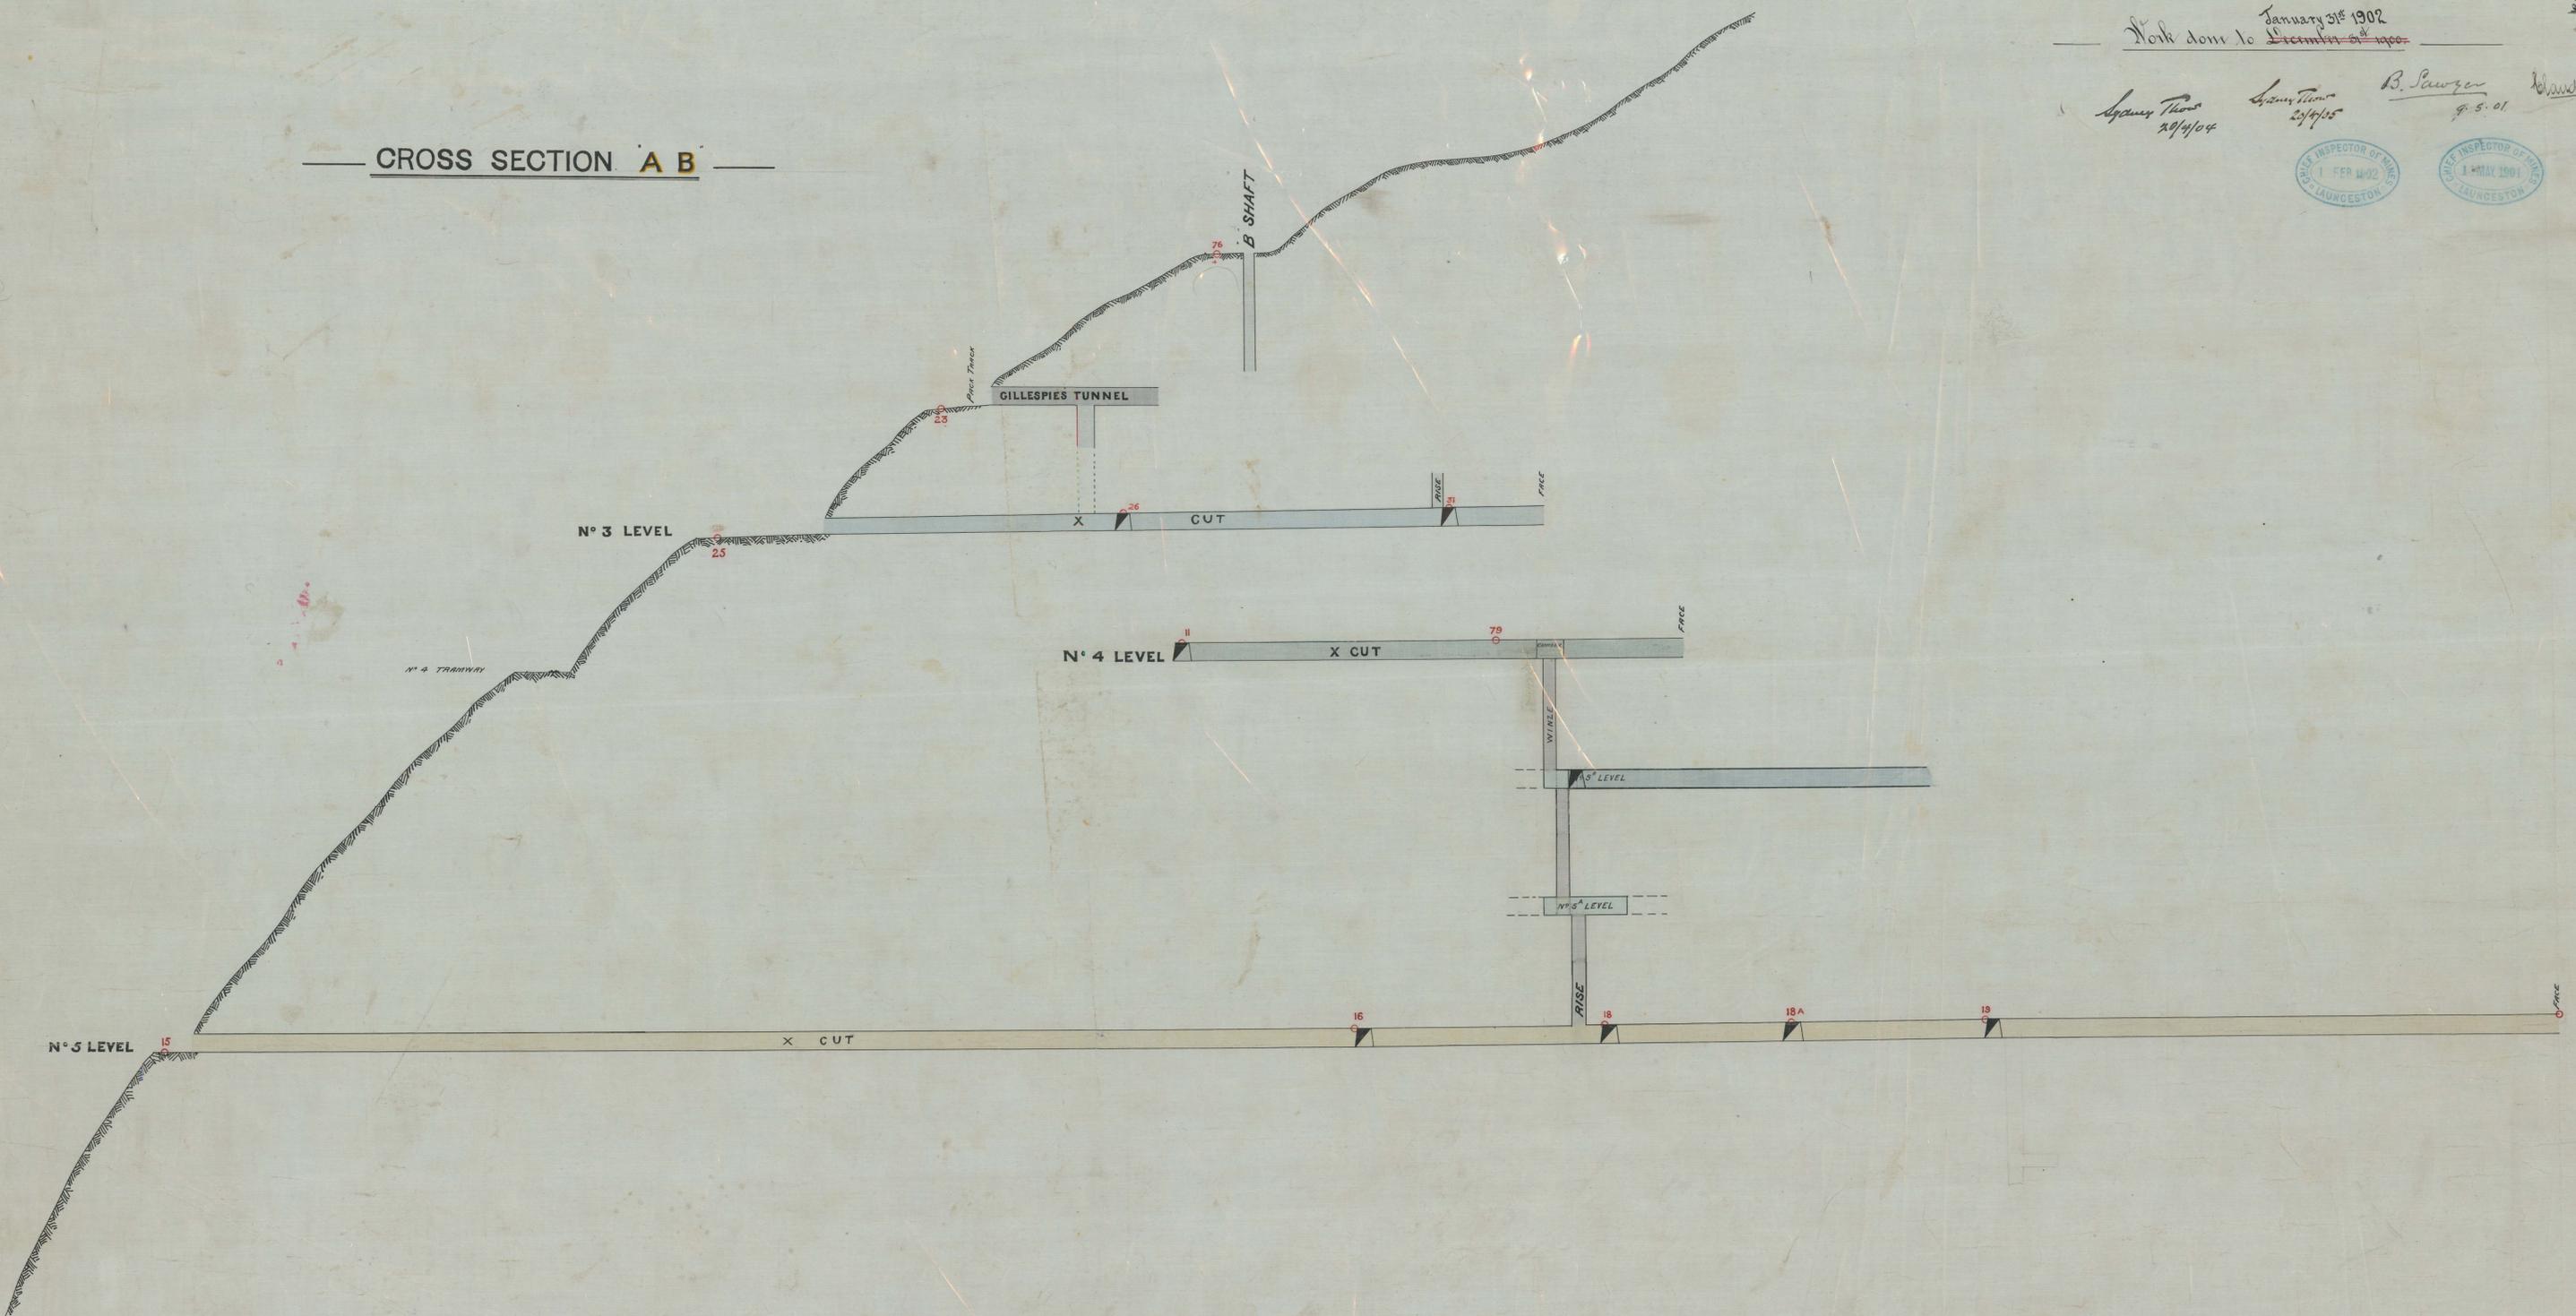

Barlen Boundary