
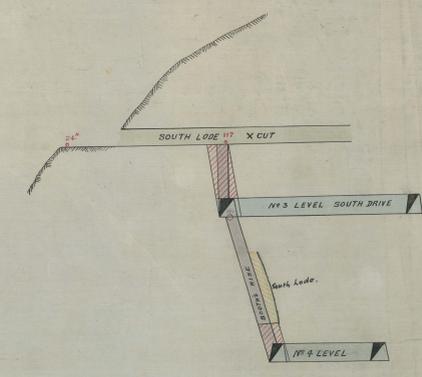
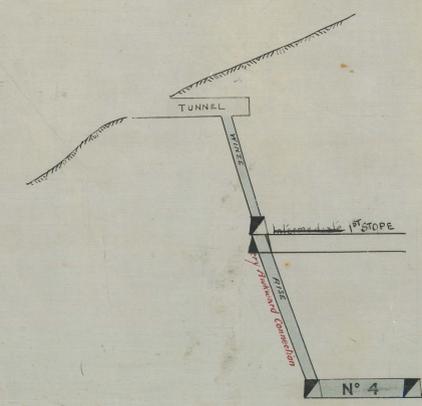
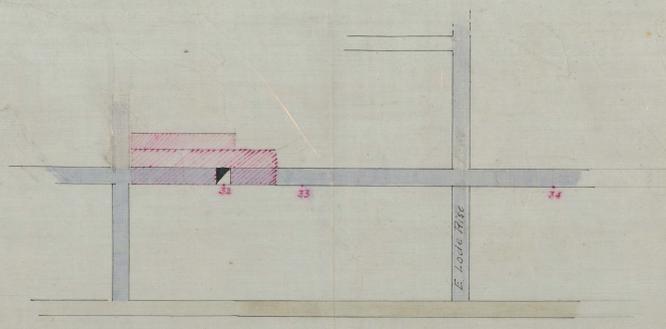
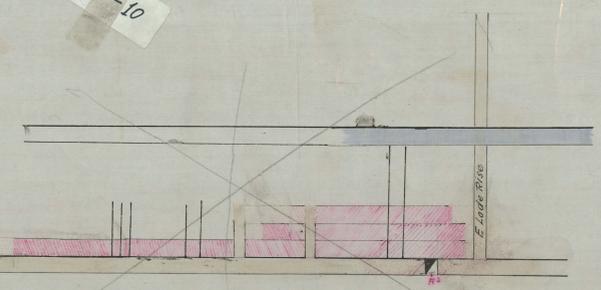


13
26

513-10




C.D

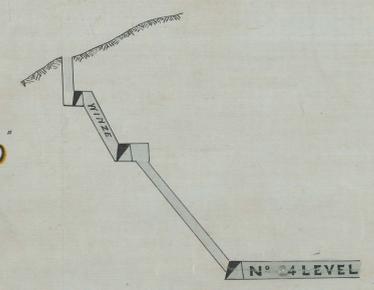

E Lode
Main Cross Cut North



B-South Workings

LONGITUDINAL SECTIONS

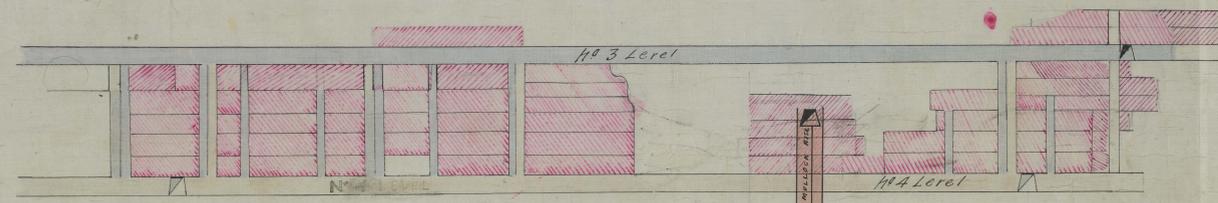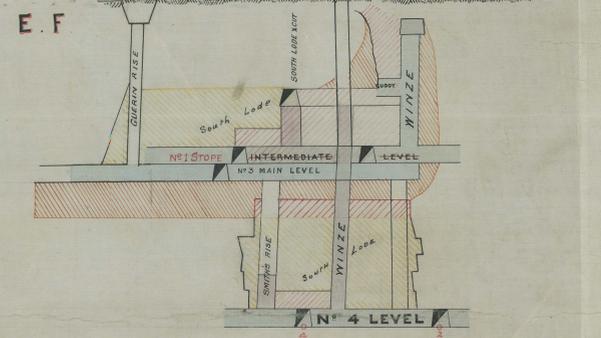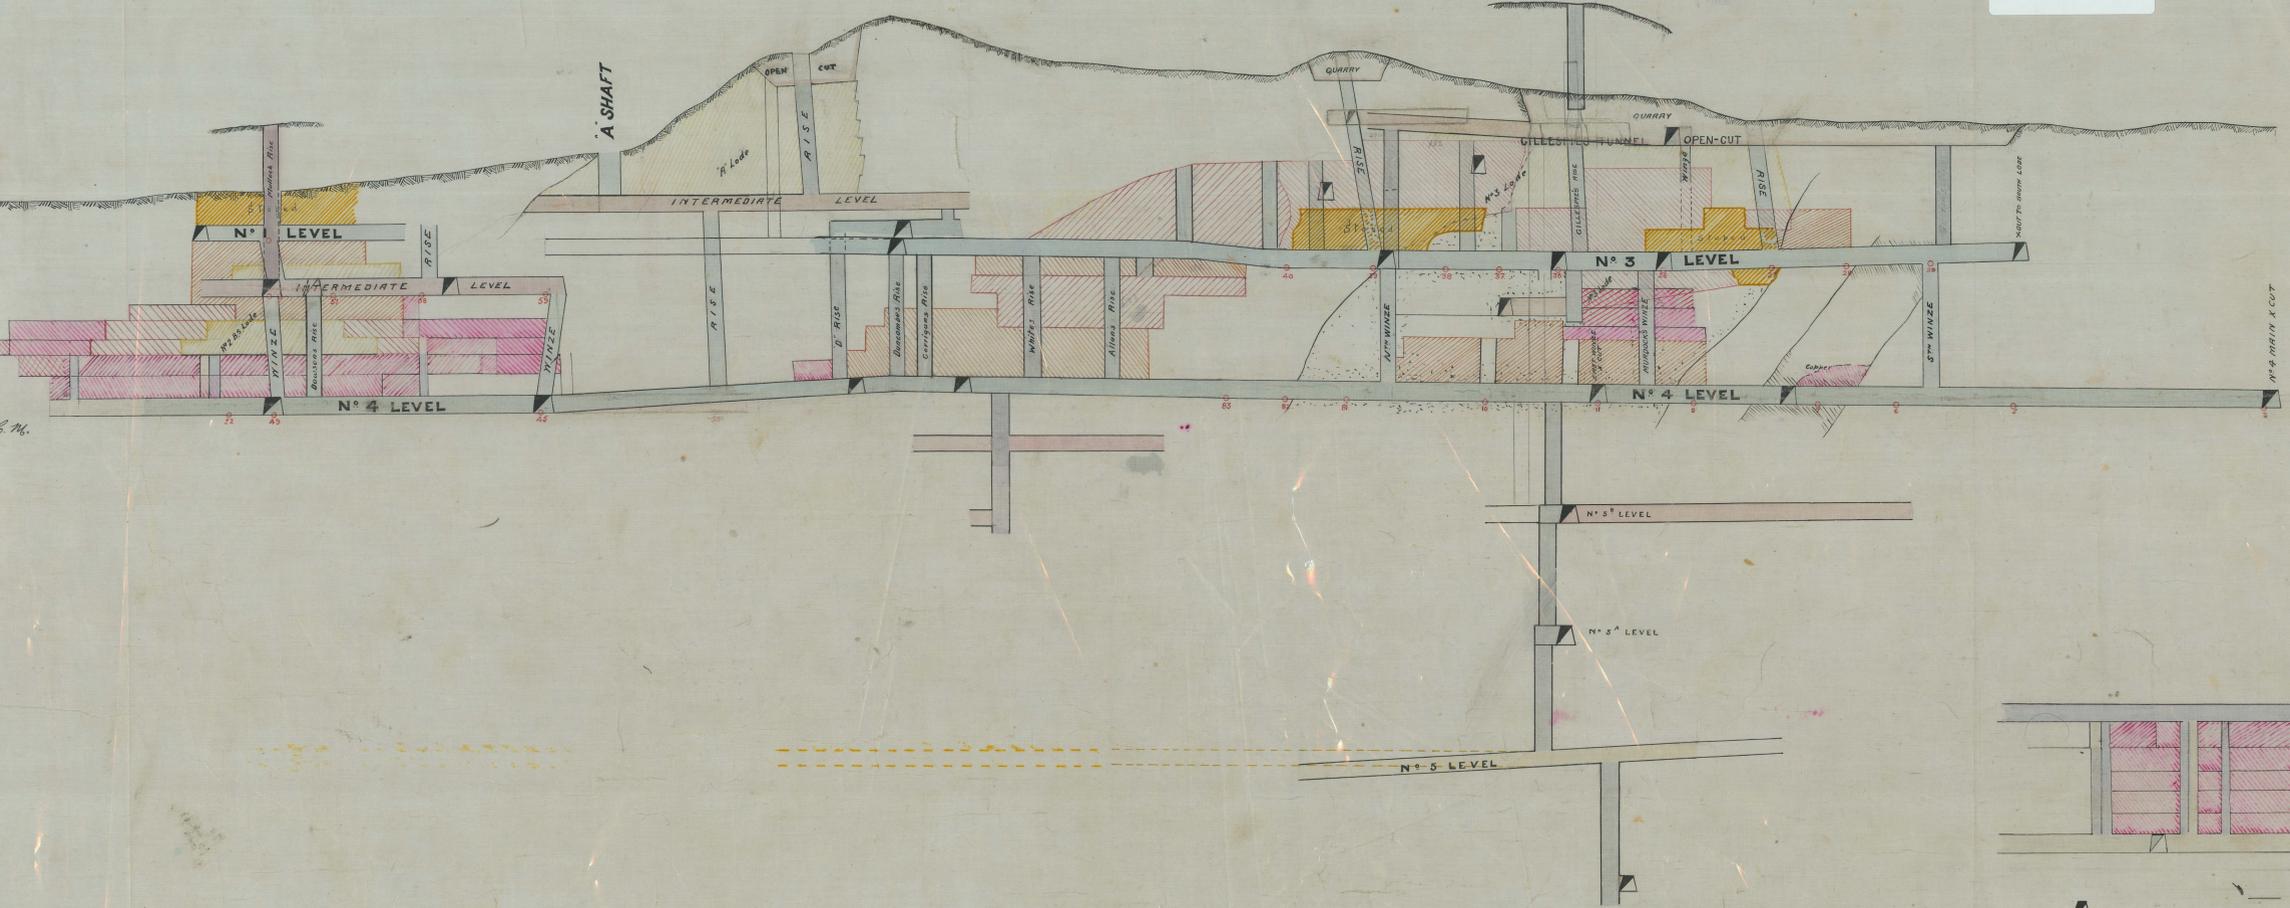

H H
D-Lode

H H
B-Lode

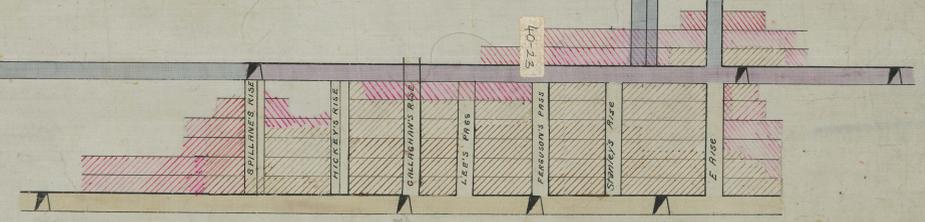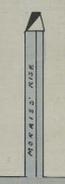

E Lode

N° 6 LEVEL