


# THE HERCULES GOLD AND SILVER MINING COMPANY, NO LIABILITY.

January 31st, 1901.

## PLAN.

Scale: 100 feet - One inch.

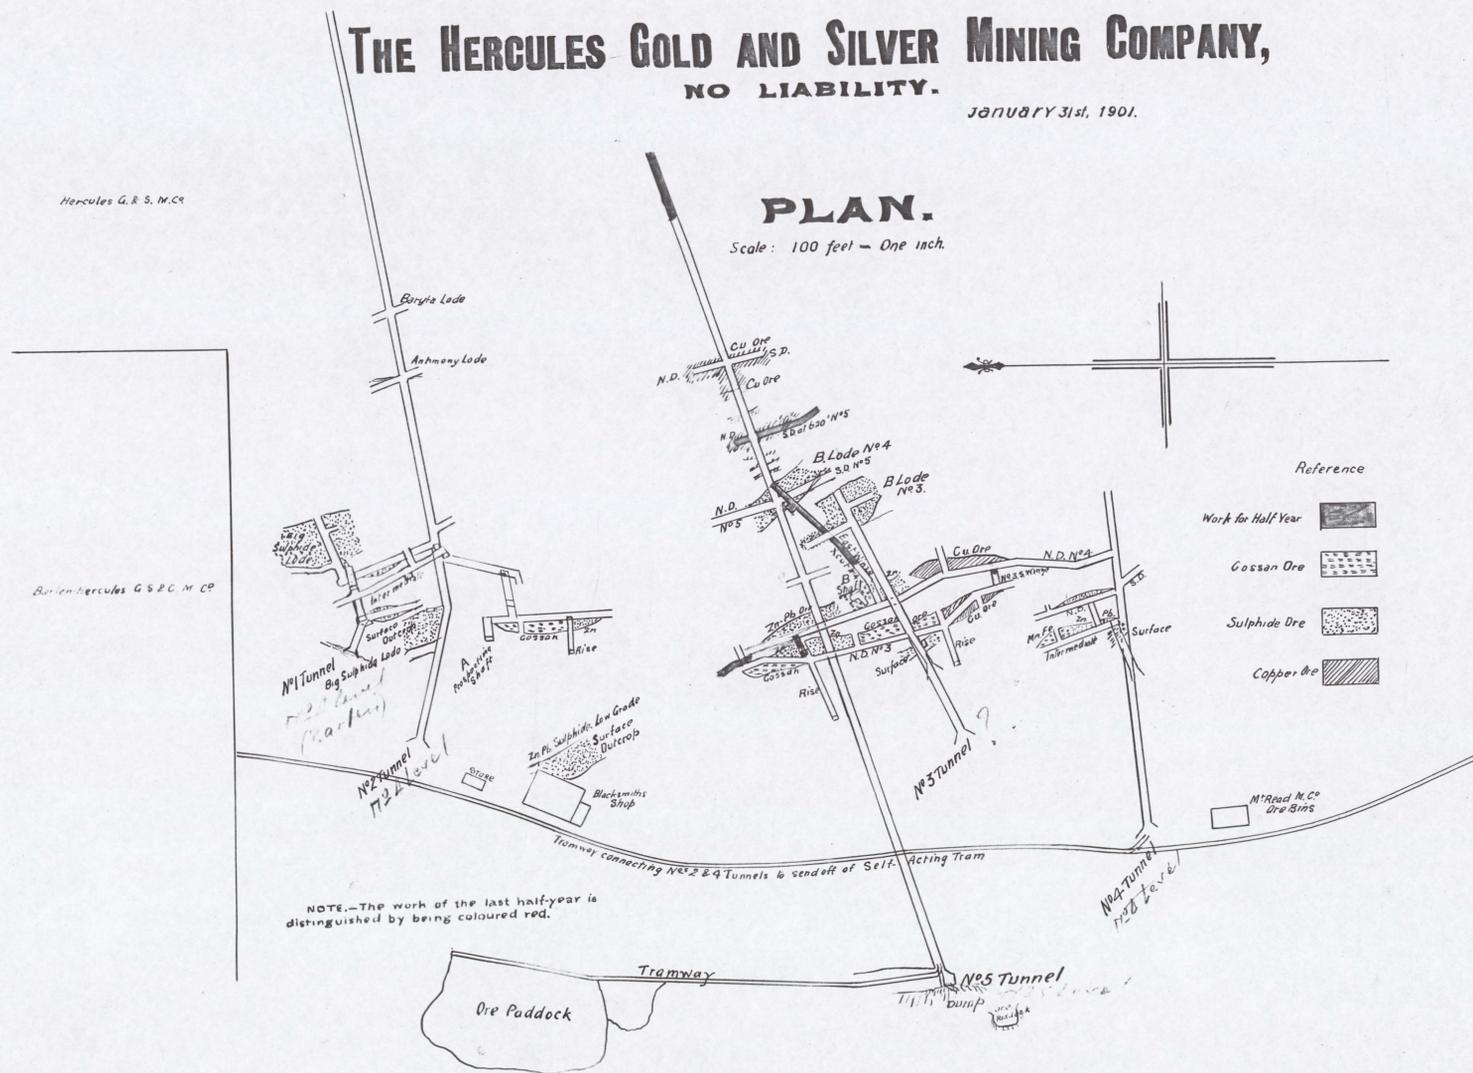

NOTE.—The work of the last half-year is distinguished by being coloured red.

All relevant information transferred to new survey-  
plans Sept 60  
This tracing is not required  
to be kept by Survey Office  
C. W. D. O. S. I. E. P. U. A.

5 cm

0313-013  
1901  
Up Level Plan