

THE HERCULES G. & S.M.C^Y. N.L.


MOUNT READ, TASMANIA

SCALE

Twenty five feet to an inch.

Sheet No 4

CROSS SECTION A.A.

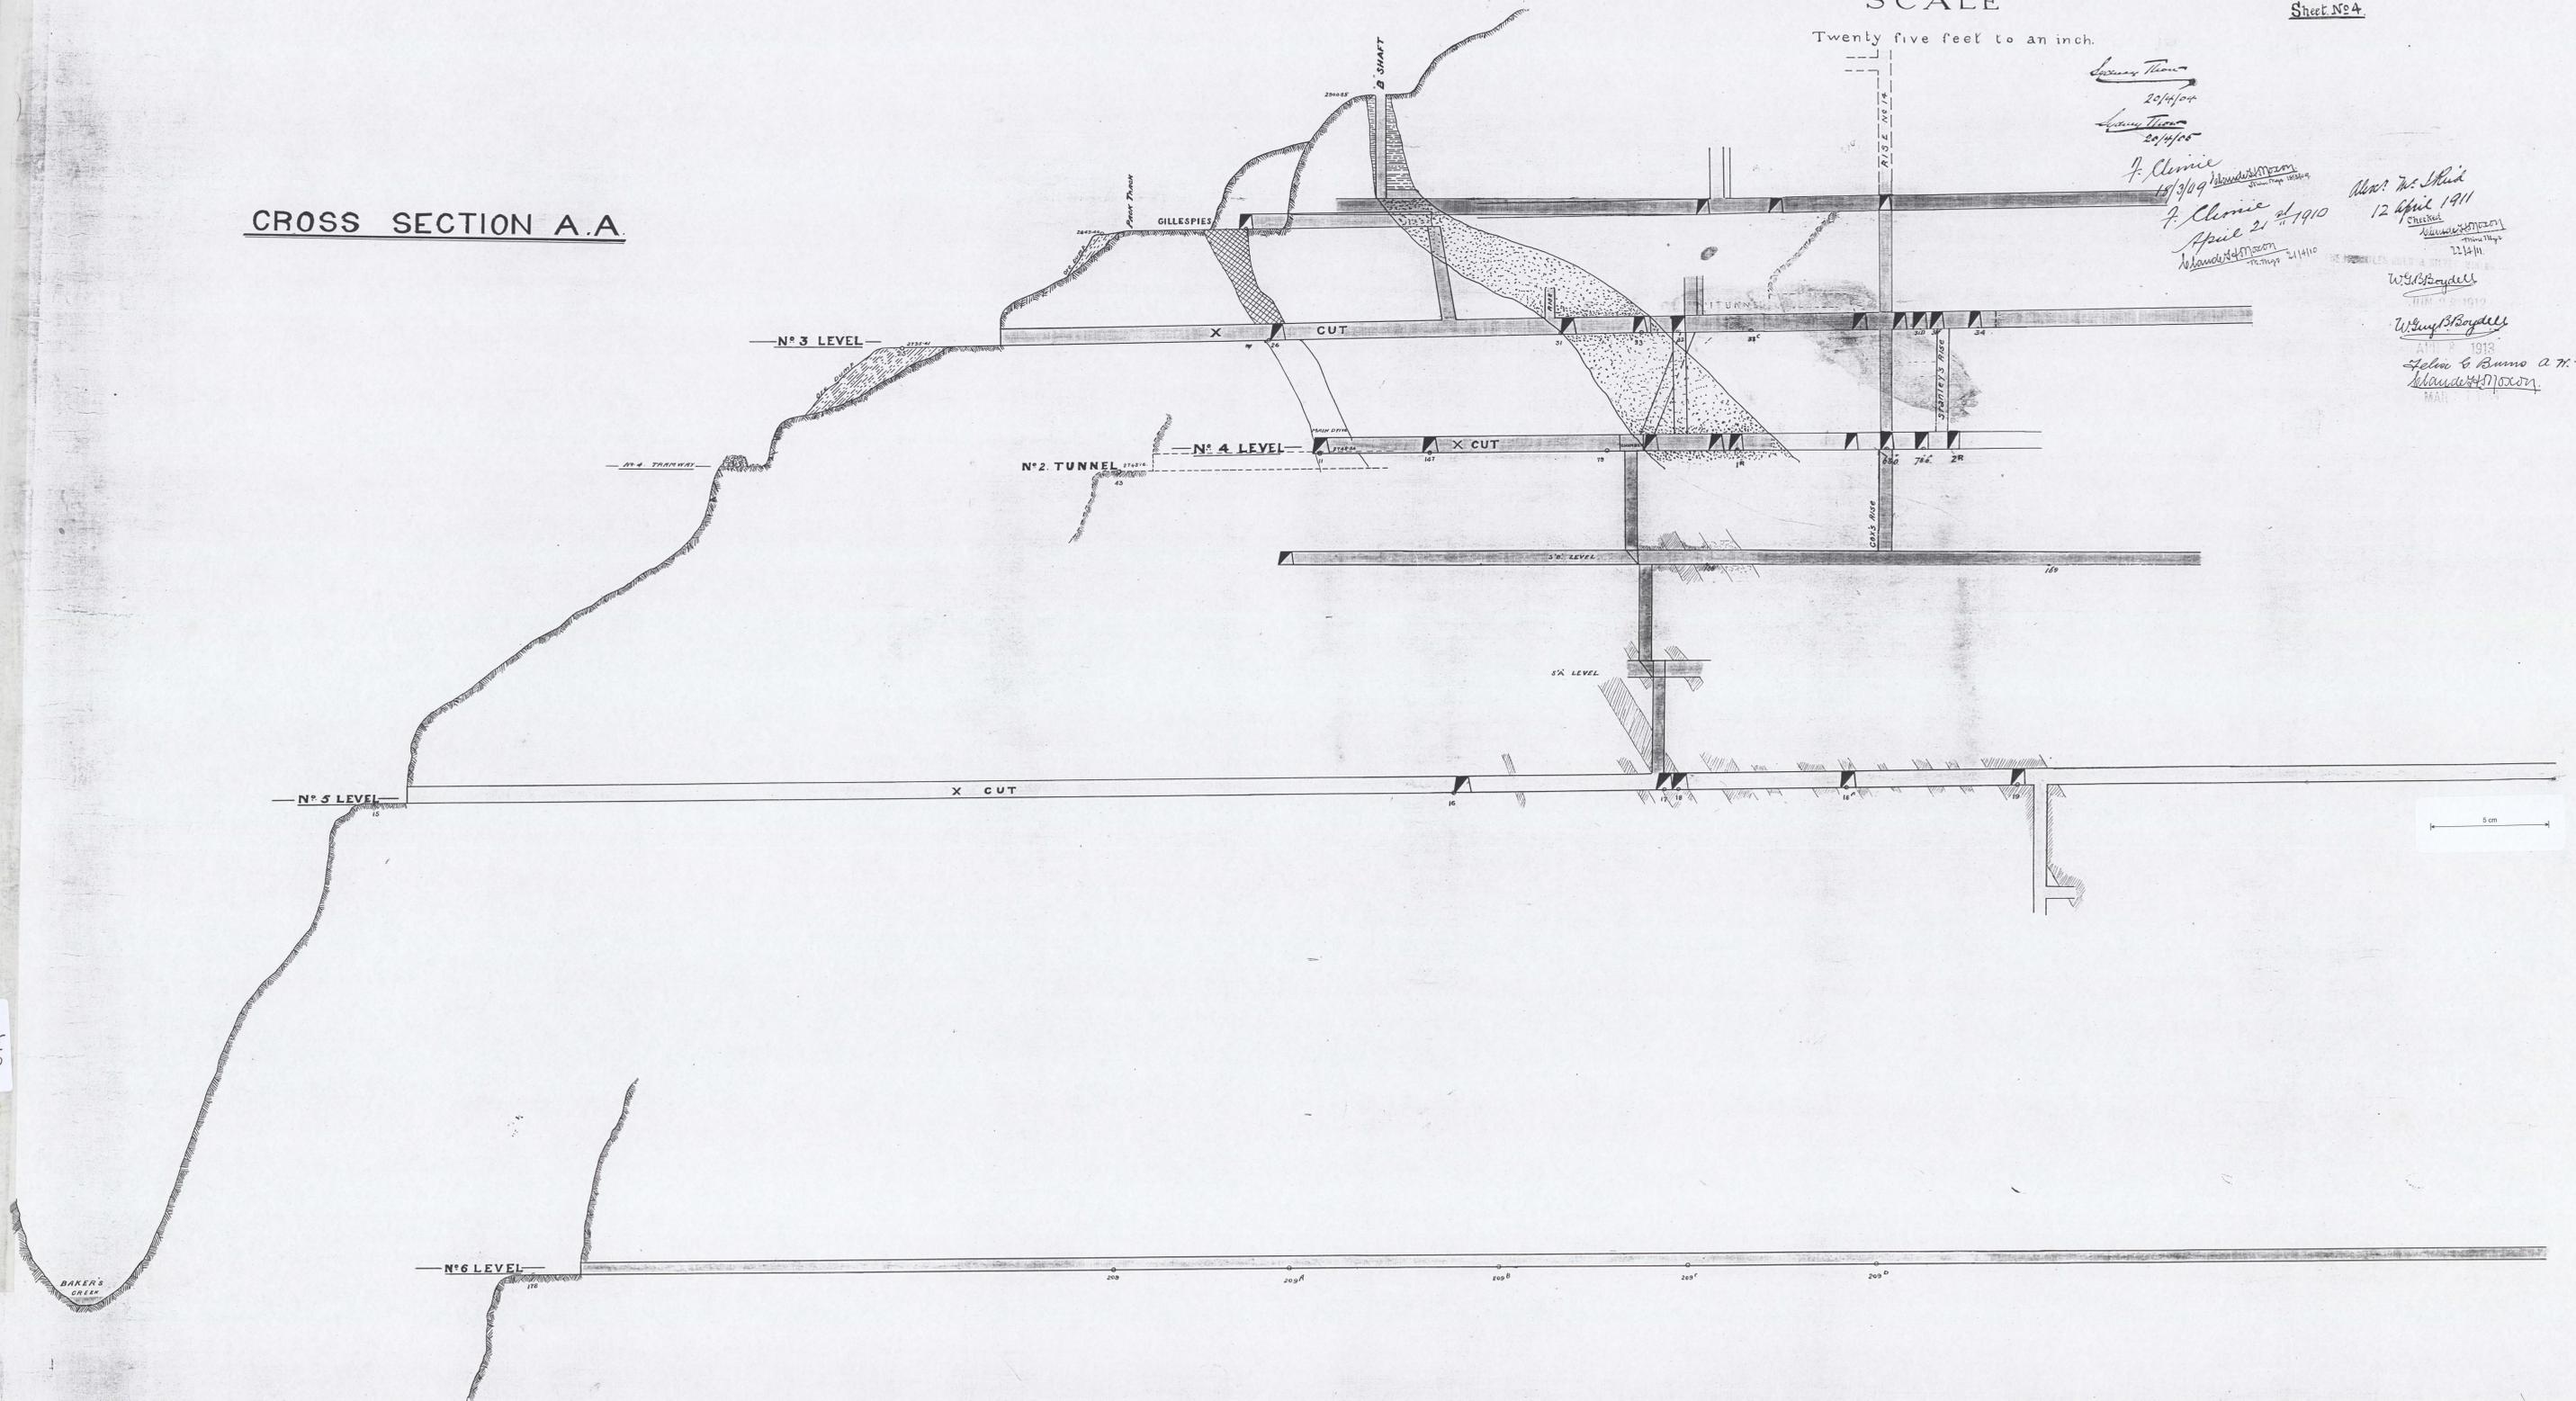

Handwritten notes and signatures:
20/4/04
20/4/04
F. Clunie
18/9/09
April 21st 1910
12 April 1911
W. Boydell
W. Boydell
1913
John G. Burns A.M.S. 1916
Maudslayi

1905
0313 -
014
Section.