
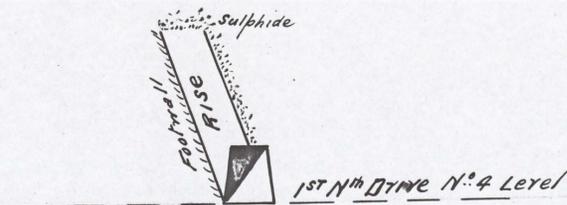
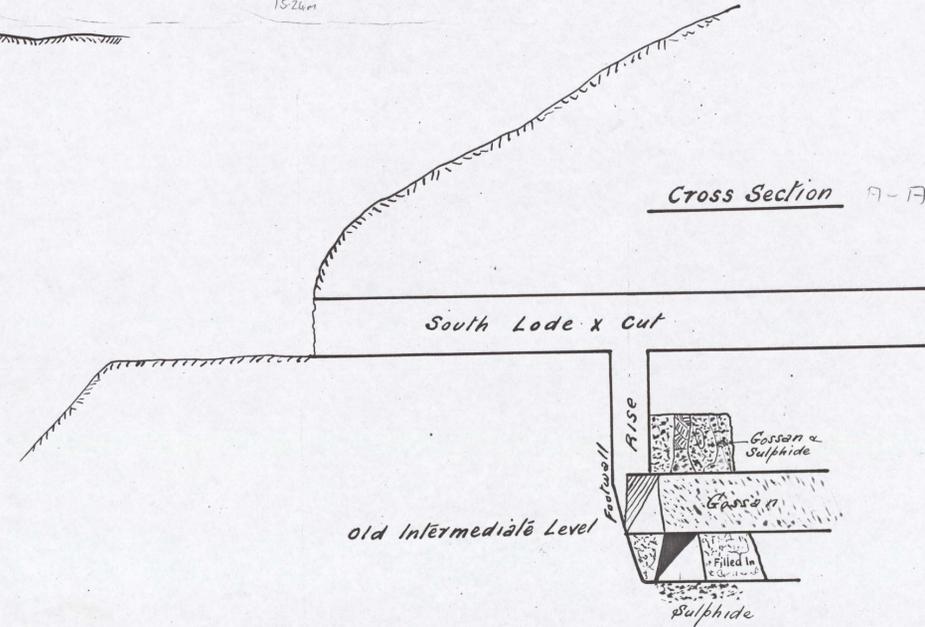
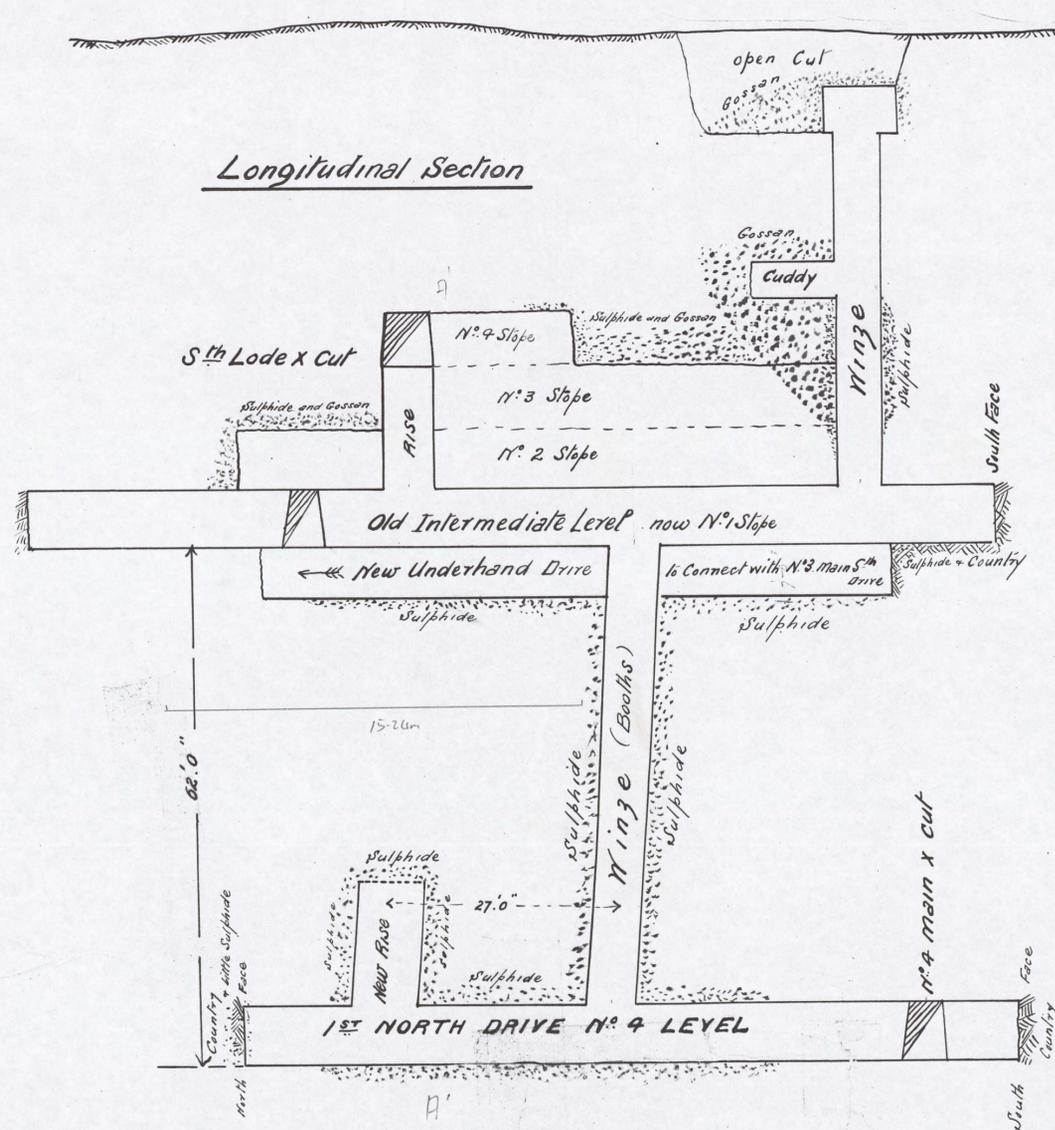


SOUTH LODGE

Diagram showing Ore Occurrences

Scale 12 1/2 Feet = One Inch

19/12/01.

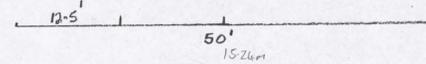

0313-016

South Lode

