

1902 Plan  
Upper Workings



0313-  
017

# PLAN

## Hercules Gold & Silver Mining Co., N.L.

Scale: 100 Feet = One Inch.

JANUARY 31st, 1902  
**Sydney Chow,**  
General Manager.

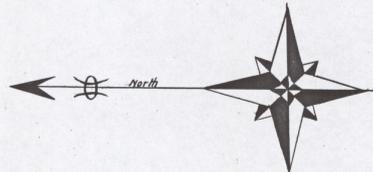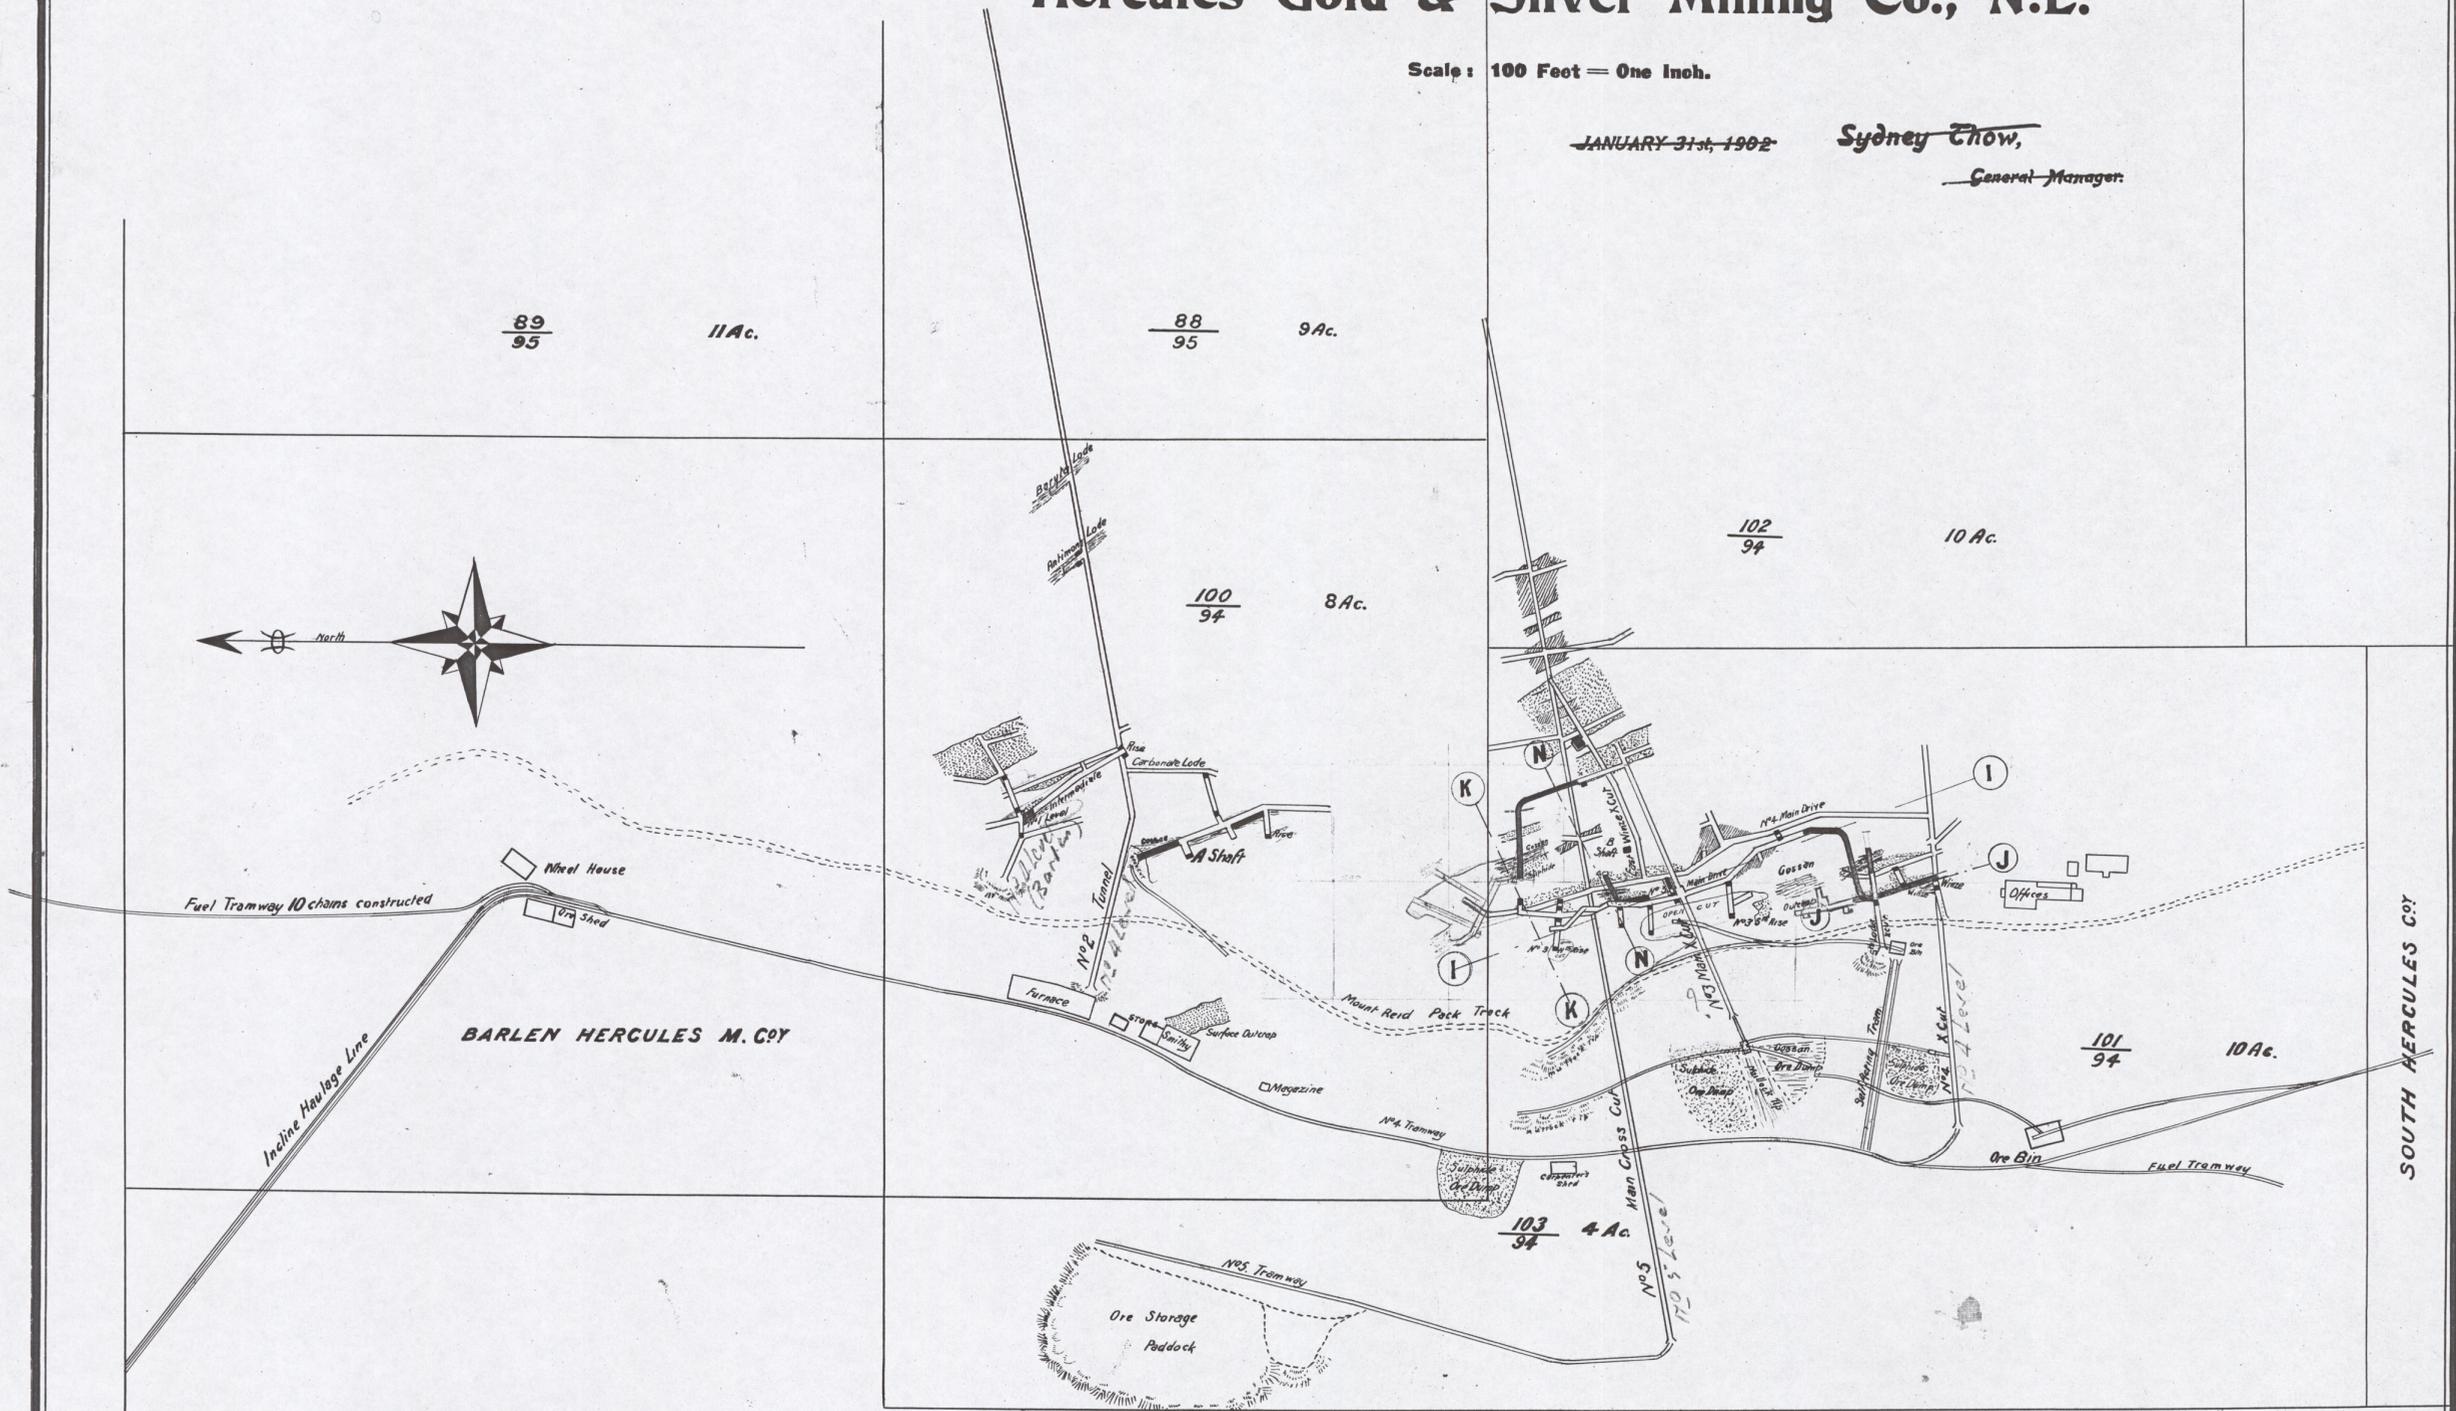

NOTE.—The work of the last half-year is distinguished by being coloured RED.

5 cm

— Reference —  
 Work for Half-Year ending 31st Jan 1902  
 Gossan  
 Sulphide  
 Copper  
 All relevant information transferred to new survey-  
 plans, Sept 1900  
 This tracing is not required  
 to be kept by survey-office  
 P.V.A.  
 Sydney Chow  
 General Manager  
 31 January 1902.

SOUTH HERCULES COY

Composite