
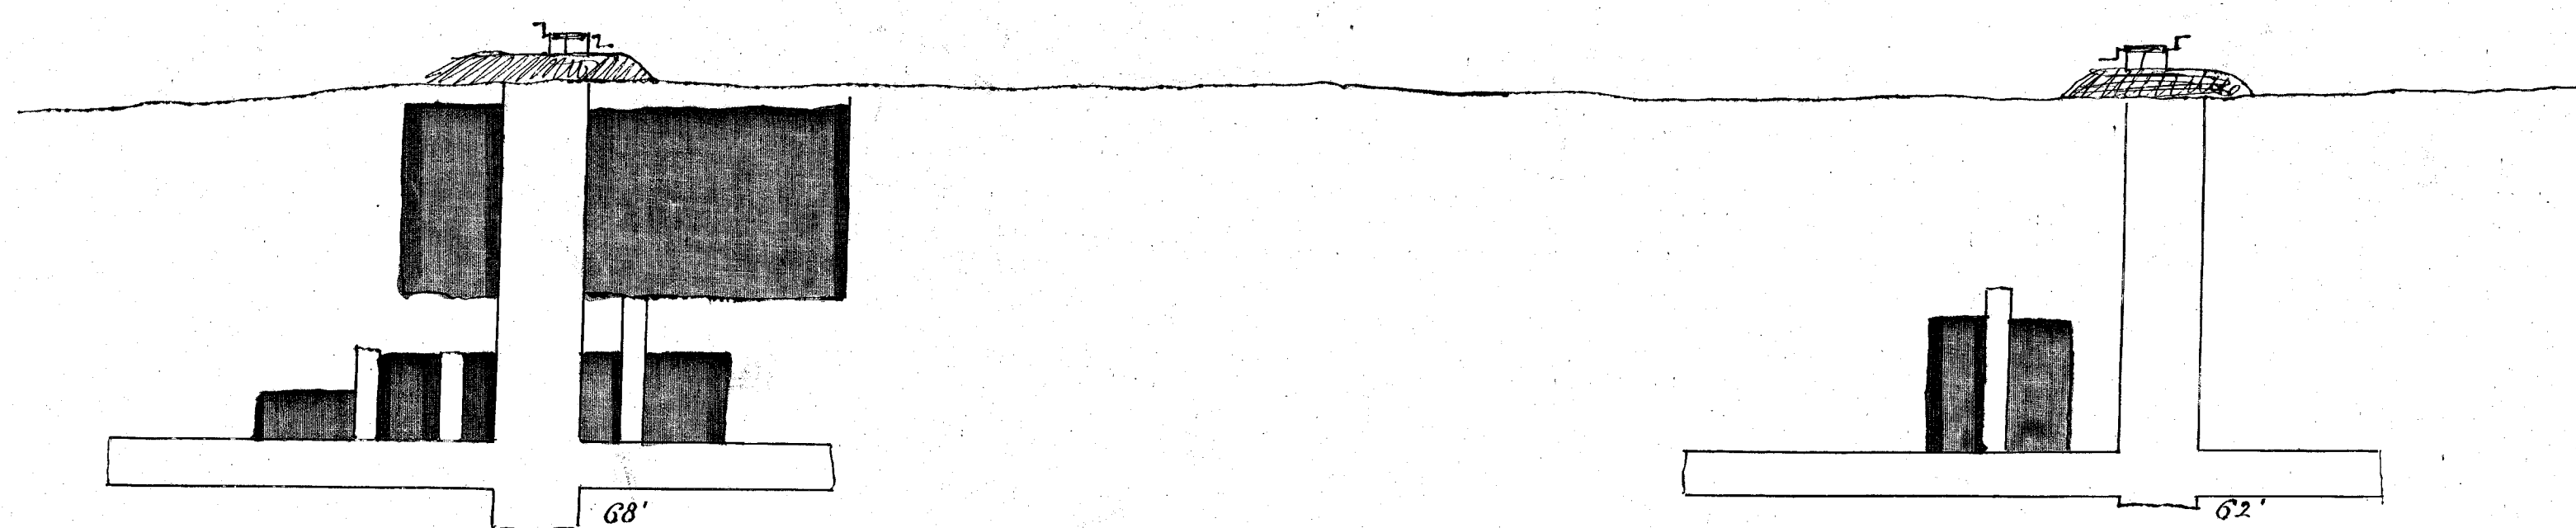
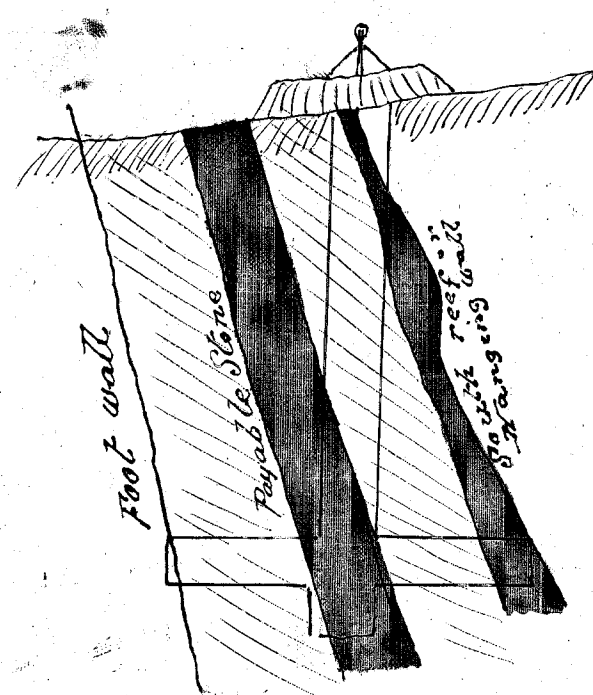


Scale 25ft to an inch.

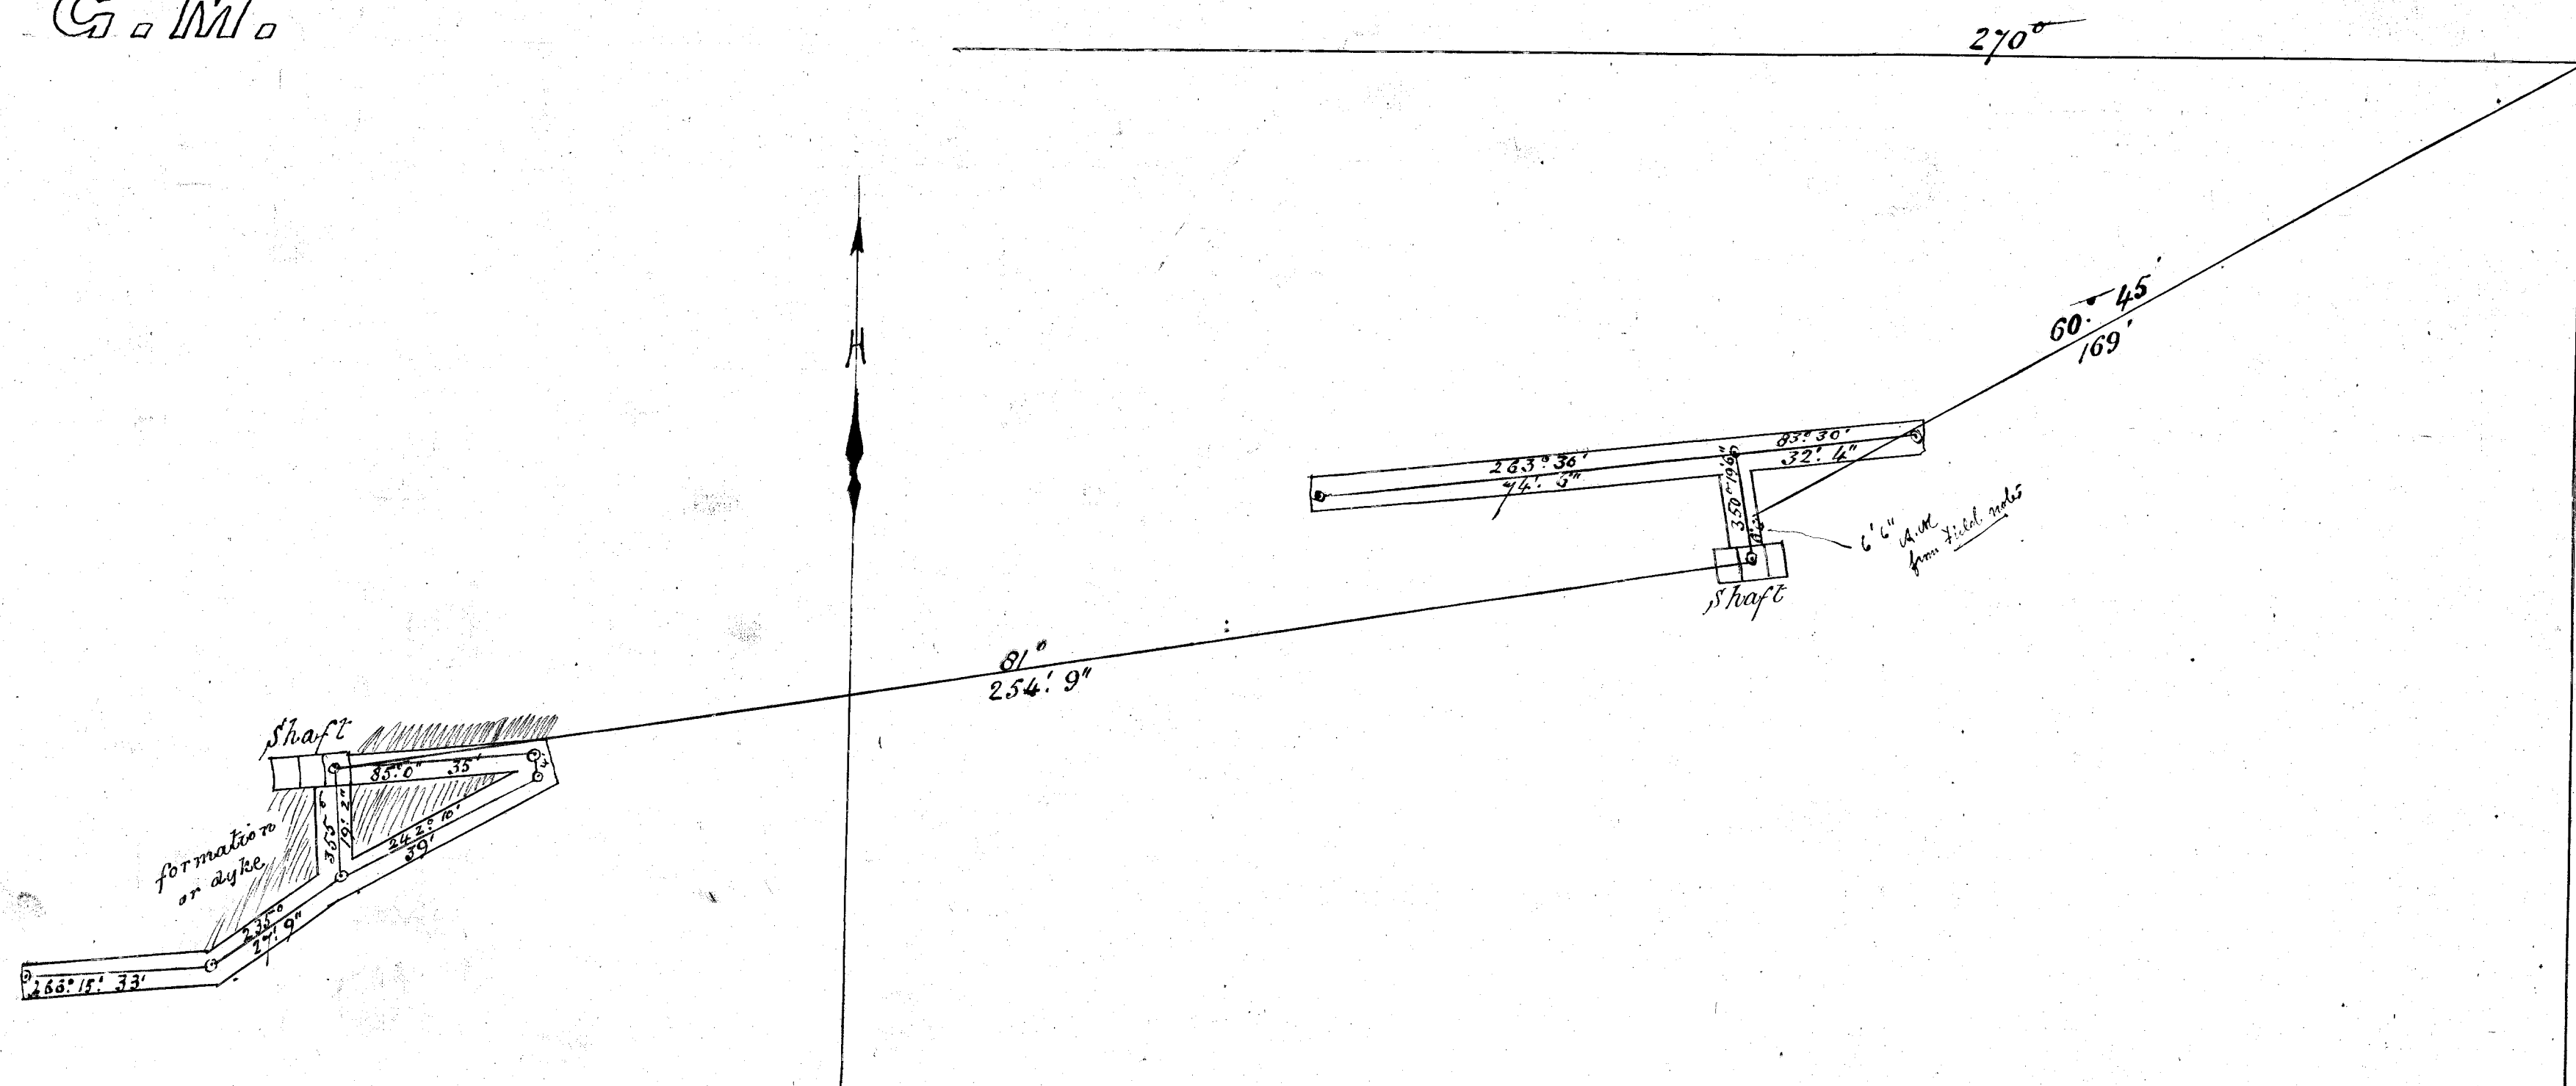

I hereby certify that this is a
correct copy of the working of
above named law as can be obtained
up to and of June 1890
J. Quincy Hutchins.
Miner & Law Surveys
P. P. A. C. S.