


3/4
04

3

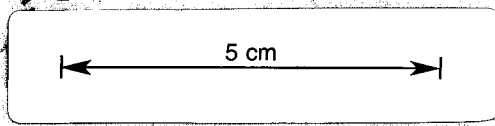

58

W. CORNER

90°

adjusted Datum 794

1553
93.6

145.30'

15.8'

IRON
PIN

MAIN
SHAFT

296° 106'

76° 03'

scale 157' 3"

794

78° 53'


scale 82'

72° 13'

32'

photo 5-53

New. Tonafoe U.M.C. No Liability
Plan of 250' level Morning Star Shaft
Scale 25 feet to 1 inch

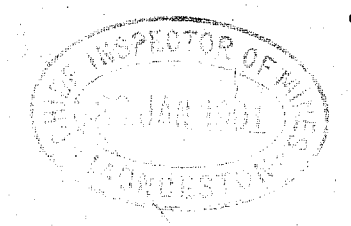

J. P. Minto
Gen. Mico Manager
25/1/01