


NEW PINAFORE 1891

NEW PINAFORE G.M. CO. N.L.

Lefroy

Longitudinal Section (Central Shaft)

Scale 25 feet to an inch

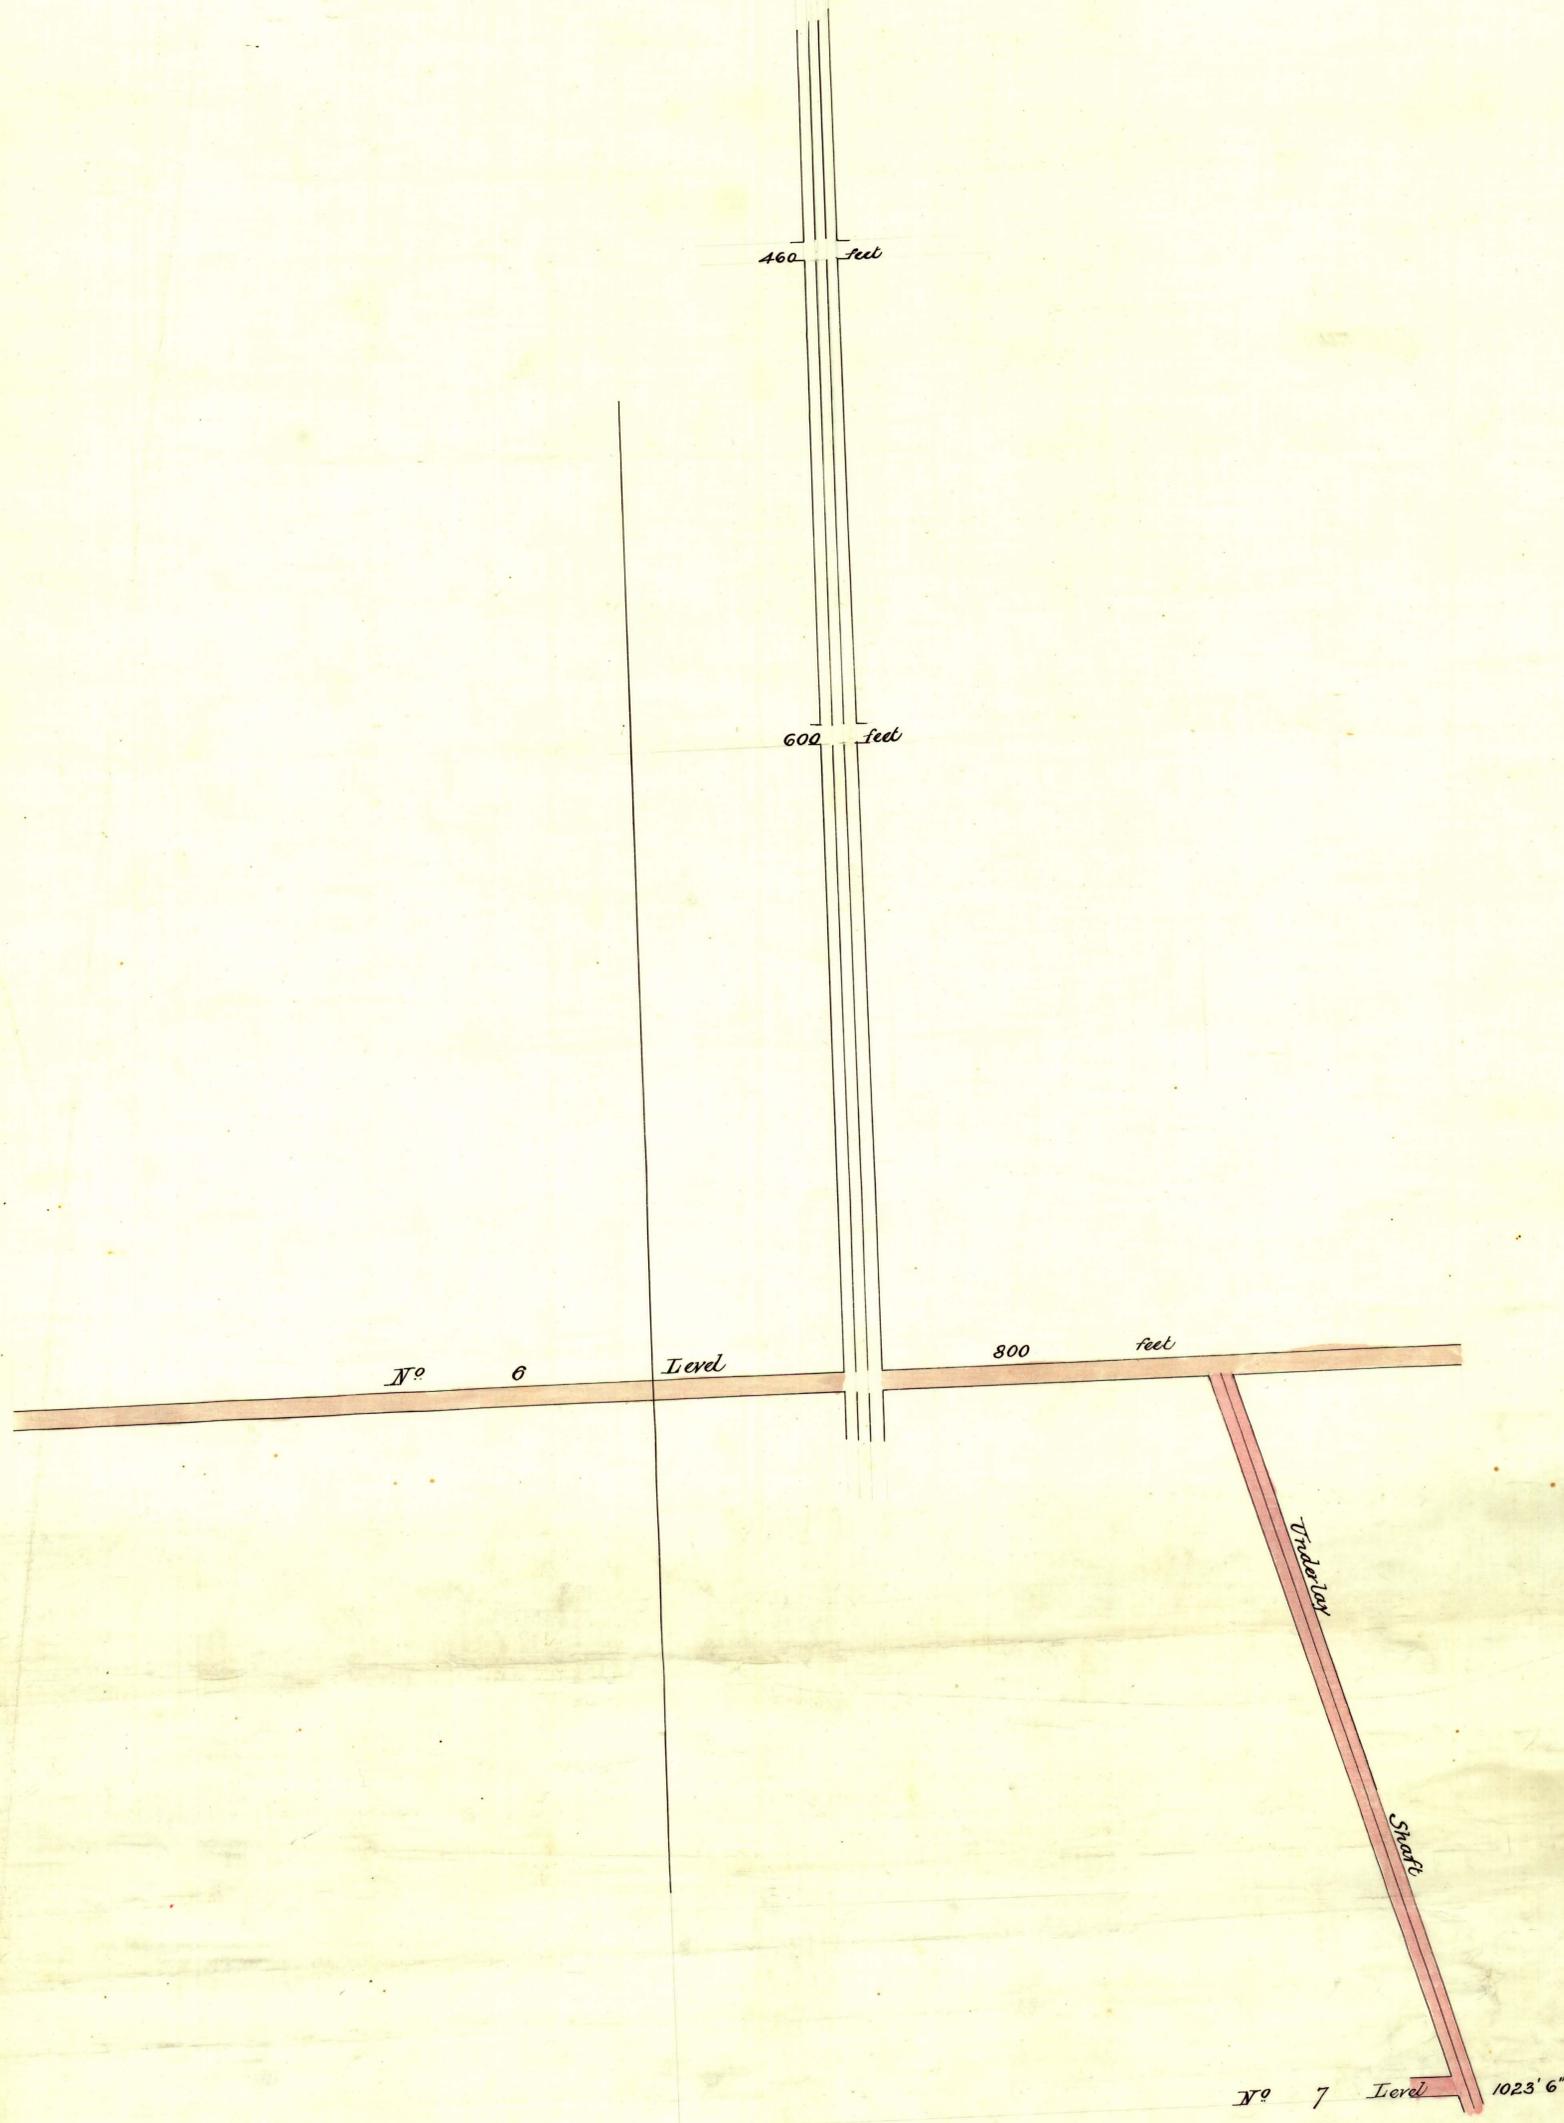

5/1/97

H. J. Miles
Authorised Surveyor
Sunderland
Jan'y. 1907

58

58