

NEW PINAFORE C M C^o N L


Eastern Section

Scale 25 feet to an inch

References

- No 1 Level (Magnetic)
- No 2 Level
- No 3 Level (Magnetic)
- Ground Stored

Longitudinal Section

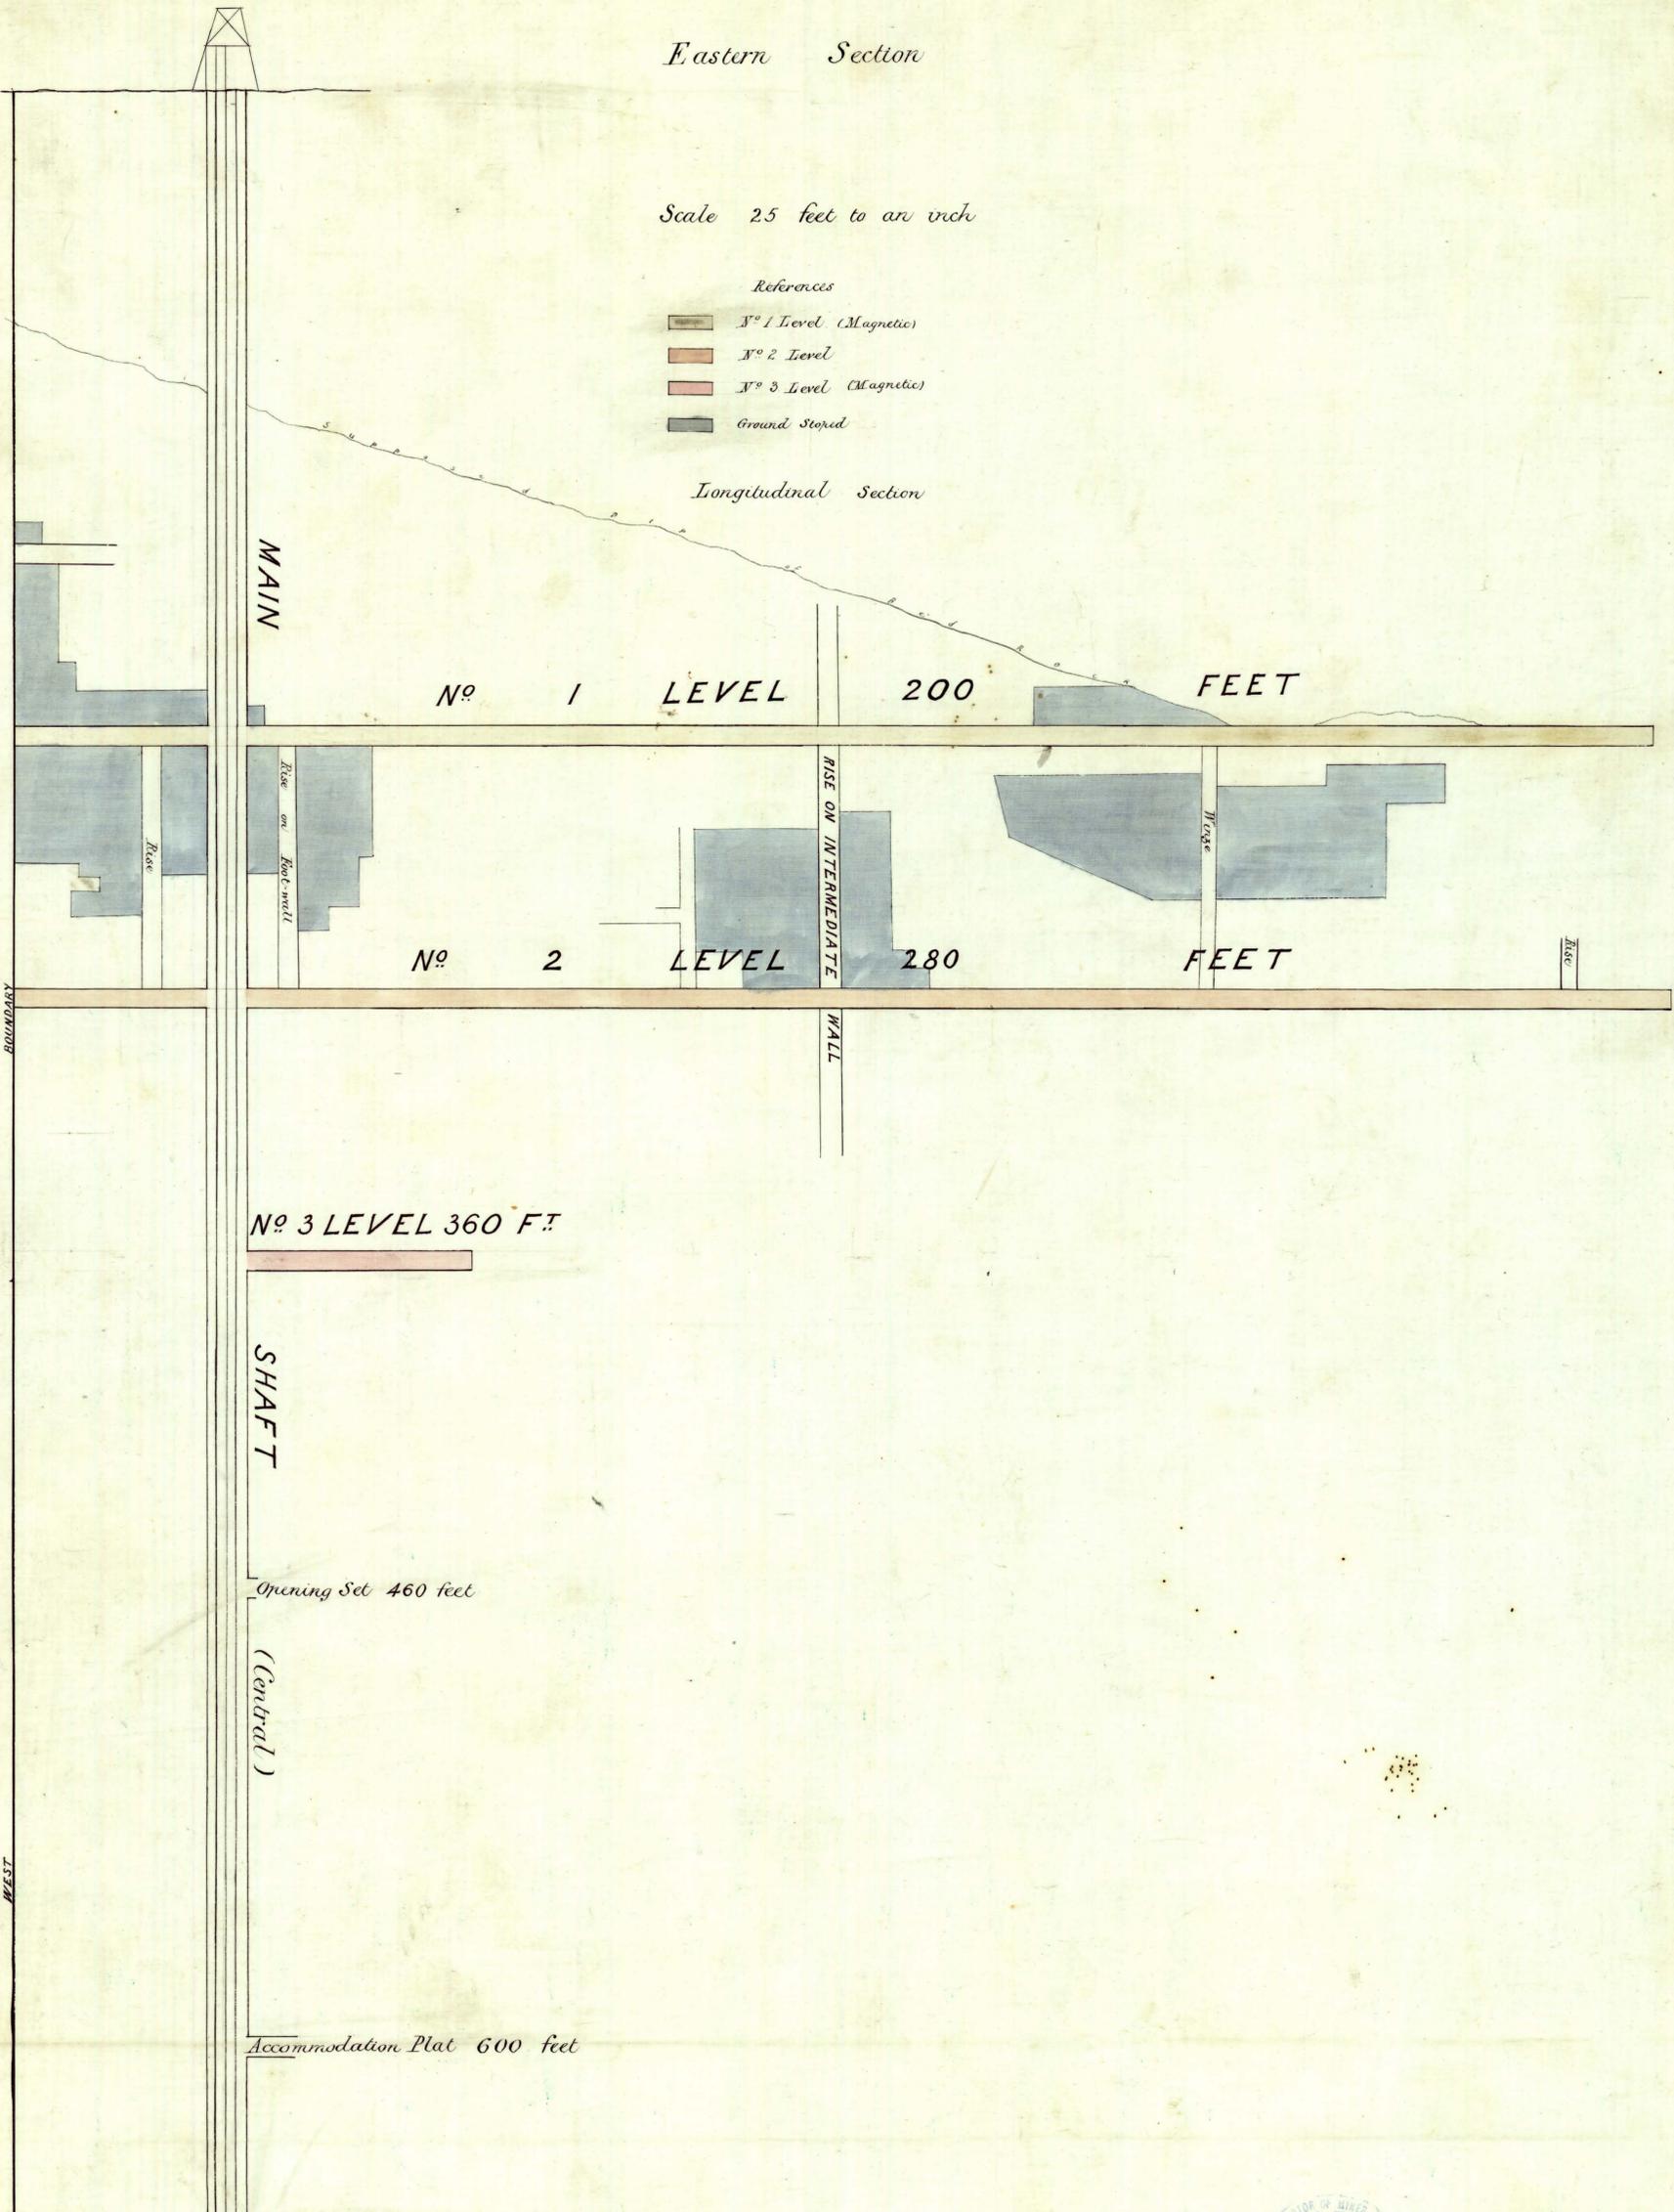

Compiled from Mr. Eddie's survey,
 with additional in No 1 level by Mr
 J. S. Steuts. No 2 Level additional
 survey by myself with 6" Transit theodolite
 No 3. Surveyed by me with magnetic needle
 N. S. Mills.
 Antipraxis Pancyer
 Sep 17
 11/4/95.