



# NEW PINAFORE G M C<sup>o</sup> N L

Eastern Western Section N<sup>o</sup> 5 Level Ground Plan

Scale 25 feet to an inch

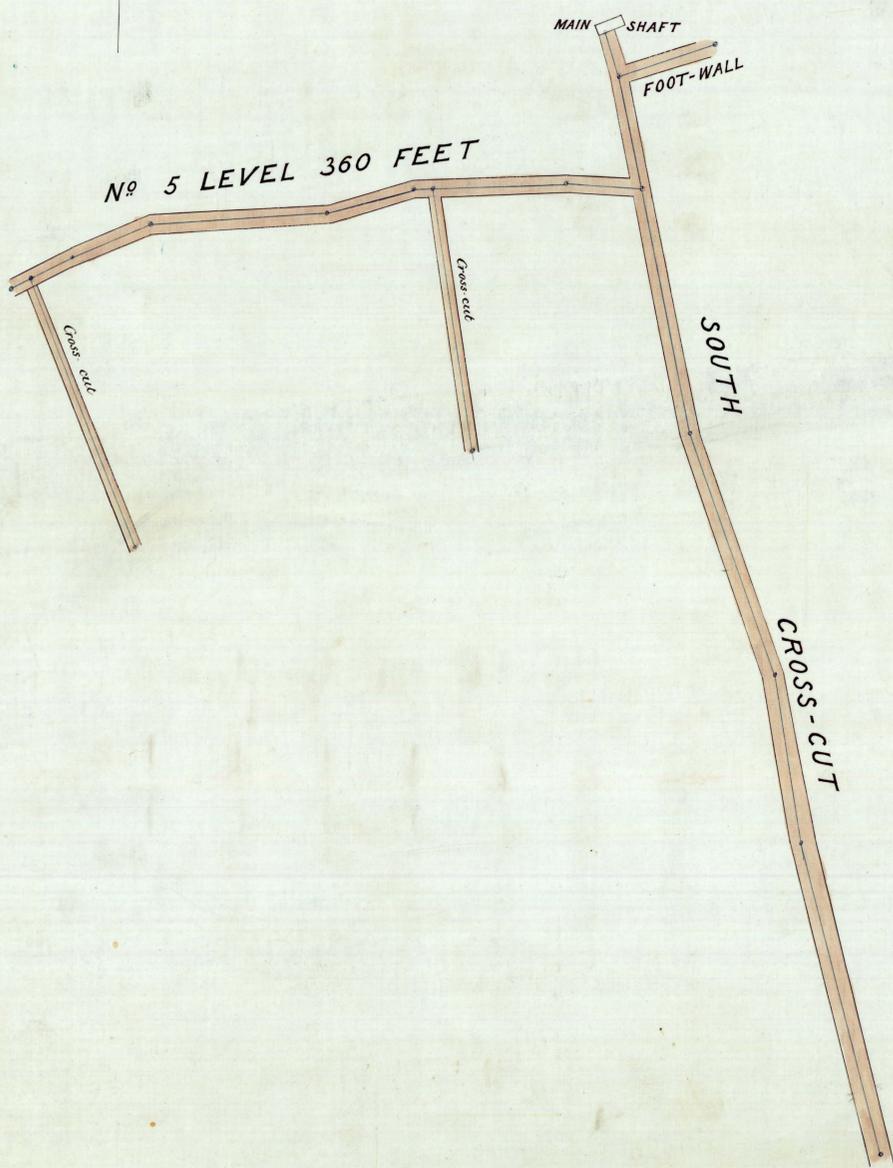

## Longitudinal Section

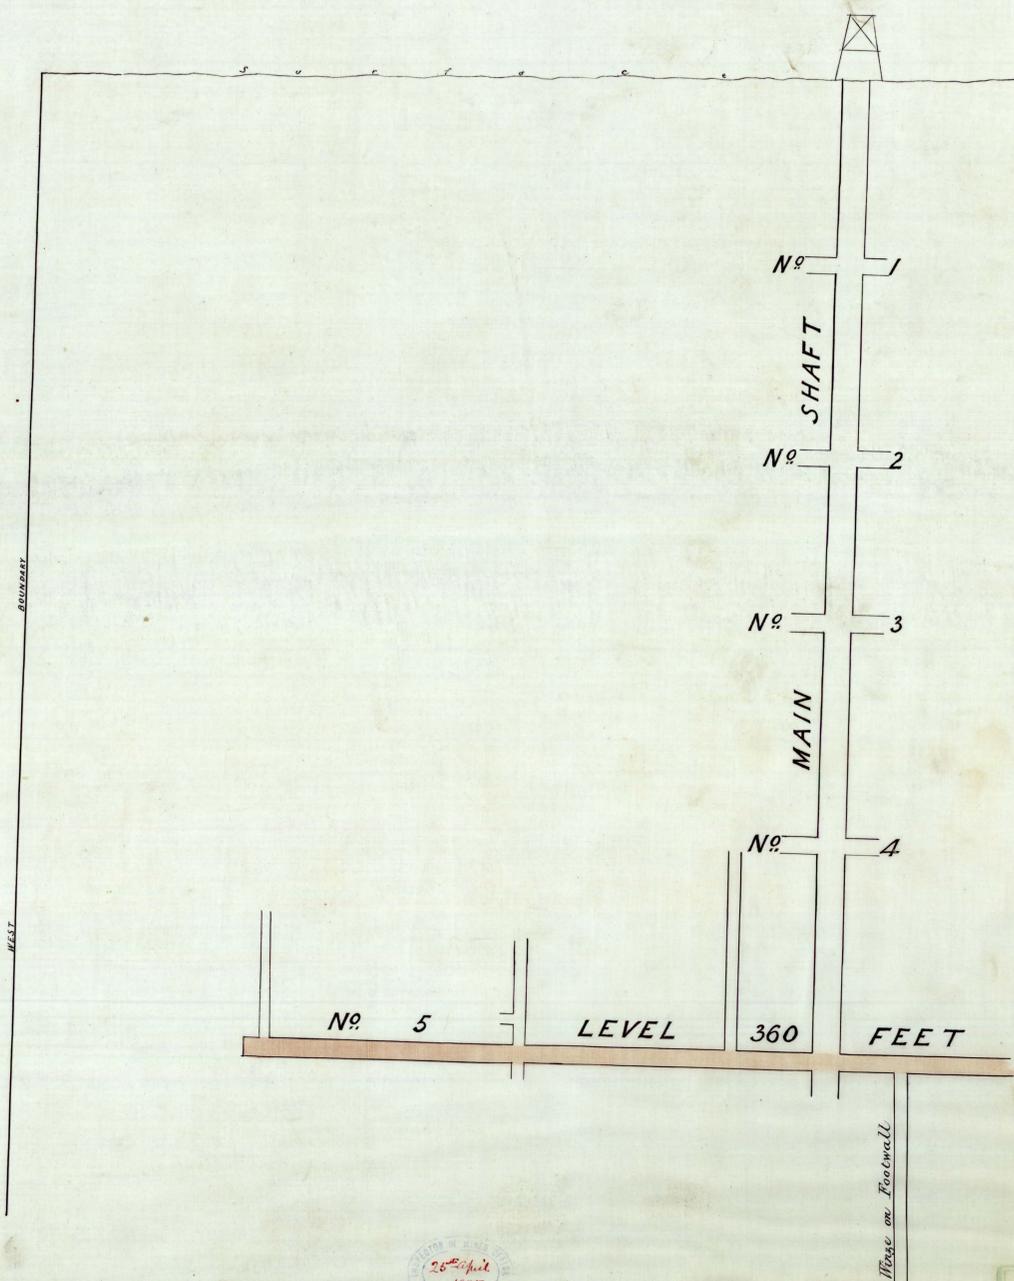

5 cm



Compiled from Mr. Eddie's plan with additional by Mr. J. L. Davis.

A. S. Mills  
Authorized Surveyor  
S. F. M.

