


NEW PINAFORE G M C<sup>o</sup> N L

Ground Plan  
 Eastern Section  
 Scale 25 feet to an inch

- References
- N<sup>o</sup> 1 Level (Magnetic)
  - N<sup>o</sup> 2 Level
  - N<sup>o</sup> 3 Level (Magnetic)

East Churn G M C<sup>o</sup> N L

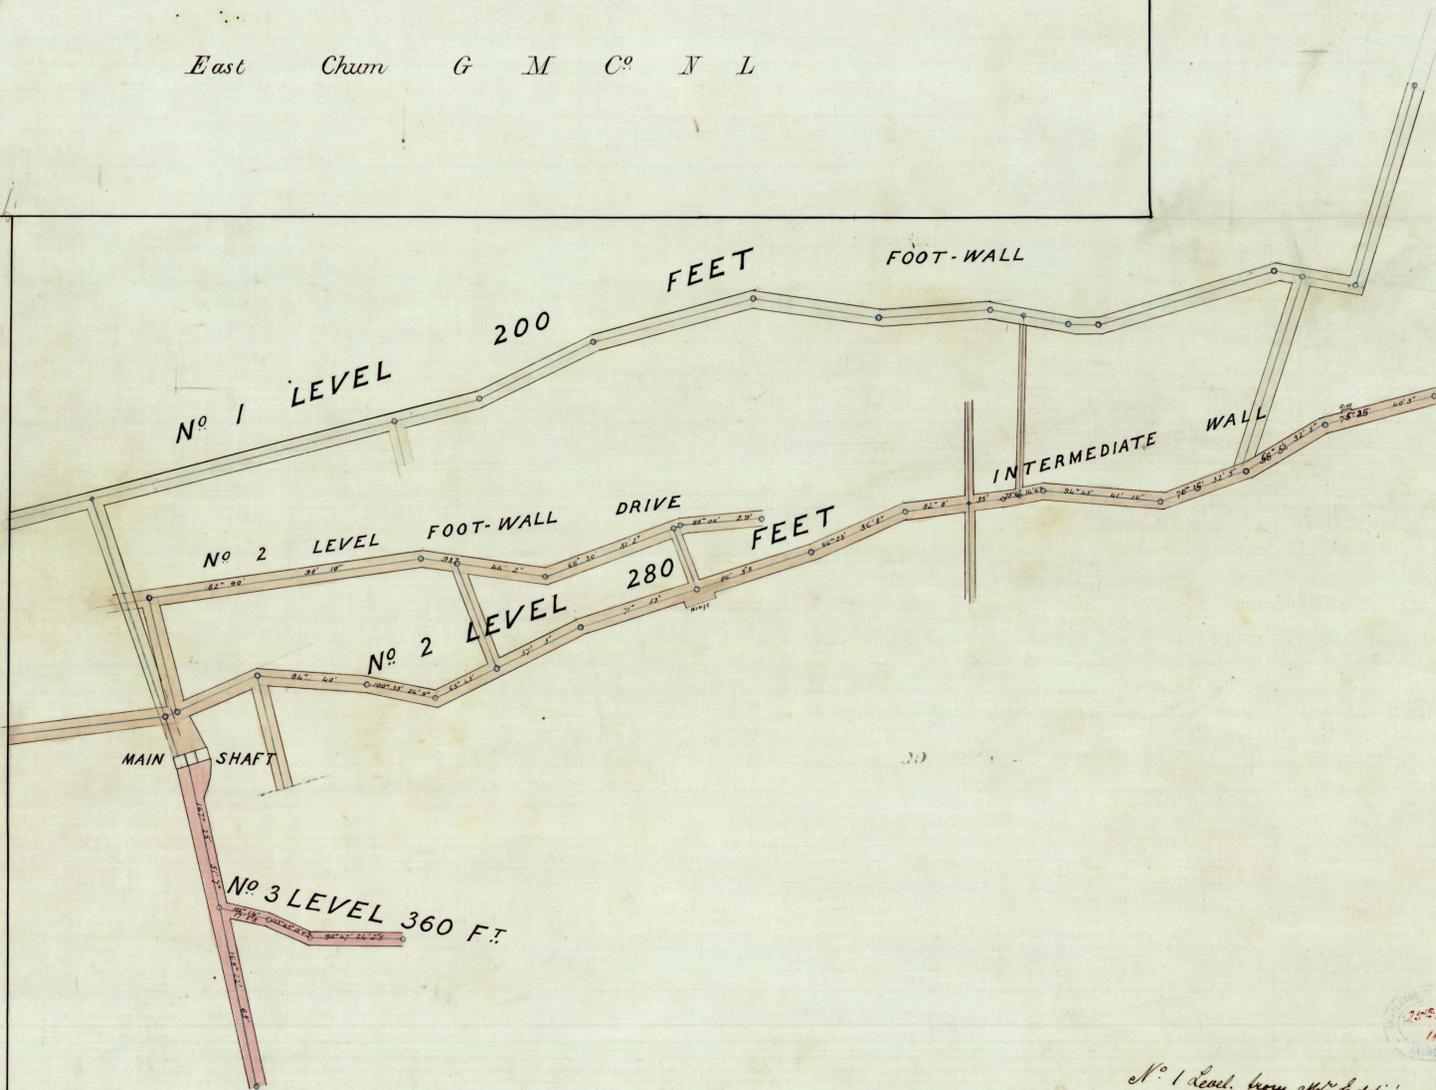

25<sup>th</sup> April 1898  
 LONDON

N<sup>o</sup> 1 Level from Mr. Eddis's survey. Additional by Mr. J. L. Stiles  
 No 2 Level from Mr. Eddis's survey. Additional by myself with  
 6" Transit theodolite  
 No 3 Surveyed by me with magnetic needle

A. S. Thillo  
 Authorized Surveyor  
 LONDON

58

58