


Scale 25 ft. to 1 inch.

Scale 25 ft. to 1 inch.

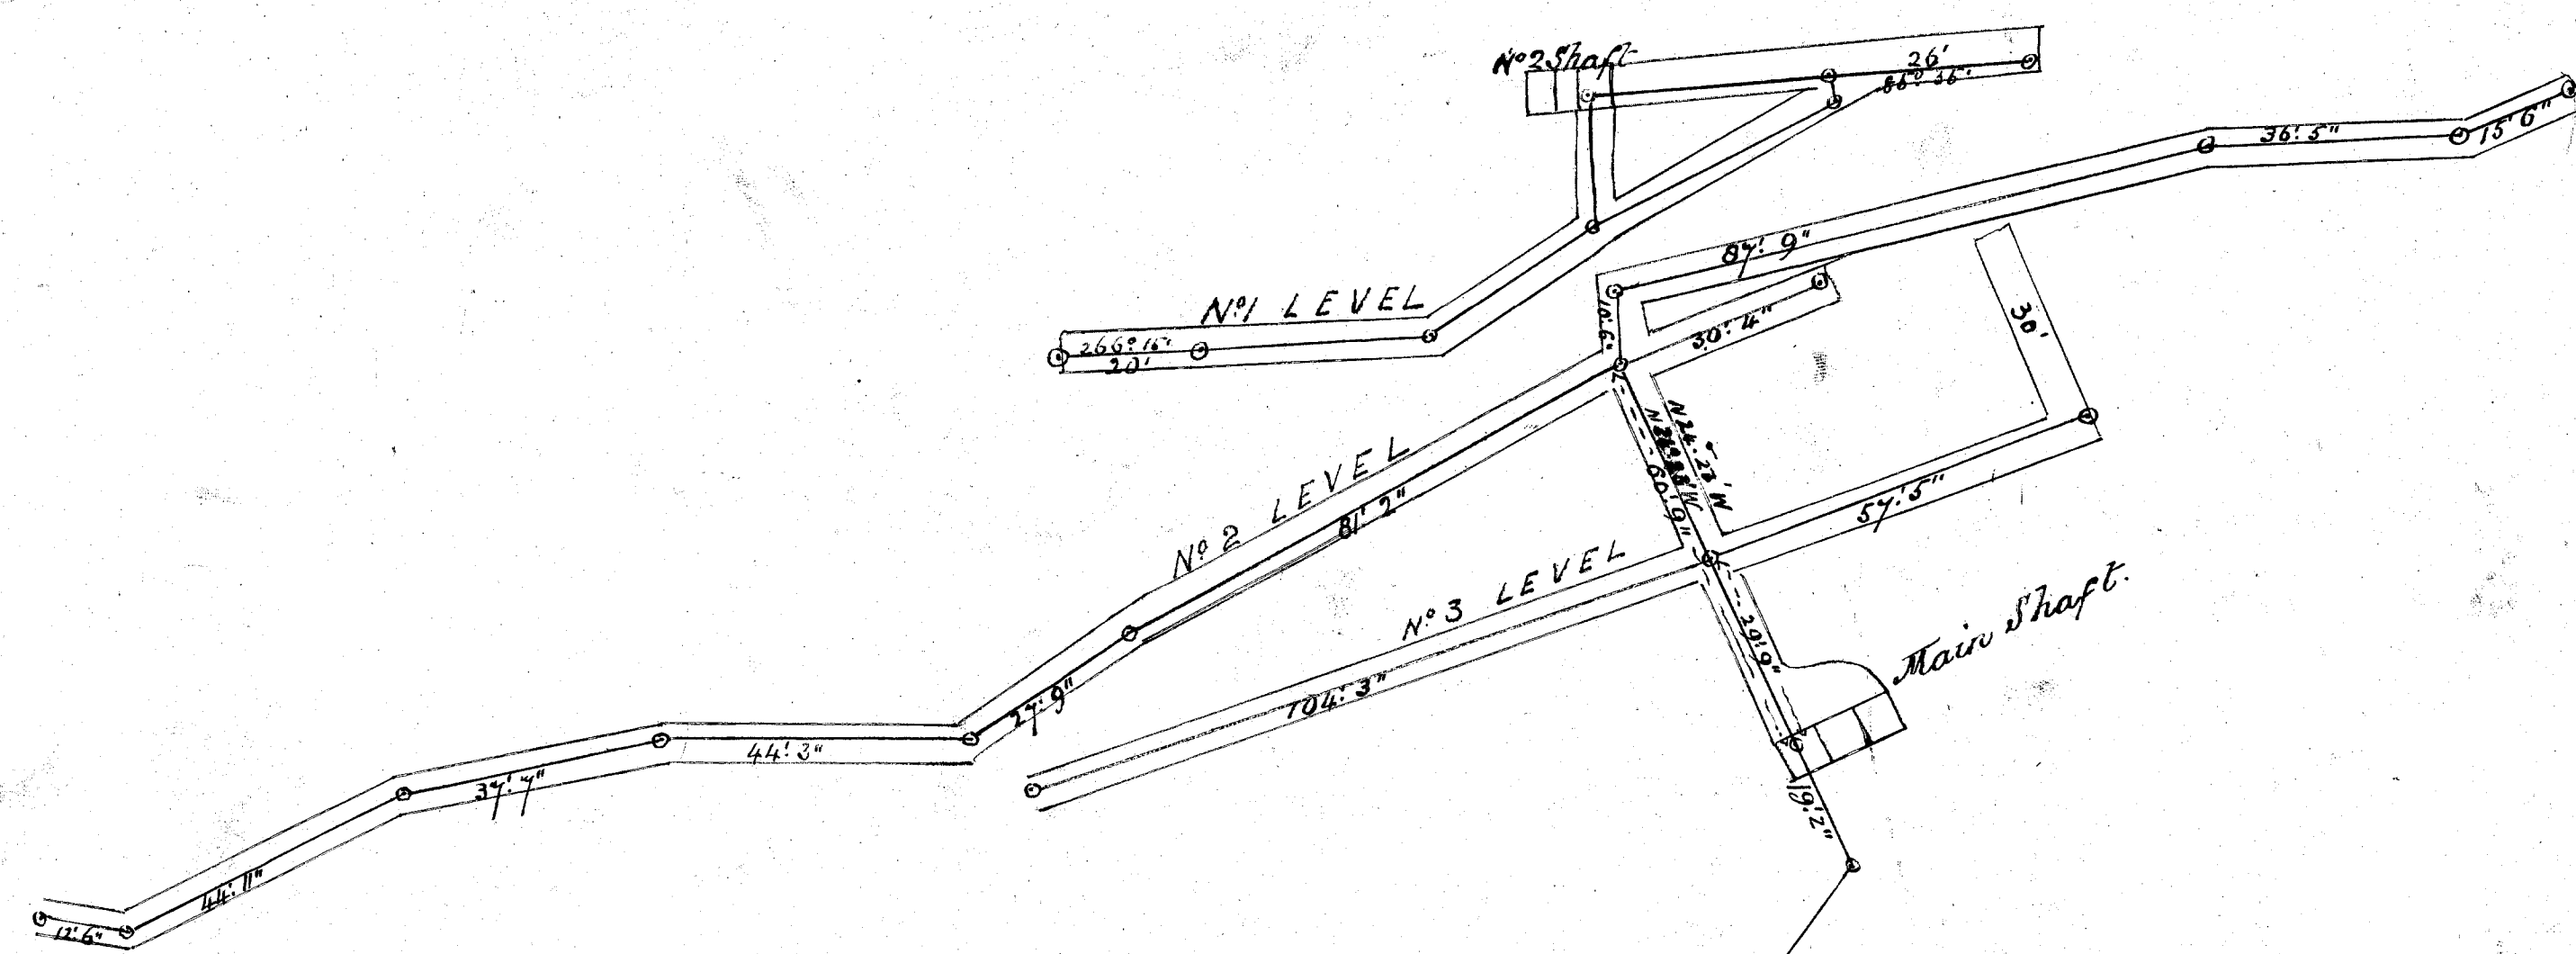


NORTH

510' 6" N 35° 37' E

5 cm

58

Cross Section.

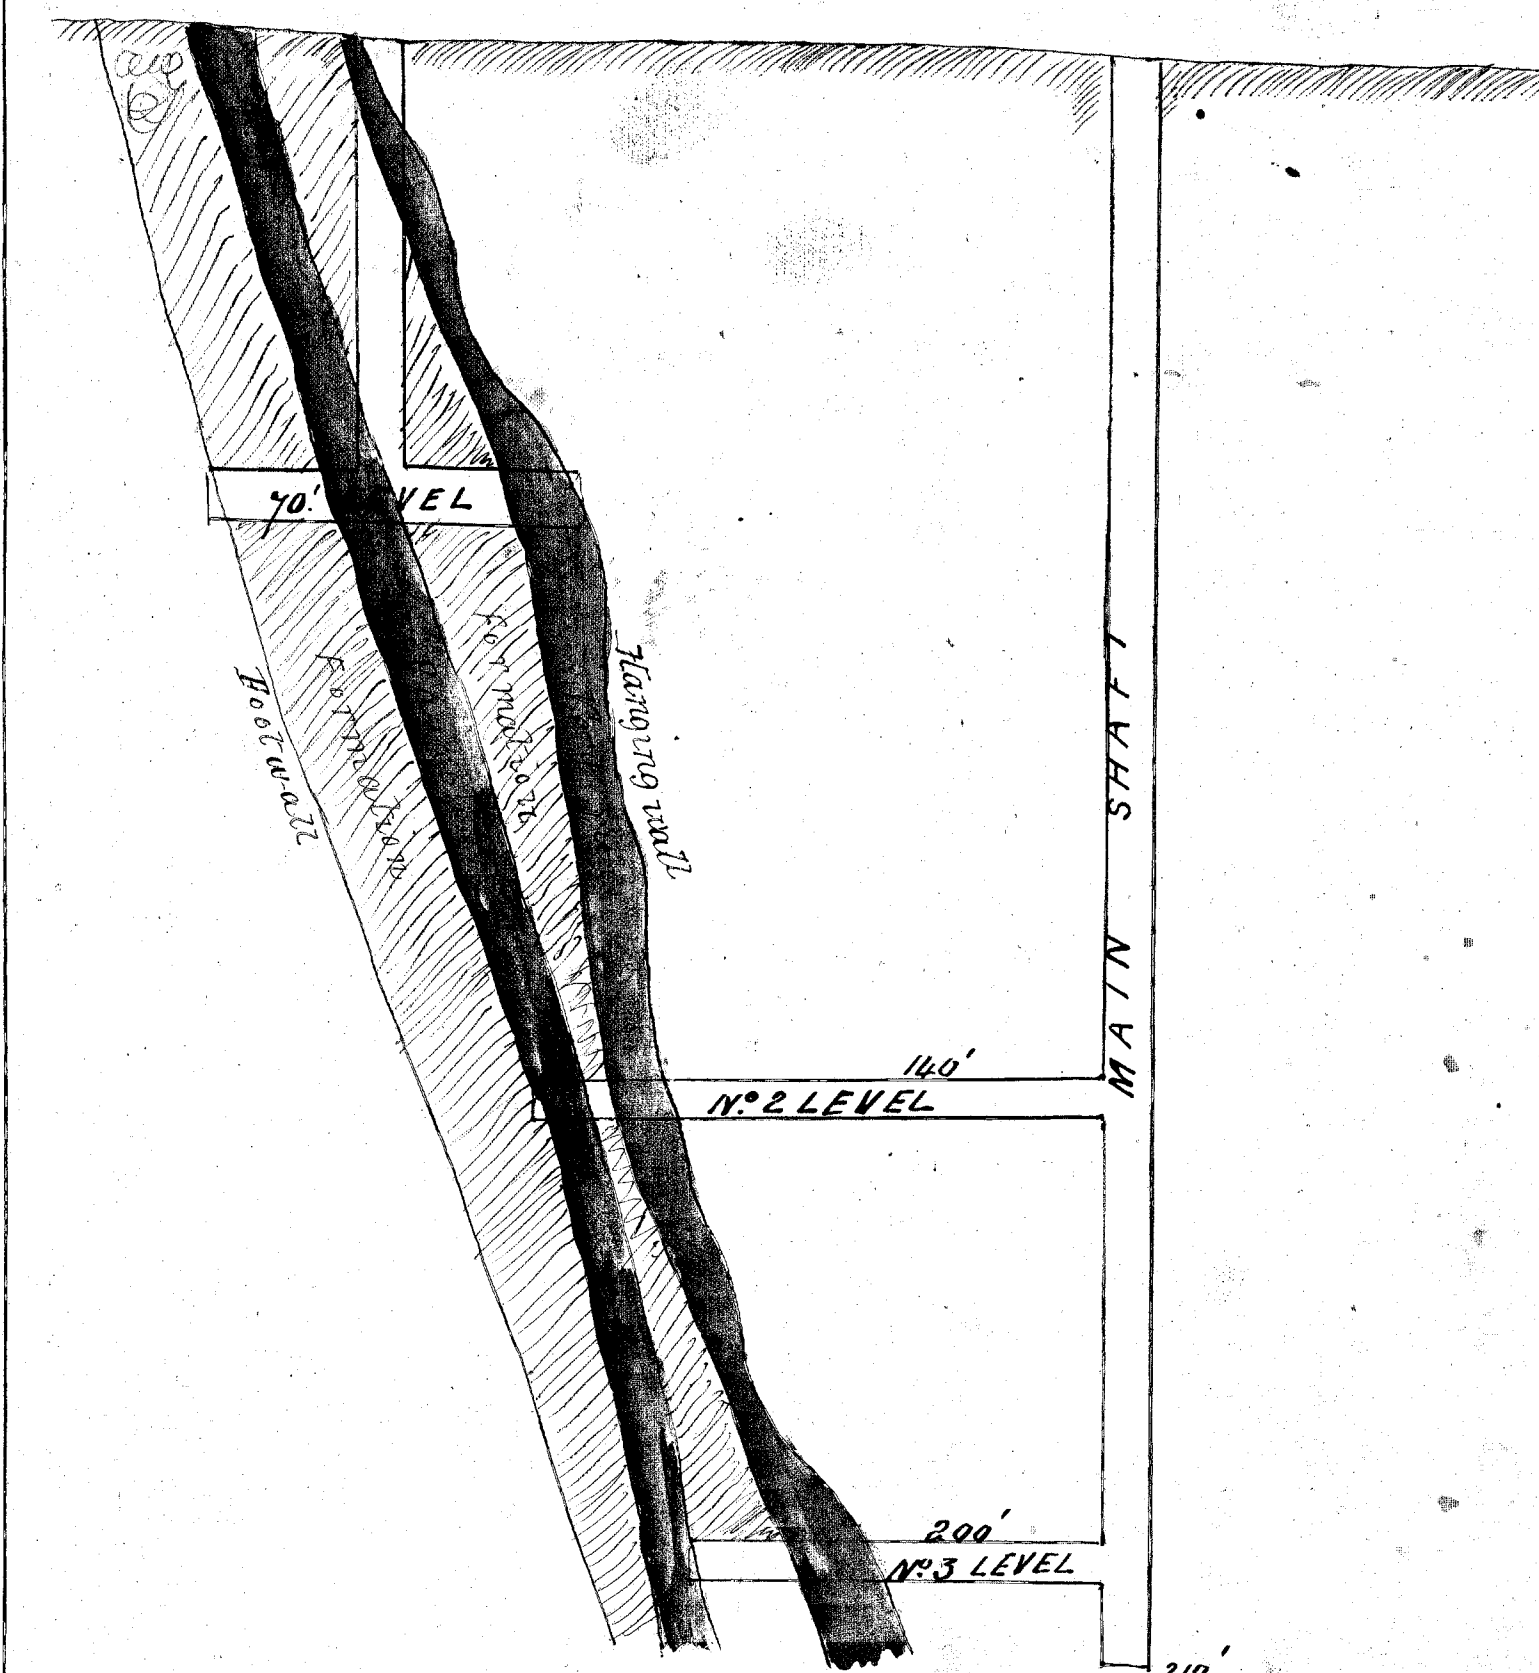

9th July
1895.

1885
This was one of a bundle of plans found in July 1885 behind a
post in the Registration of Mines Office, Lancaster: Personal
it had been sent in in 1882.
J. Montgomerie
Inspector of Mines
July 12th 1885

*Perkies correct copy of plan in
Managers office for year ending 1891*

2681 *Staph. musiv*