

5 cm

25
8281

Plan of Main Hinge and Western drive from bottom of Same
New Pinarore Gold Mining Company to L.A.


Scale 25 ft to an inch

Instrument used - Transit theodolite

J. L. Tills

Gen. Mgr. Manager

30/1/98

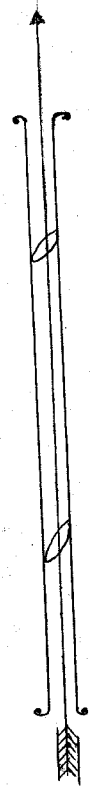

58 New Pinarore 1828