


NEW PINAFORE G.M.

Scale 25 Feet to an Inch



*Solely by
1/12/14
+ 22/1/14*

Drives shown by blue lines are copied from Mining Manager's Plan of the Mine as they are now inaccessible for survey. Survey made with a 5" Y Theodolite + 1/2" steel band. All measurements of this survey in links & decimals.

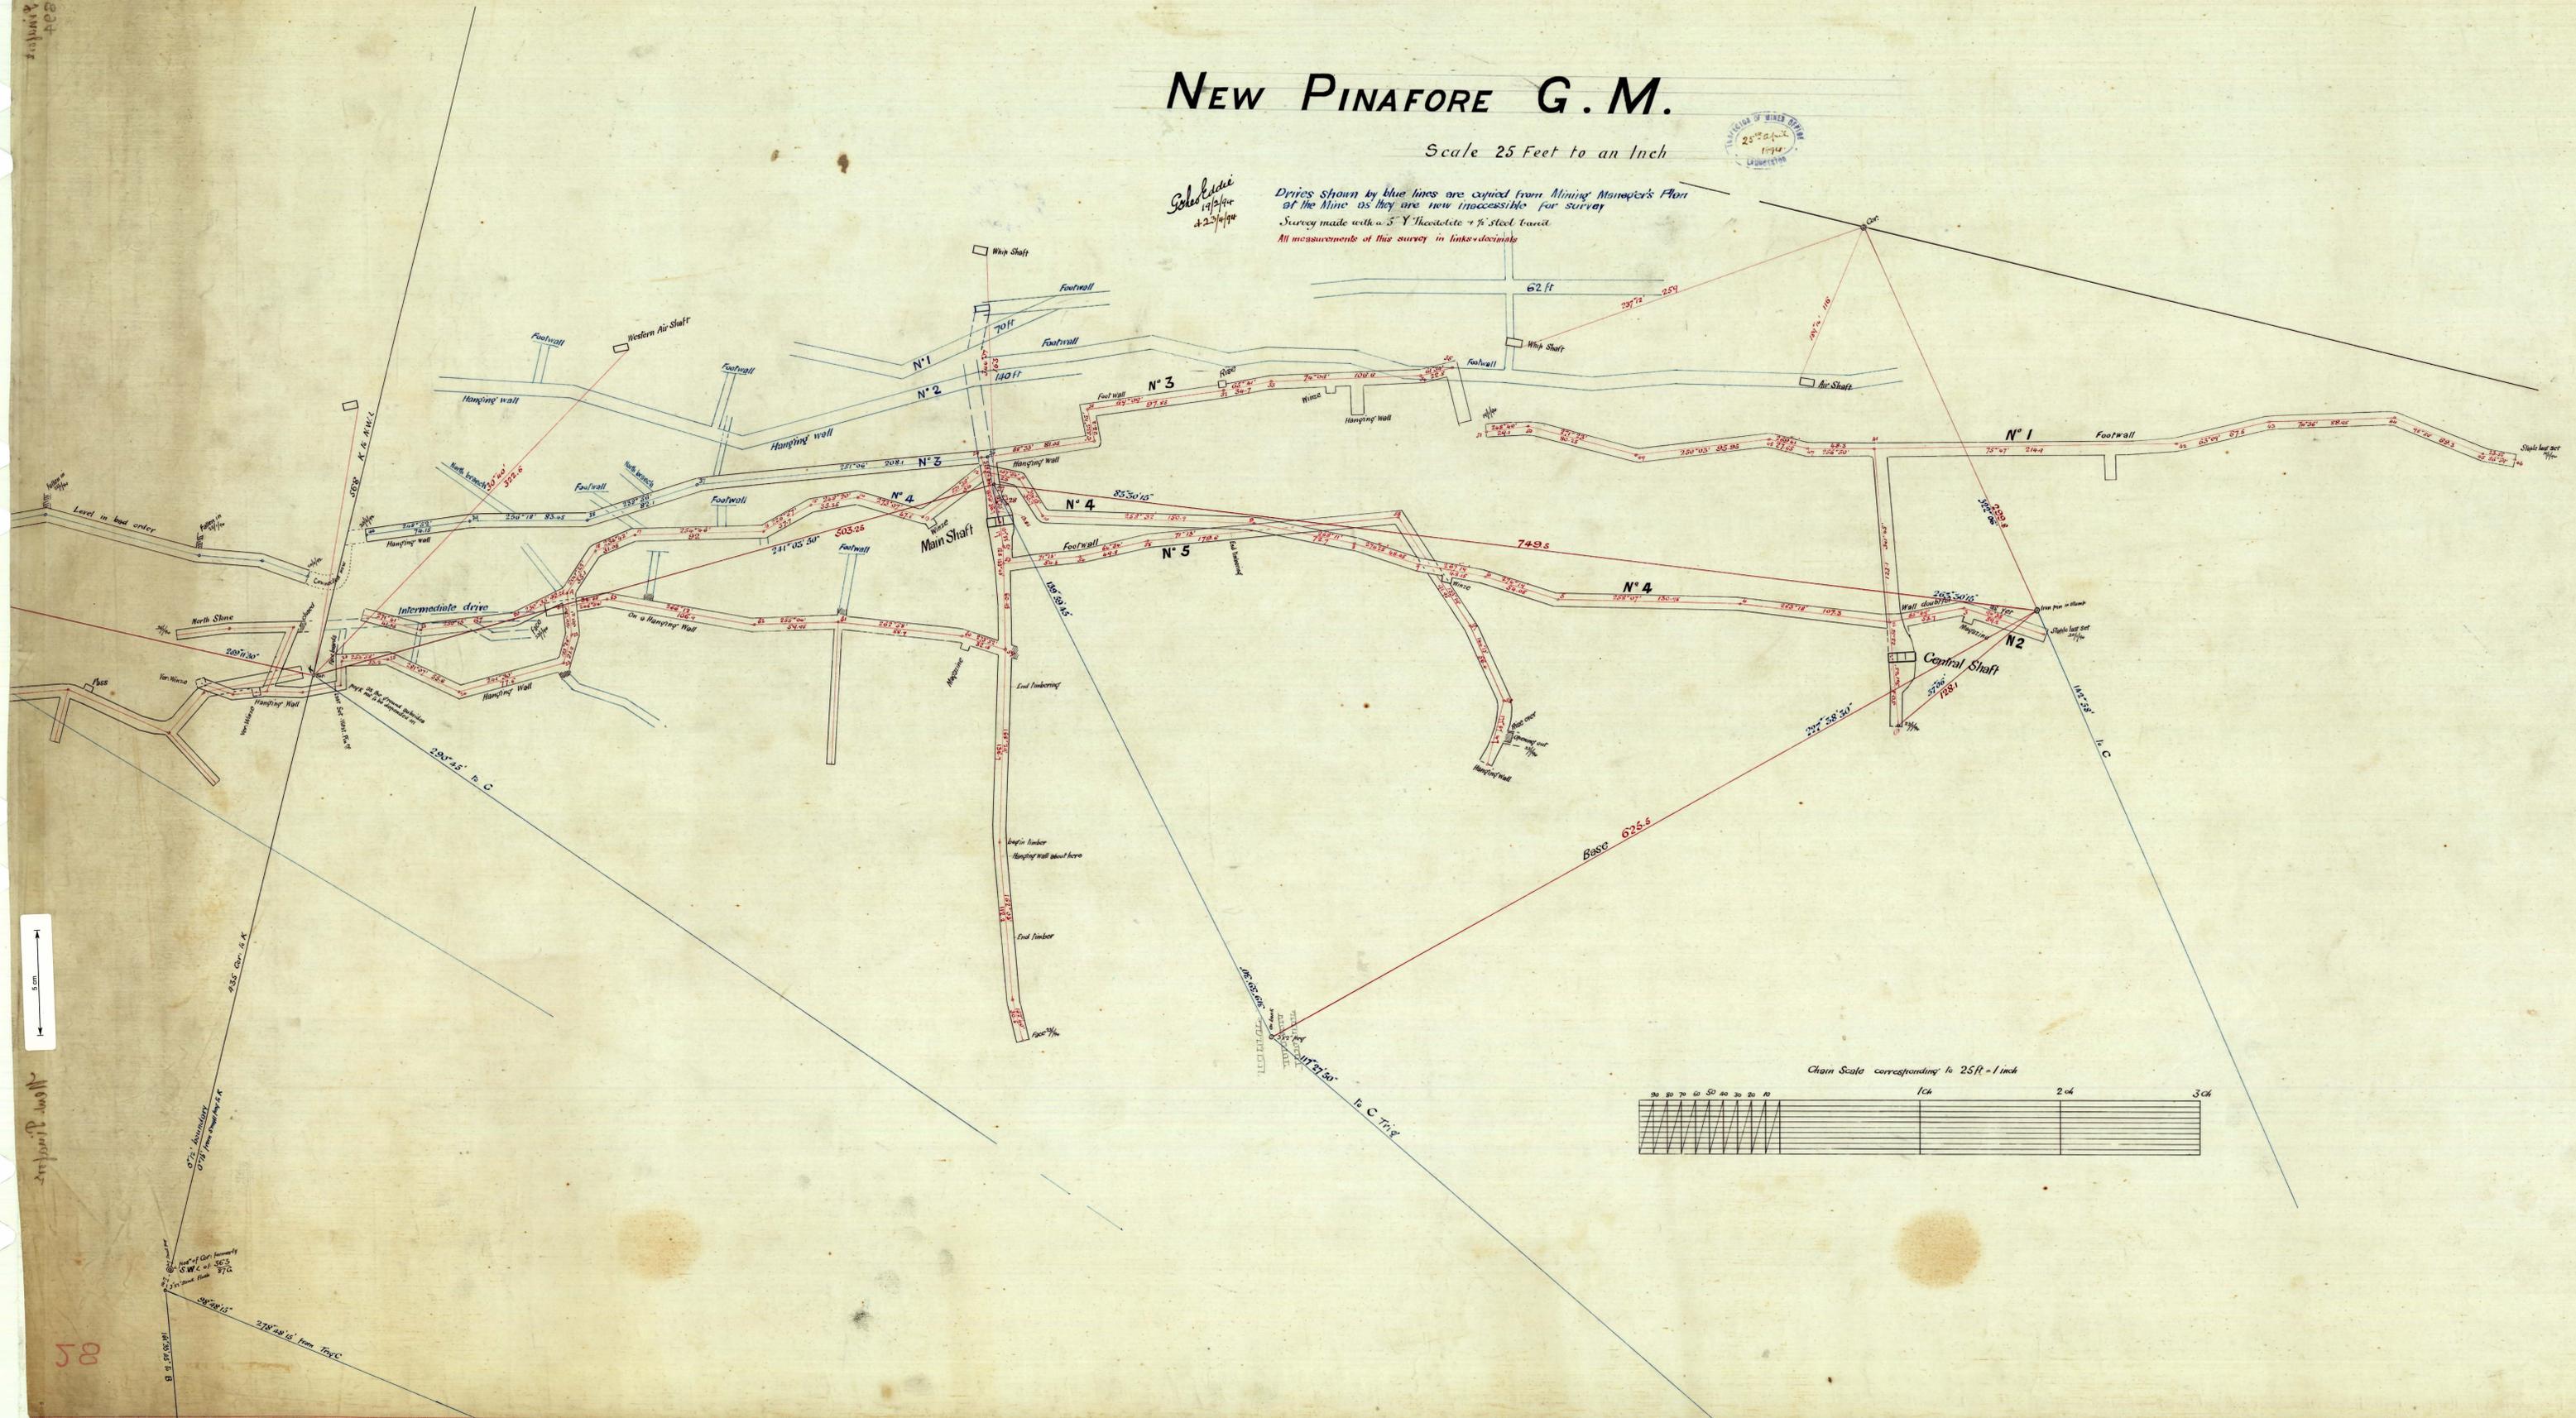

82
1834
Spec. & working

314
12



Non-Pinapore

58