



58

1833

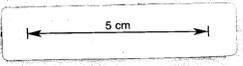

214
25

58

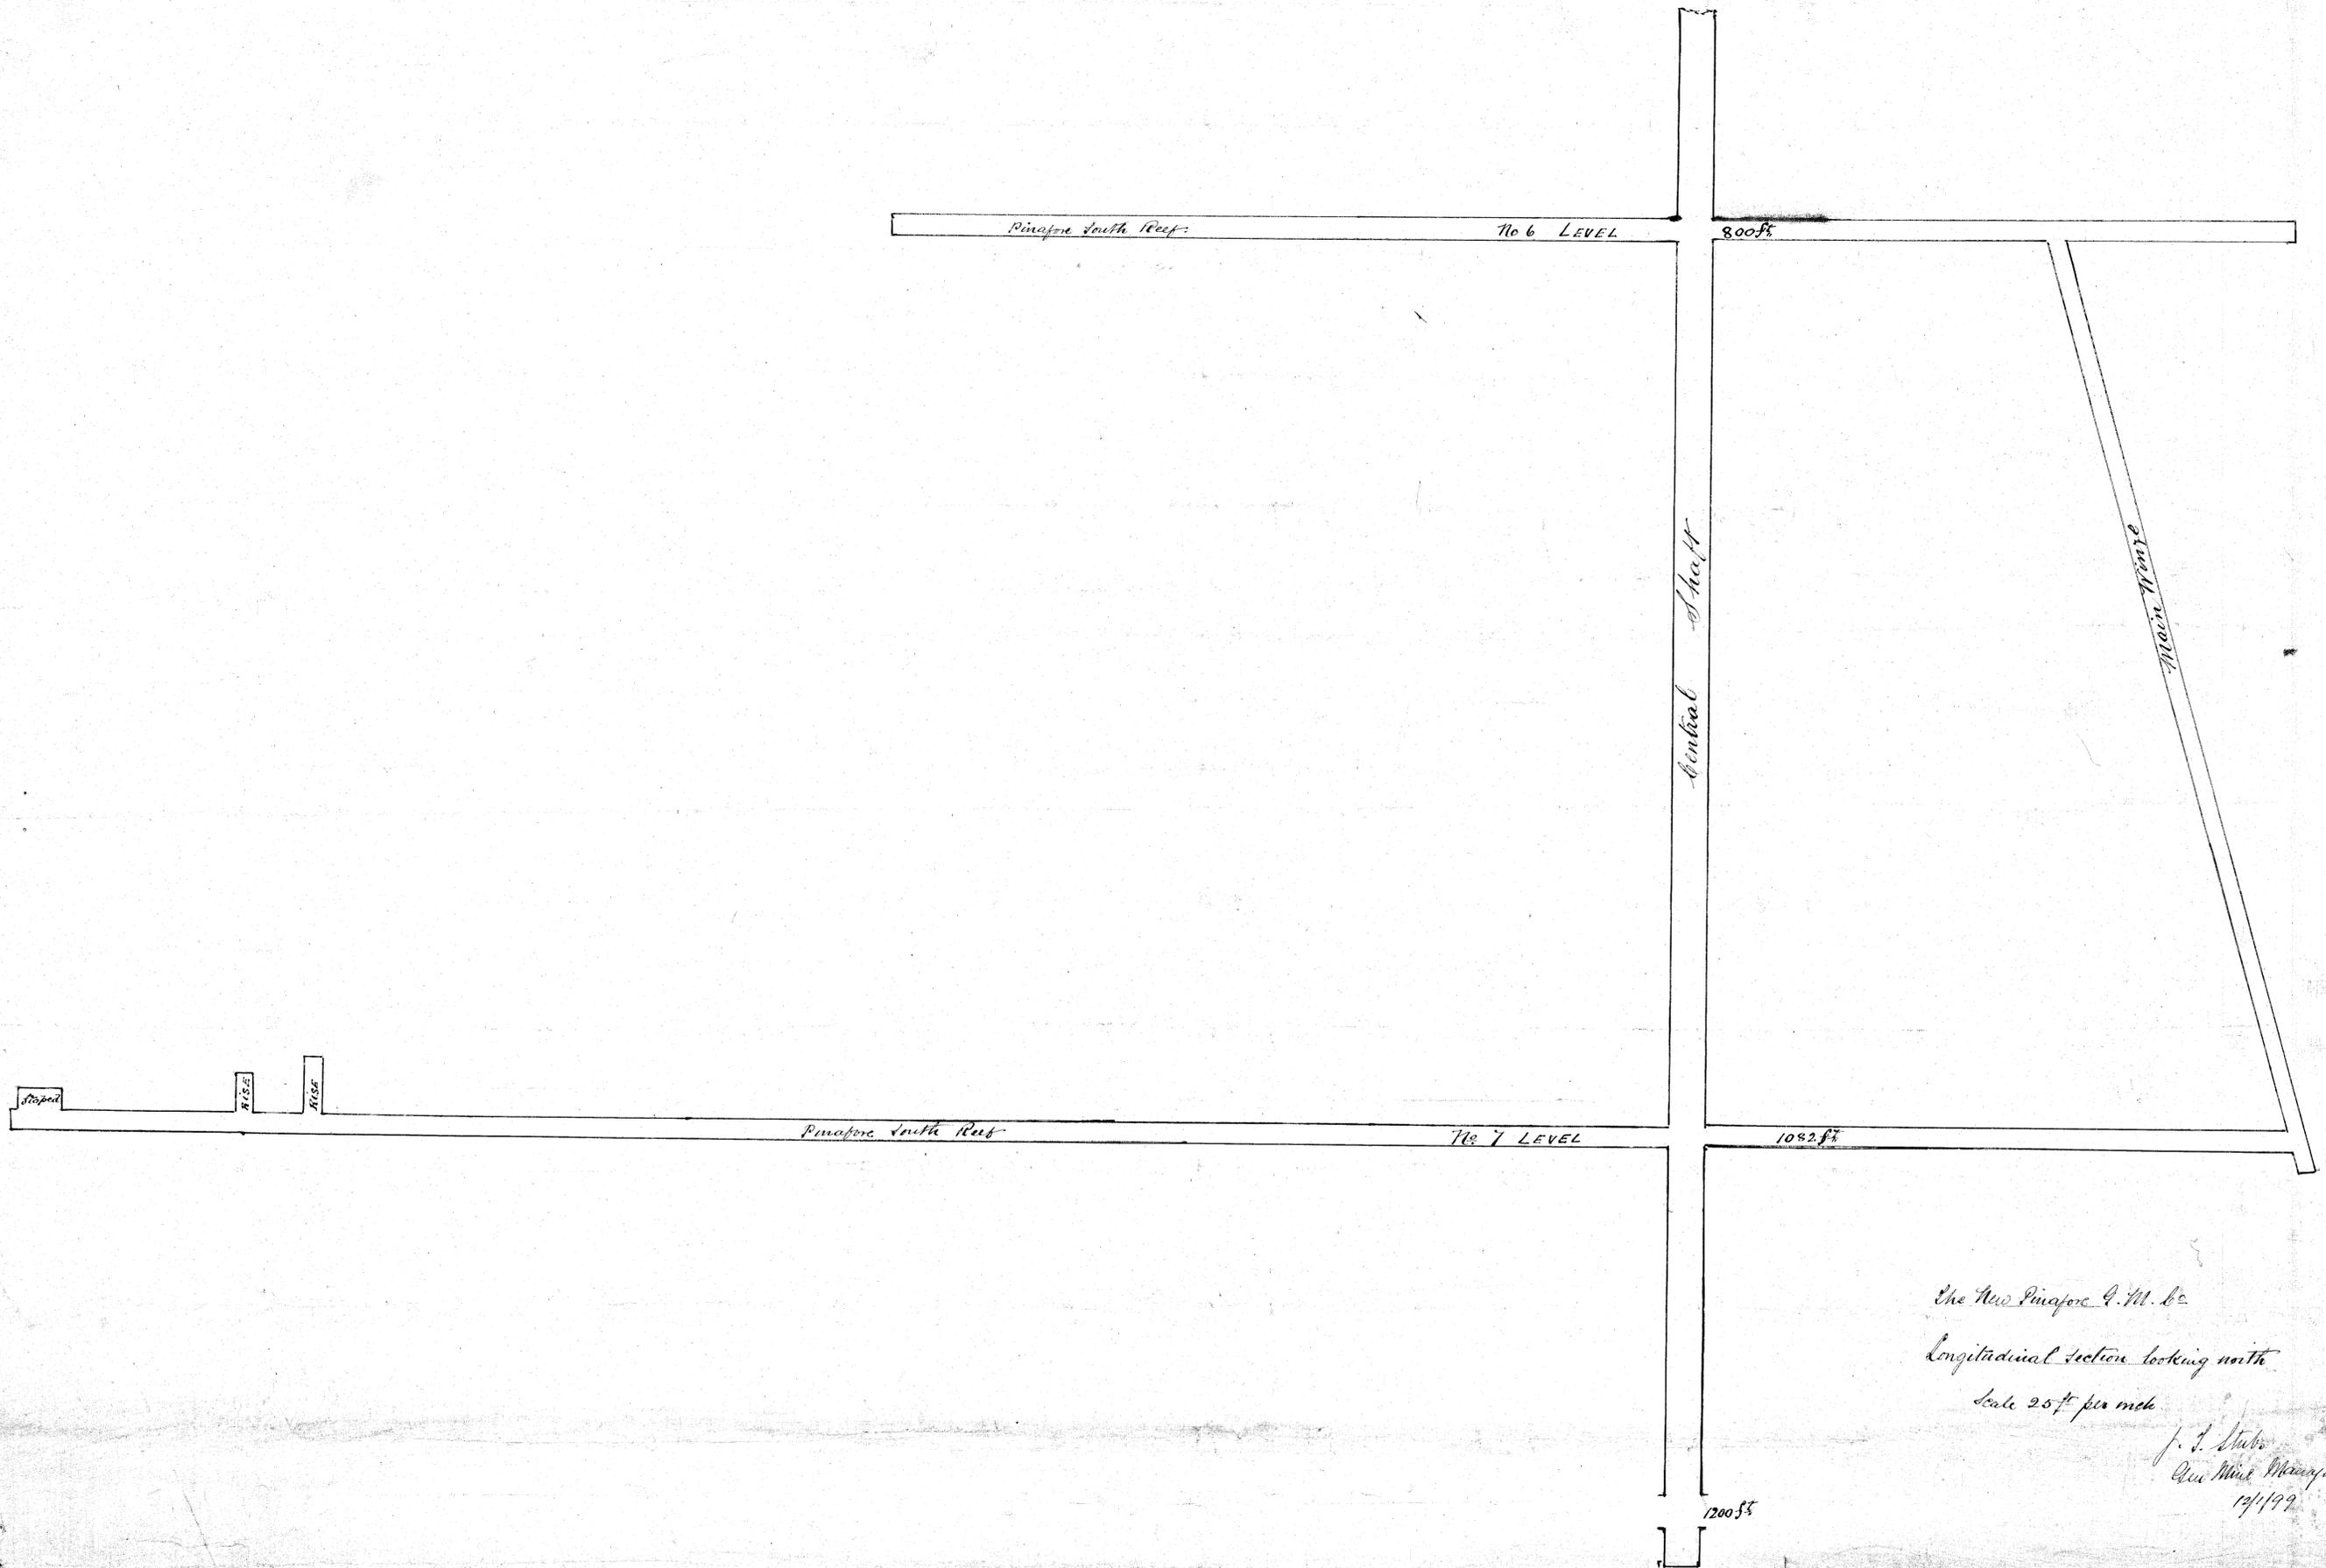

The New Singapore G. M. Co.
 Longitudinal section looking north
 Scale 25 ft per inch

J. J. Stubbs
 Que Min Manager
 19/1/99

1833

58