


5 cm

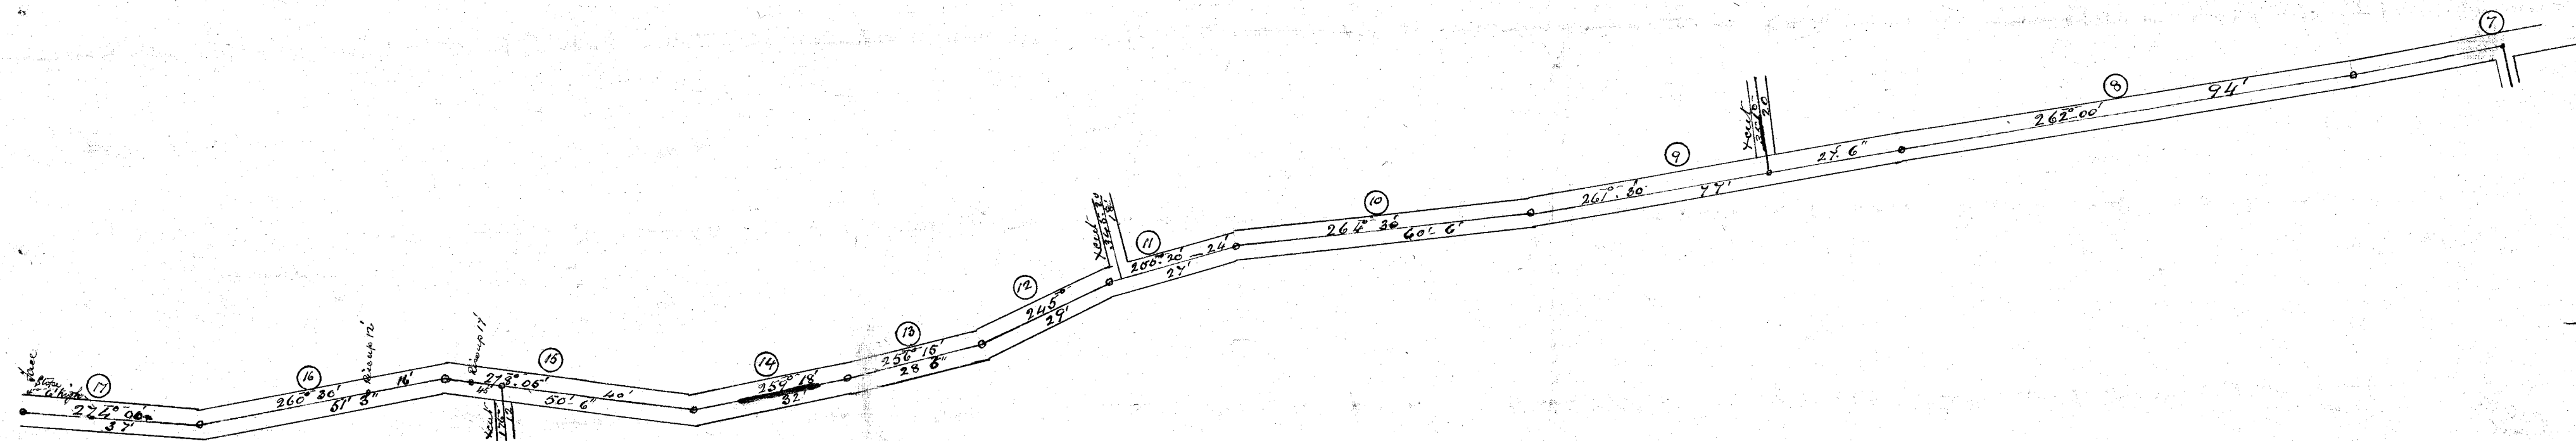

The New Pinapore G. M. to the Reef

Le Roy

Scale 25 feet to an inch

Pinapore South Reef

Levens of the 7. level, Continued from Station 8 (given 1898) Instrument Transit theodolite

J. S. T. L.

Gen. M. M. Manager

12/1/99