


50

NEW PINAFORE G.M.C^o NO L^{IA}

*Longitudinal Section
Western Block*

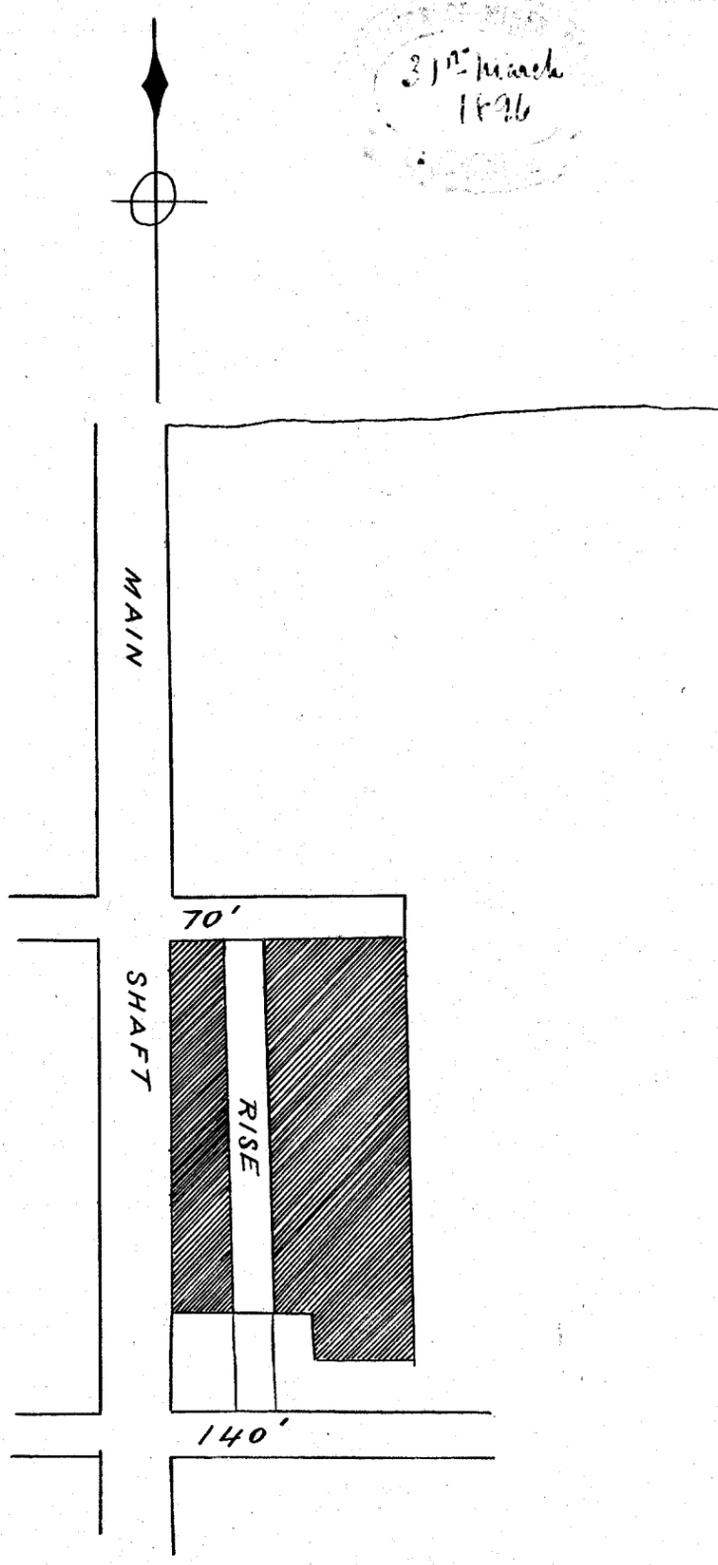

31st March
1896

*H. F. Miles
Authorized Surveyor
April
January '96.*

58